

ELDORADO C.M.

F. H. Wise



Scale 25 ft to an inch.

196-01

10-961

T. H. Cundy

F. M. Clark

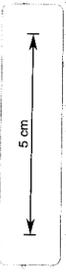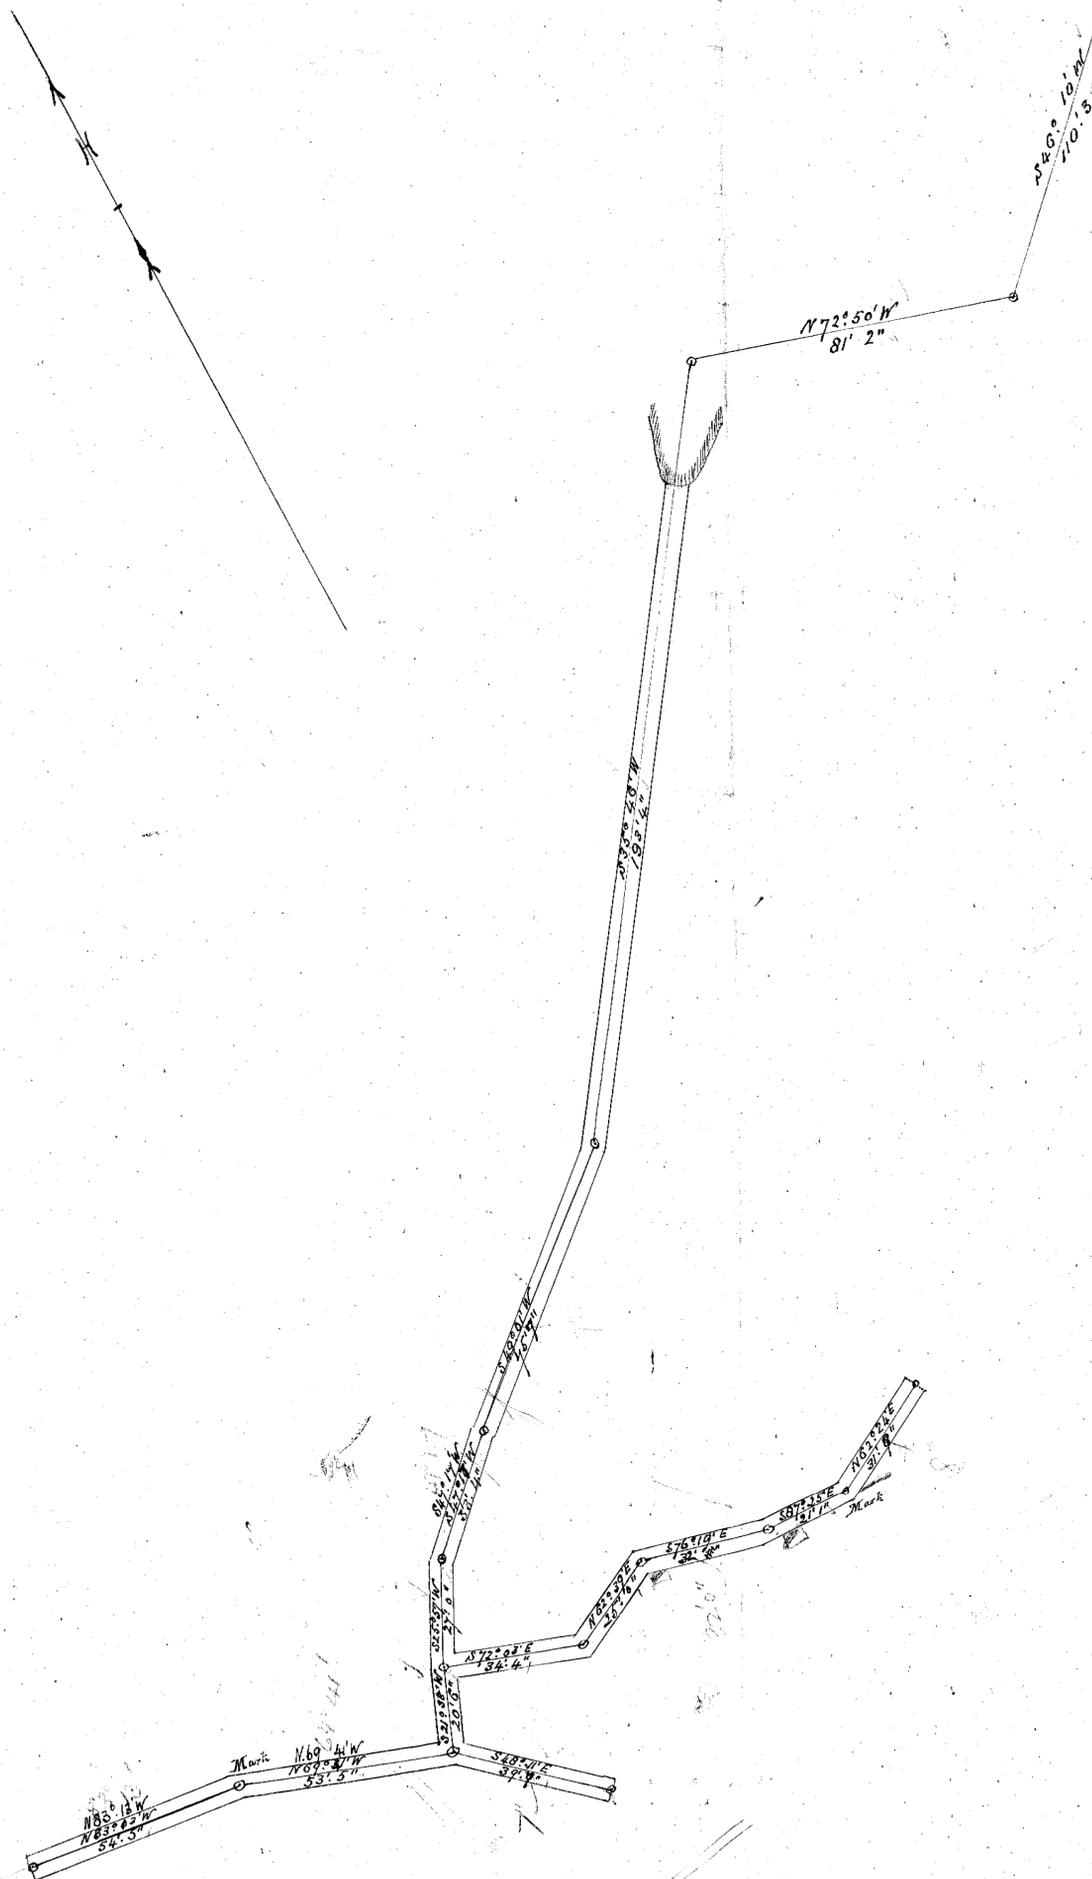

Certified correct copy of ground plan of the
 above mine as far as can be obtained to
 end of year 1890.

C. Brighly Watchorn
 Mining & Land Surveyor
 R. P. Act.