


5 cm

ELDORADO G.M. 196-02
 LONGITUDINAL & CROSS SECTIONS
 Scale 25 ft to an inch.

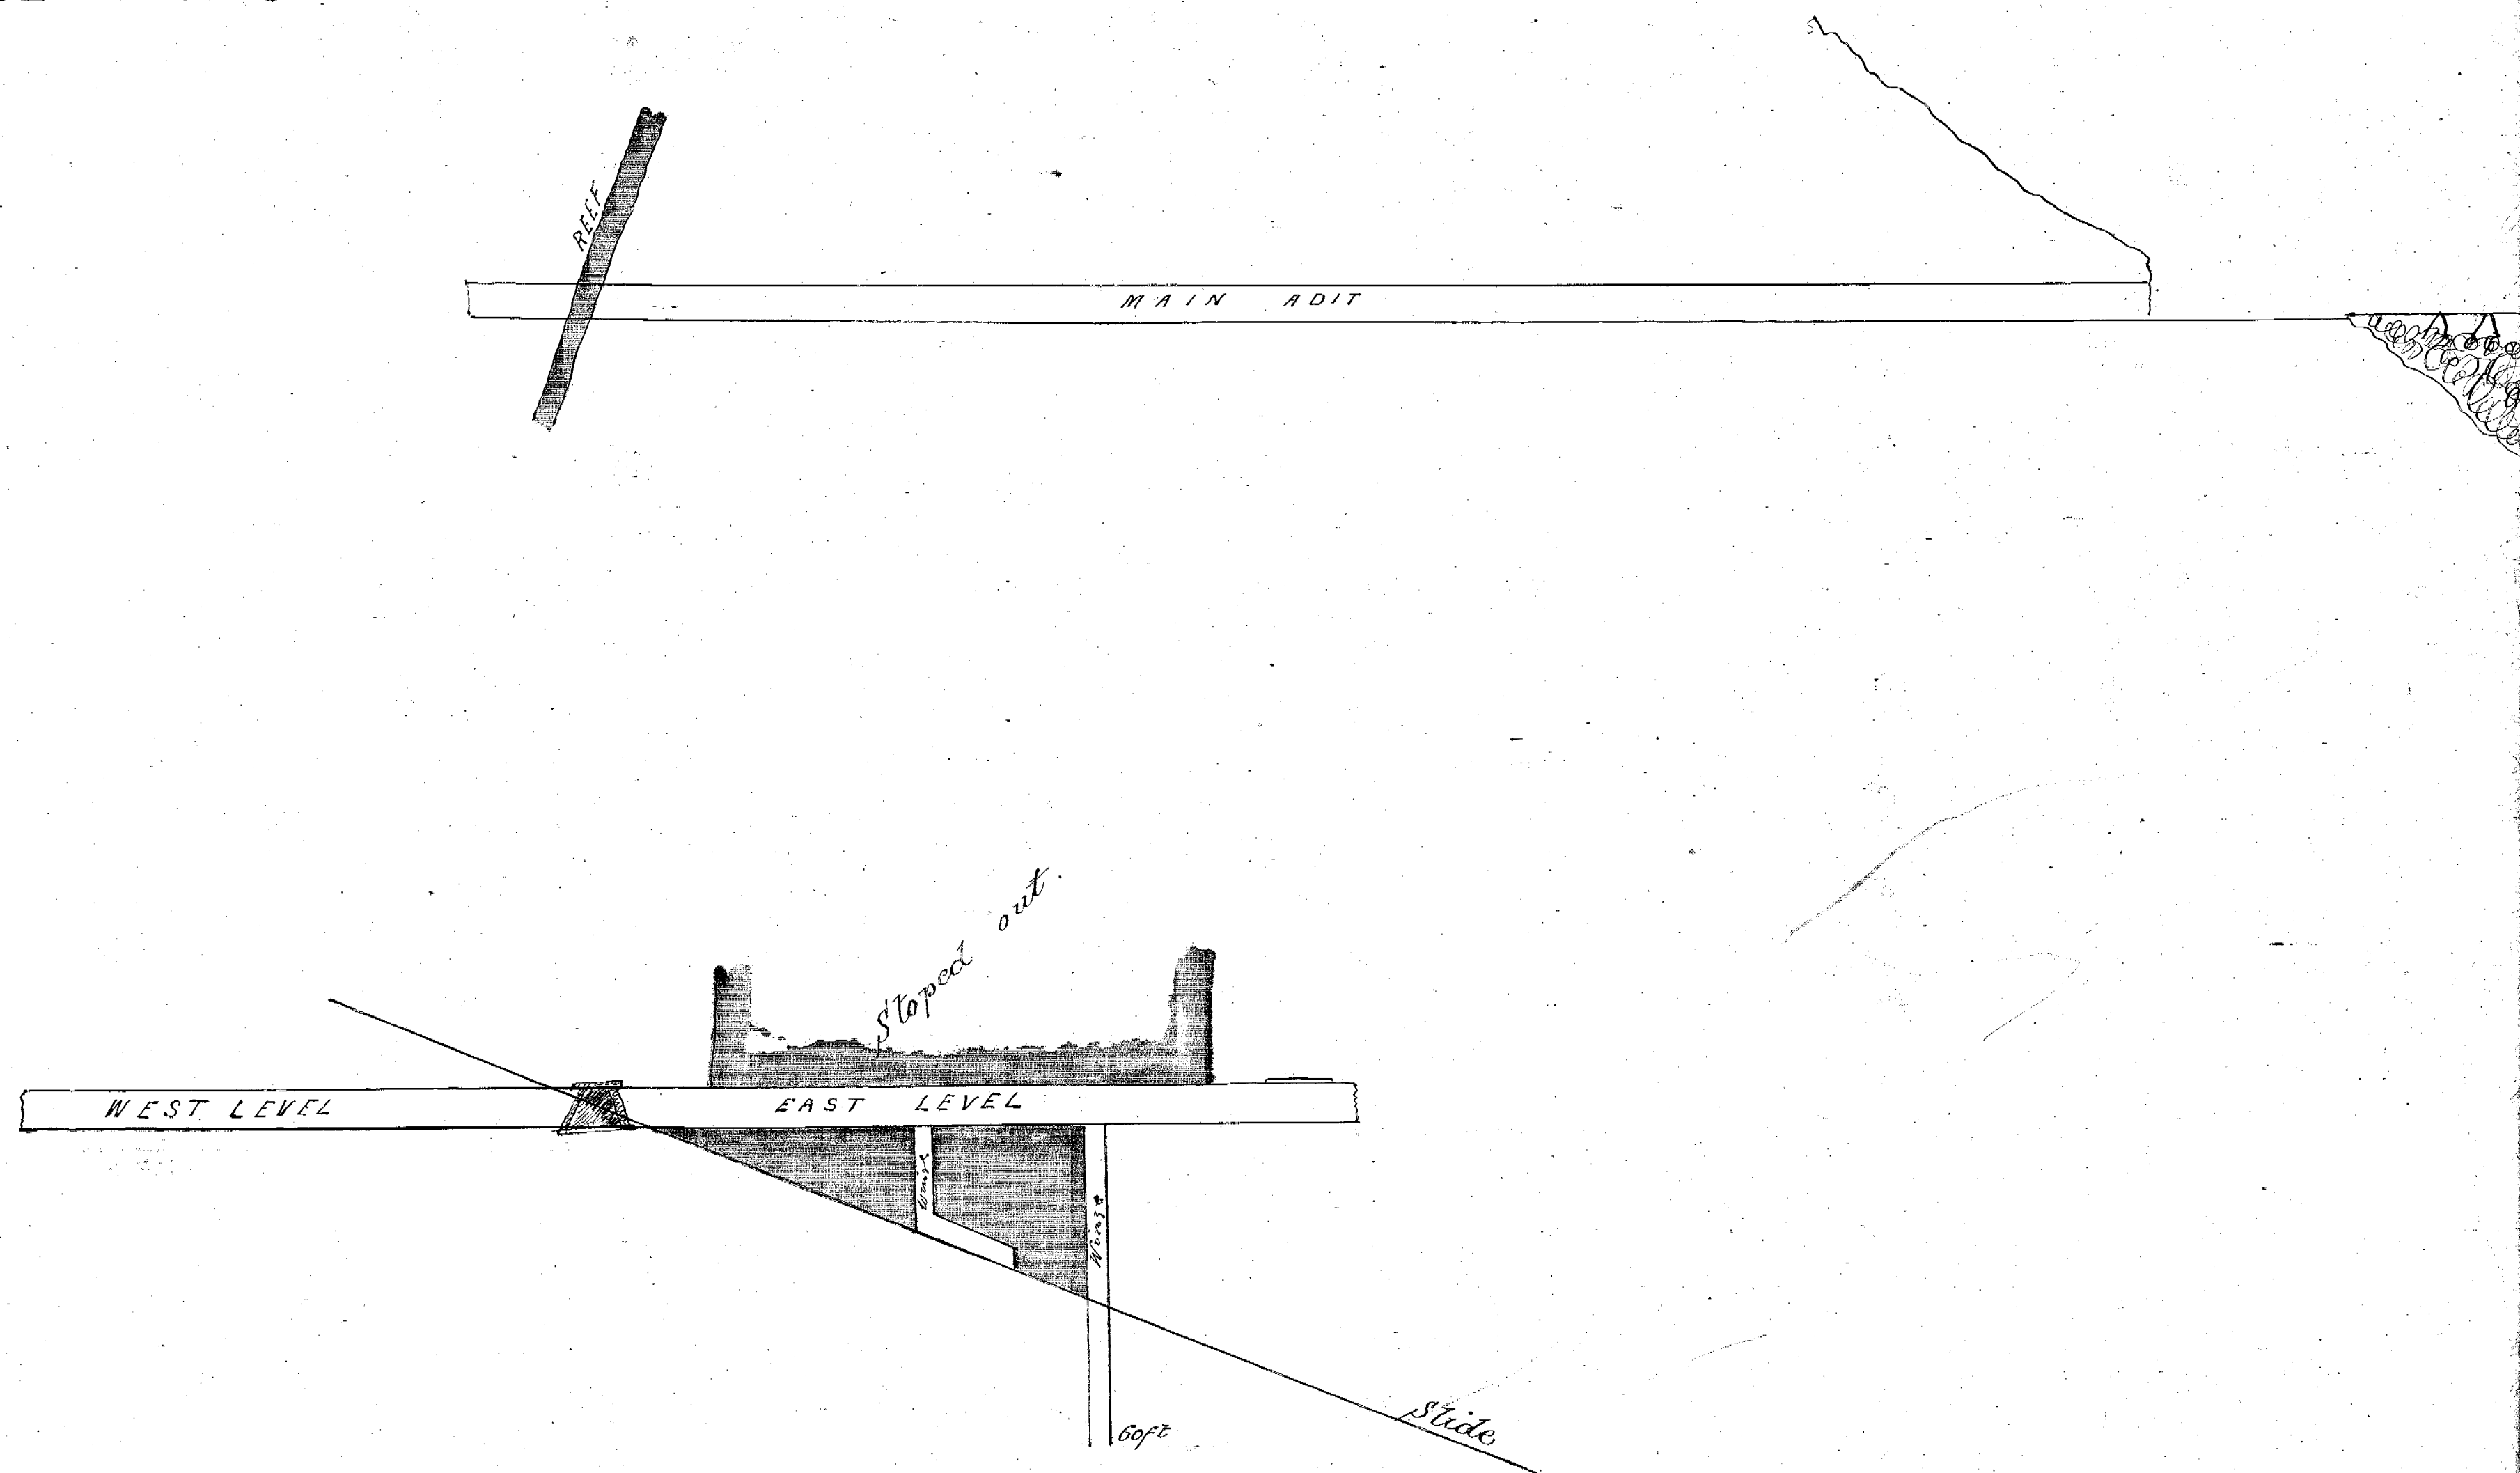

Corrected sketch copy of plan as
 far as can be obtained of the
 underground workings of above mine
 to end of year 1891

E. B. Wright, Watchman
 Mining & Land Survey
 R. P. Lee