

5 cm



197-01

197-01

Plan.
Old Monkland, G. M. Co.

Longitudinal Section.

Transverse Section.

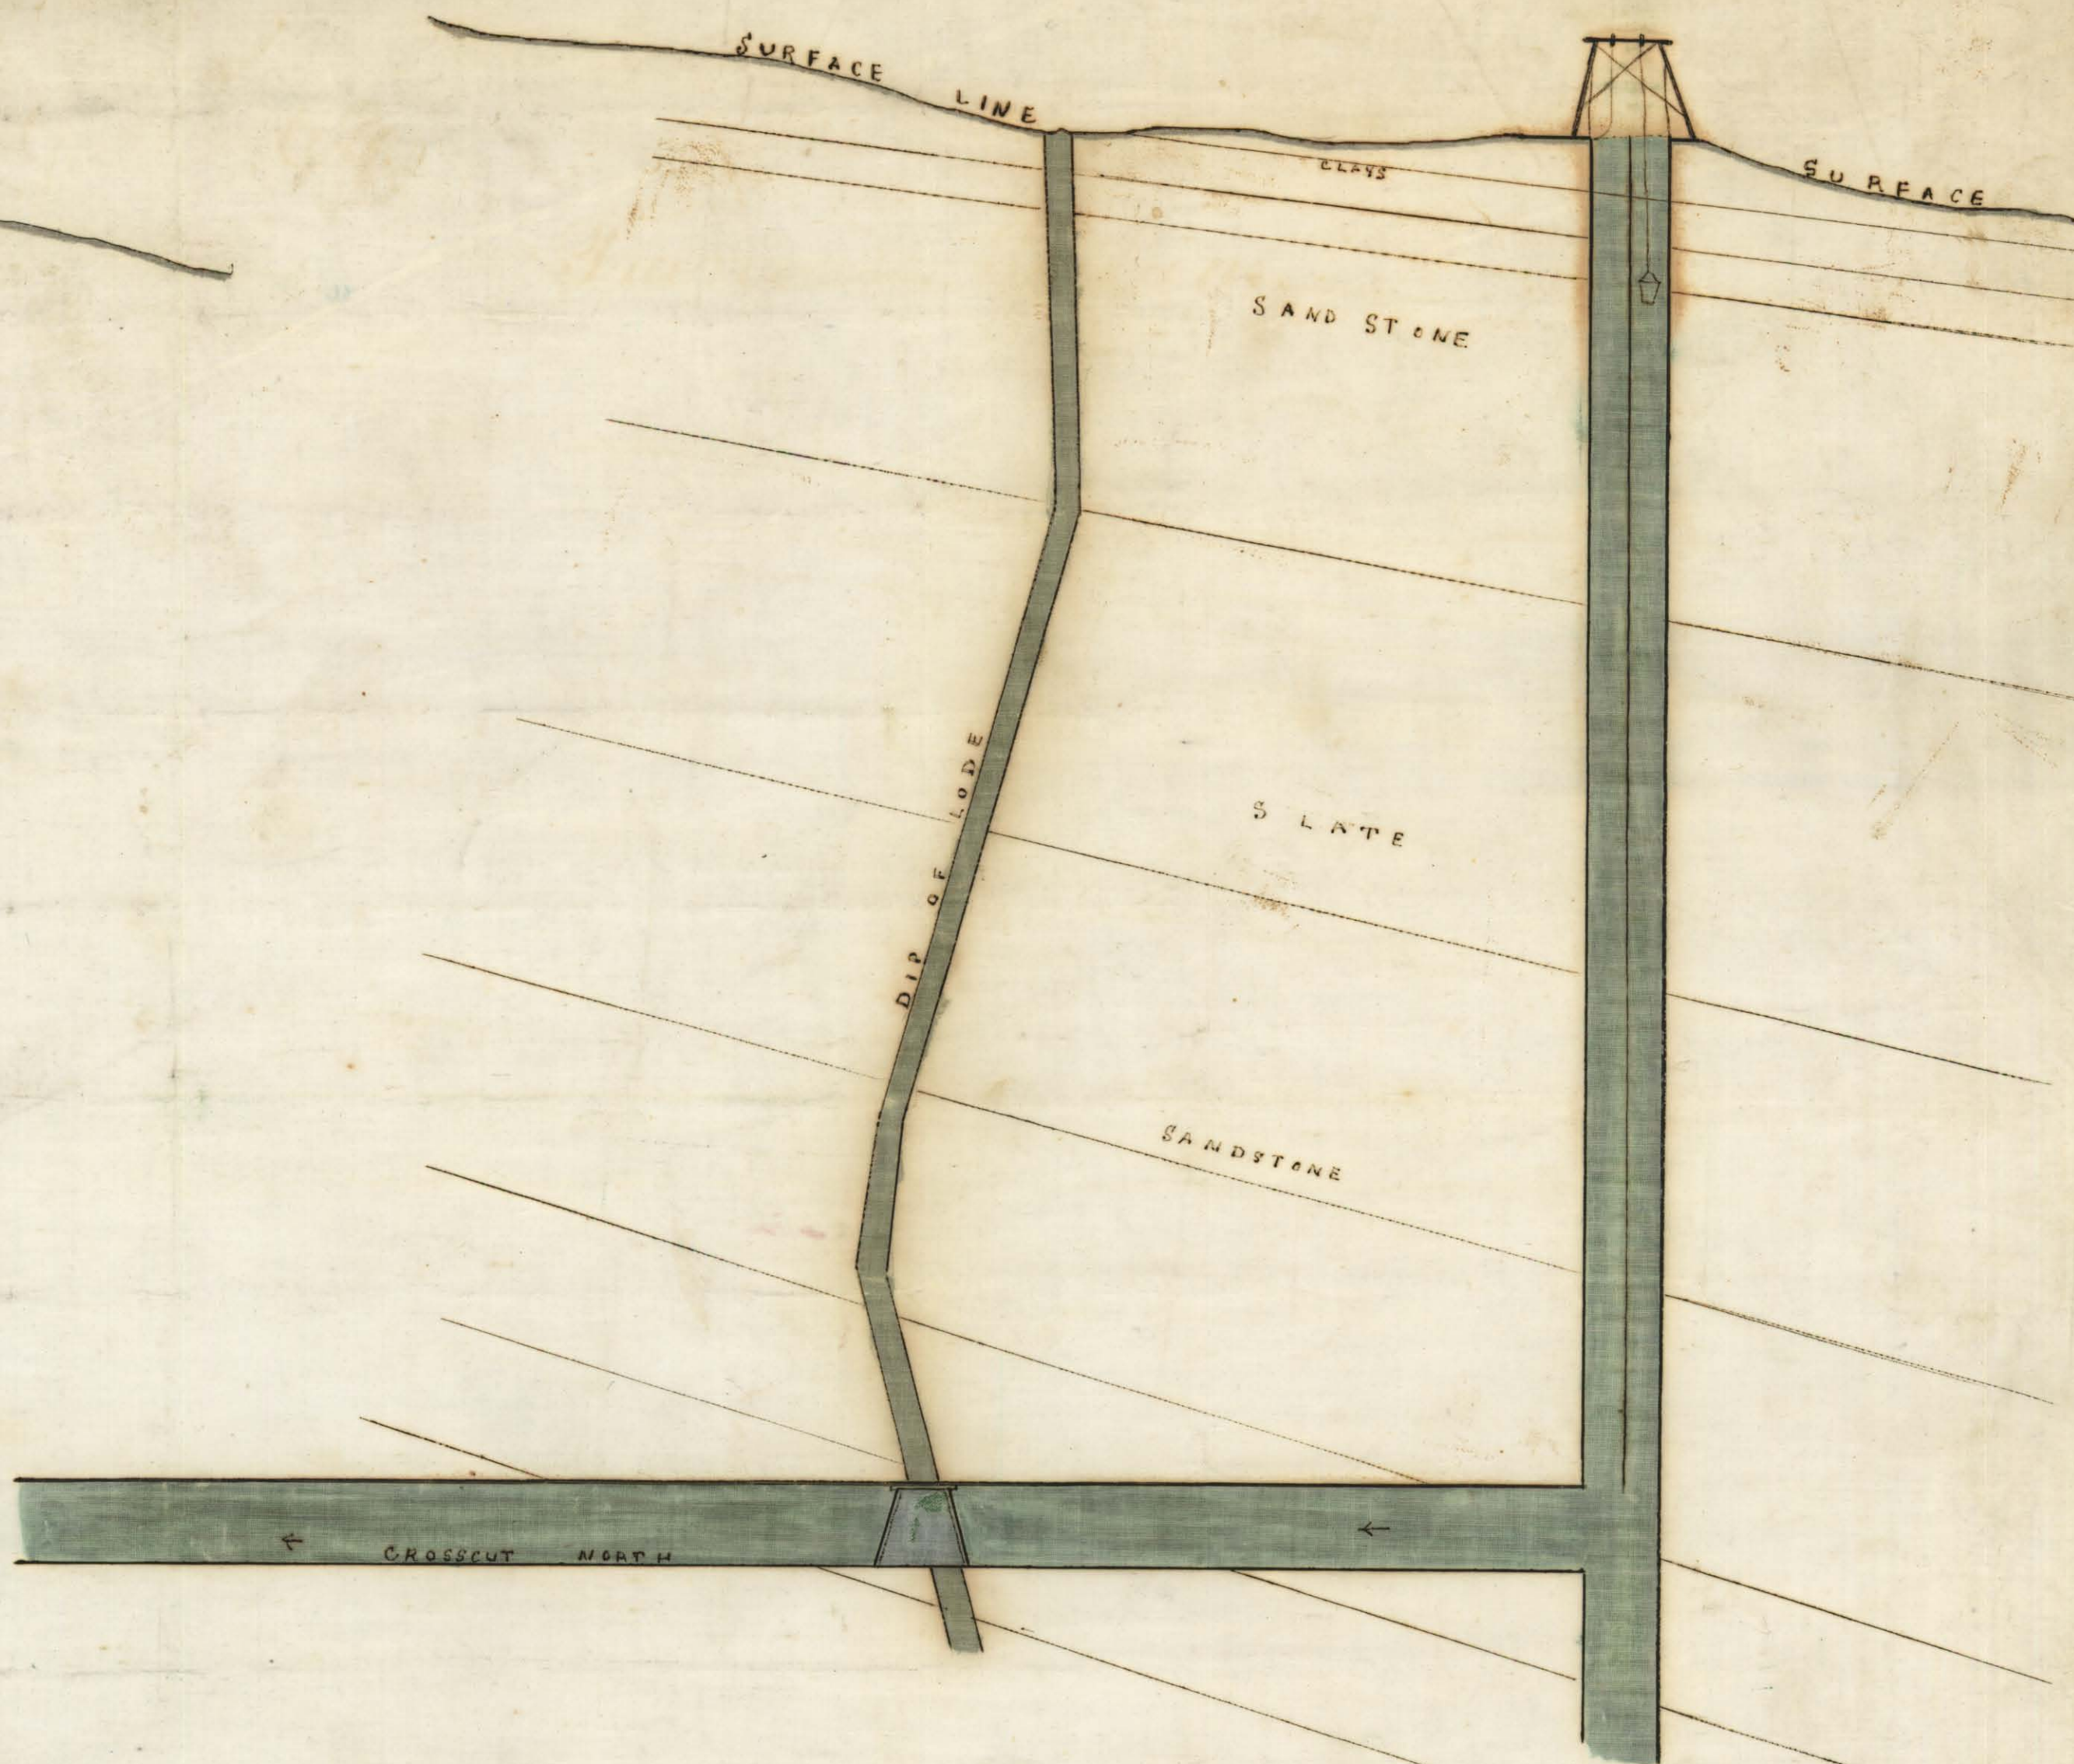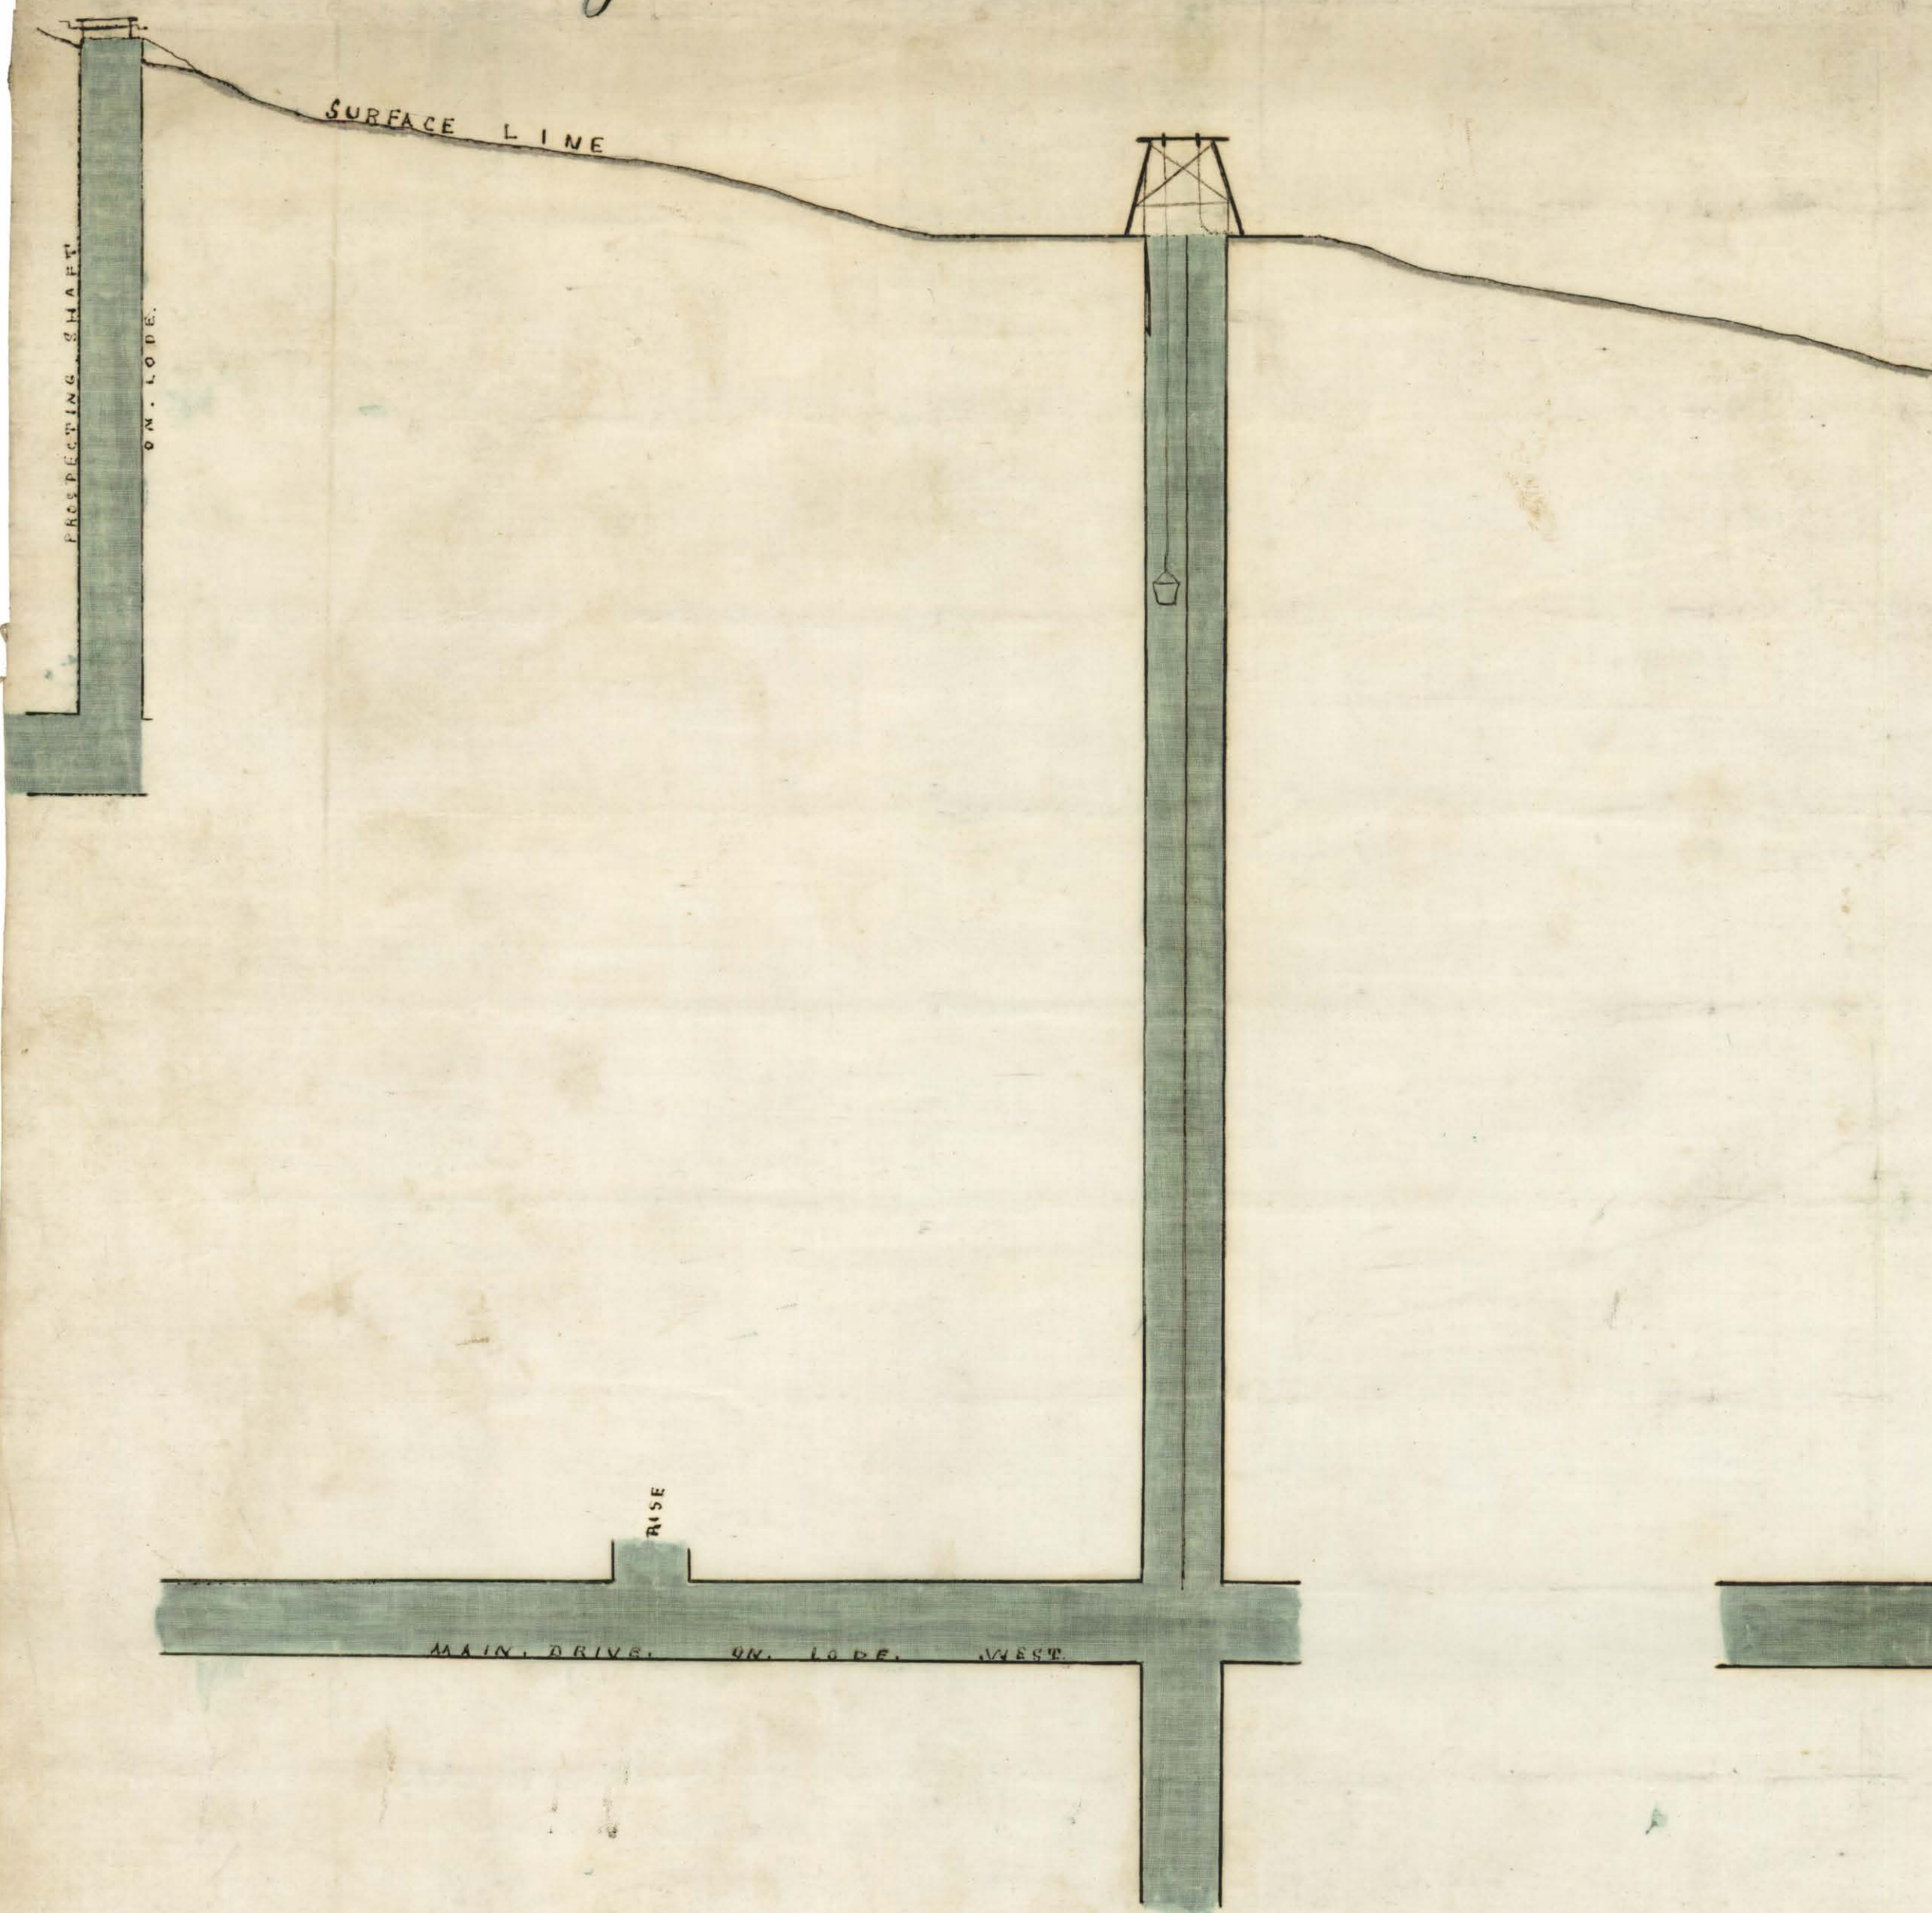

Scale 10ft. to One Inch.

Old Monkland G.M.C.

20