

# COUNTY OF DORSET

## VICINITY OF BELL HILL


Scale 10 chains to an inch.

197  
3

**REFERENCE**

2315 2 heads and 30 ac dam site  
221 20  
W 3056 C shift of intake 2021 to intake of 2315  
2057 3  
224 253  
205 7  
All incorporated in 3113 All Parts Tin Mines Lease  
W (2) BRISSETS CONSOLIDATED NO LIA.

DRAWN IN OFFICE - copied from working plan  
See 224 for survey of W.R. & Dam  
22  
7/1/36

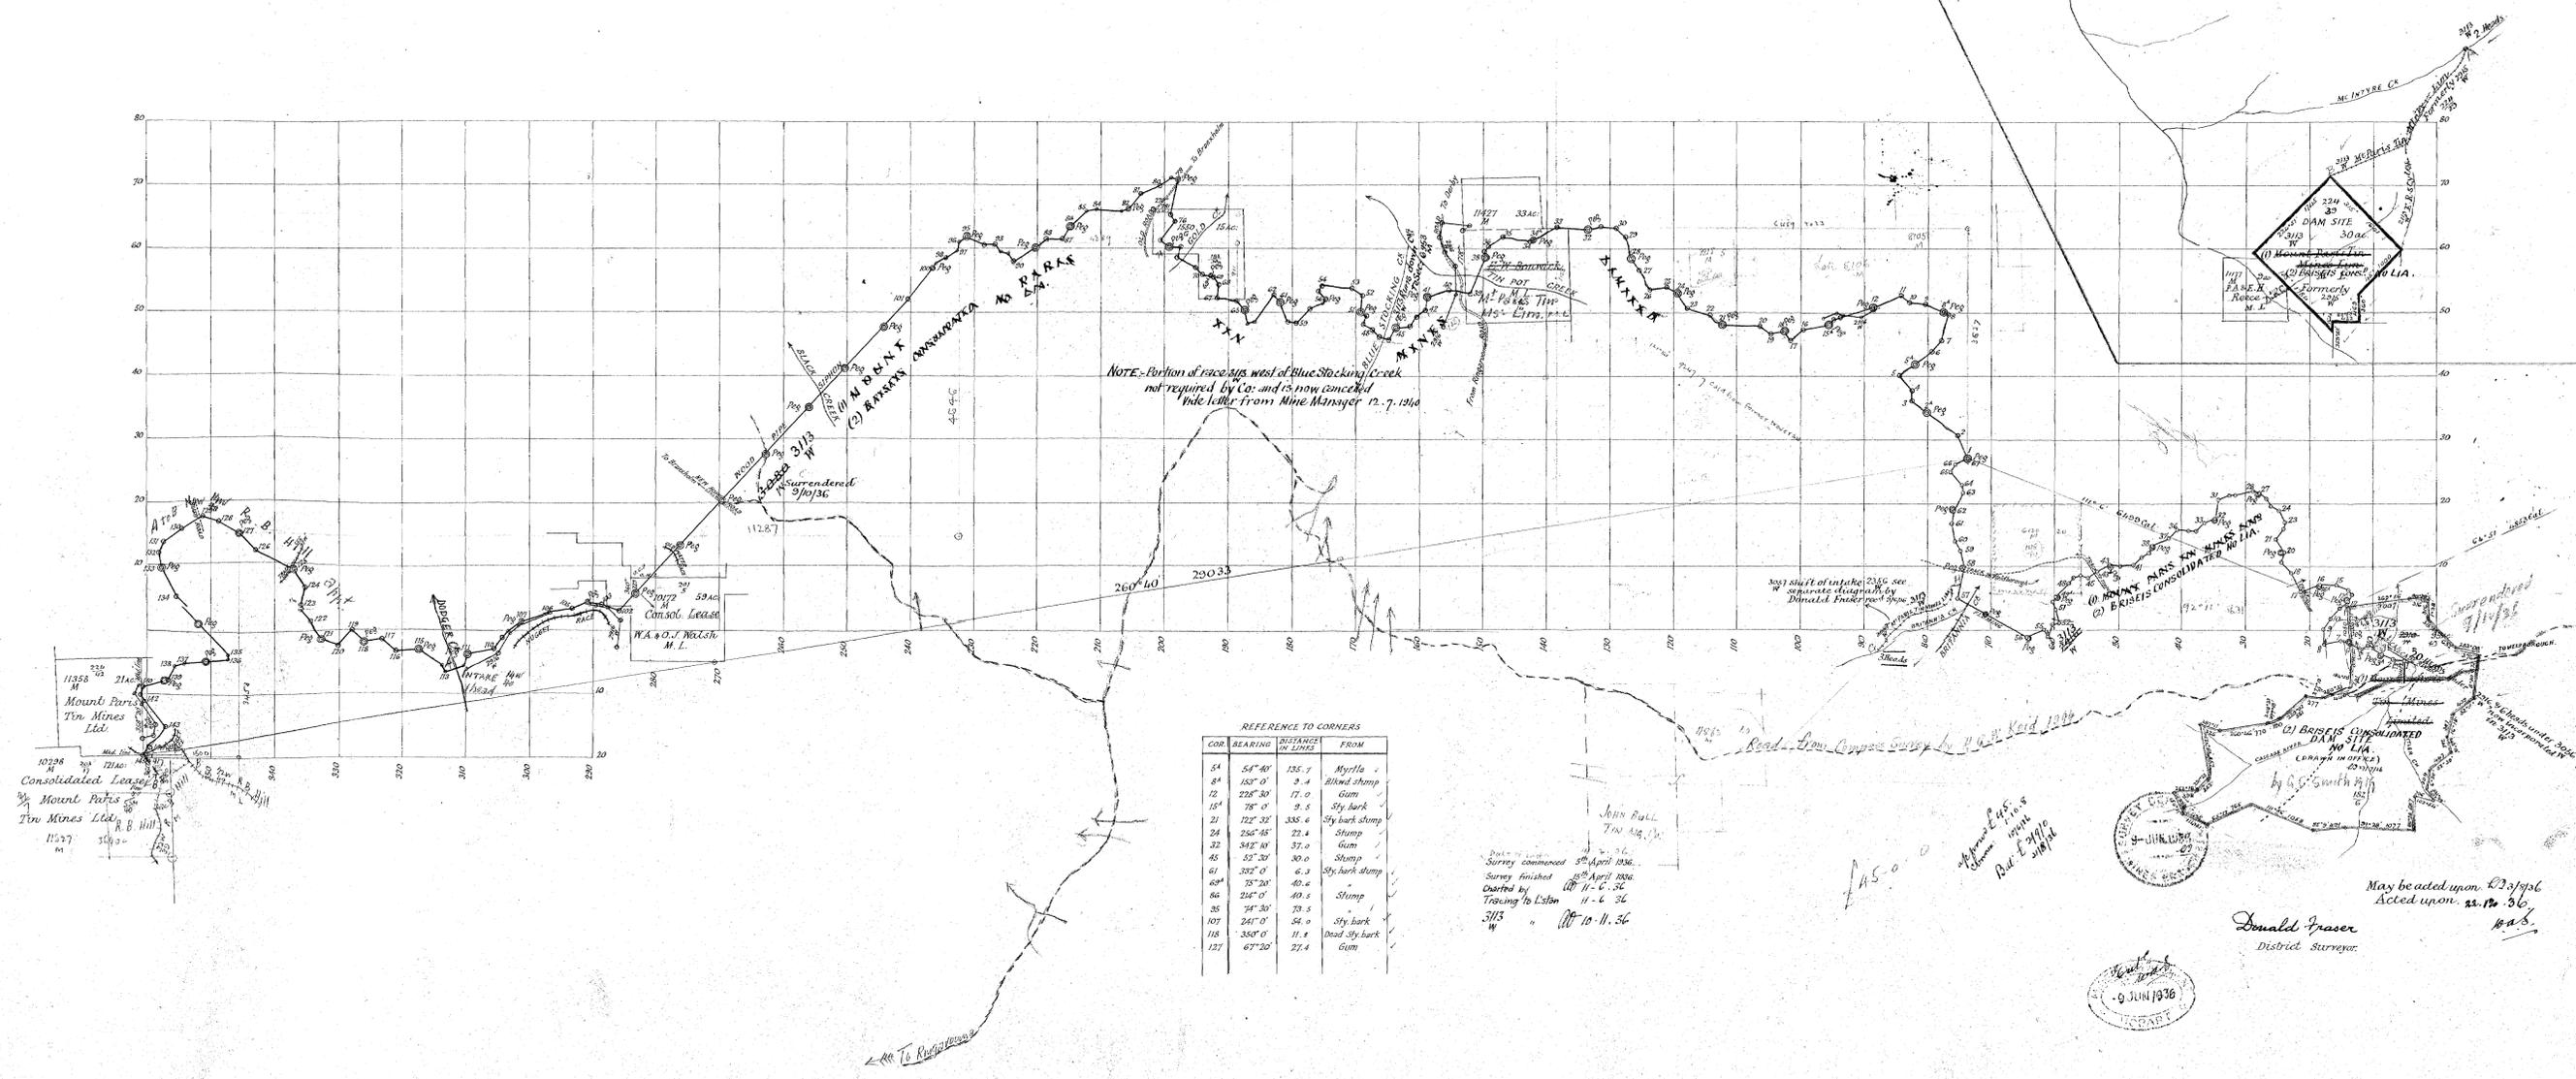

Note: Portion of race slip west of Blue Stocking Creek not required by Co. and is now concealed. Vide letter from Mine Manager 12.7.1910

REFERENCE TO CORNERS

COR.	BEARING	DISTANCE IN CHAINS	FROM
54	54° 40'	125.7	Myrtle
64	135° 0'	2.4	Blind stump
12	228° 30'	17.0	Gum
16	78° 0'	9.5	Sty bark
21	122° 32'	335.6	Sty bark stump
24	246° 45'	22.4	Stump
32	342° 10'	37.0	Gum
45	52° 30'	30.0	Stump
61	352° 0'	6.3	Sty bark stump
68	75° 20'	40.6	
86	214° 0'	40.5	Stump
88	141° 30'	70.5	
107	241° 0'	54.0	Sty bark
118	350° 0'	11.1	Dead sty bark
127	67° 20'	27.4	Gum

Date of survey 10.11.36  
Survey commenced 25 April 1936  
Survey finished 15 April 1936  
Checked by W.C. 11.6.36  
Tracing to Liston 11.6.36  
3113 W 10.11.36



9 JUN 1936

Donald Fraser  
District Surveyor

May be acted upon. D 23/9/36  
Acted upon. 22.12.36  
W.C.

197-03  
S.R.  
26.12.36  
40