


198-01


198-01

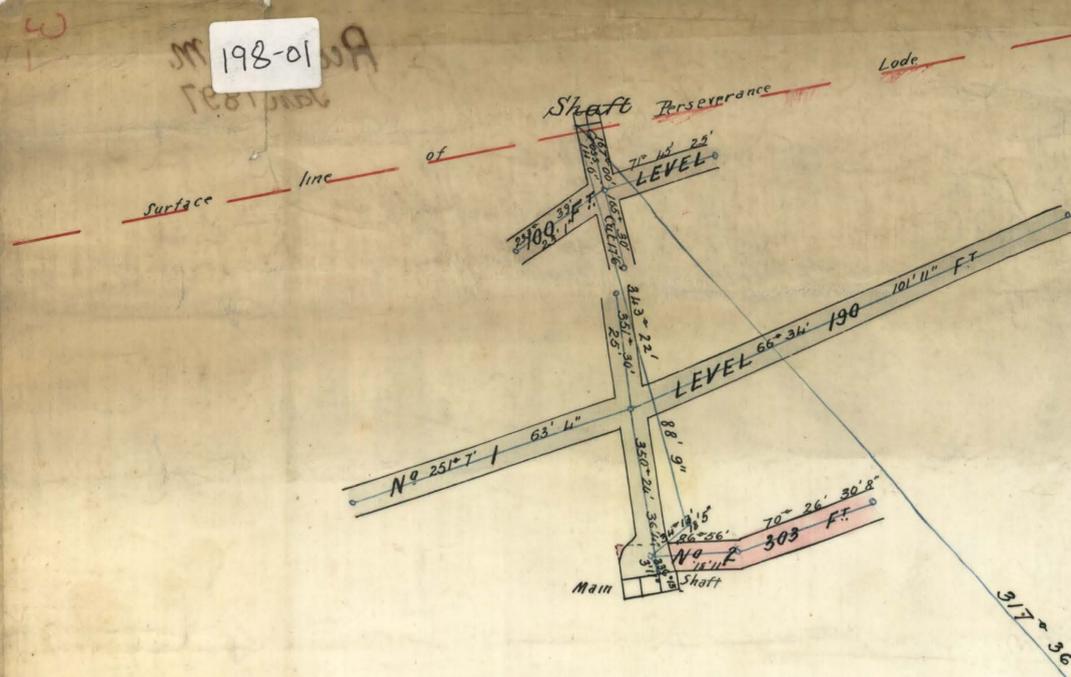

RECRUIT G. M. C. NO. 11A

Lefroy

Scale 25 feet to an inch

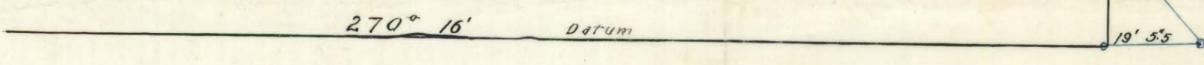

W. P. Miles.
 Authorised Surveyor
 Lumbermen
 Jan'y '94.

31

31