

5 cm

198-02

198-02

RECRUIT G M C^o



NO LIA

LONGITUDINAL



CROSS SECTIONS

Scale 25 ft to an inch

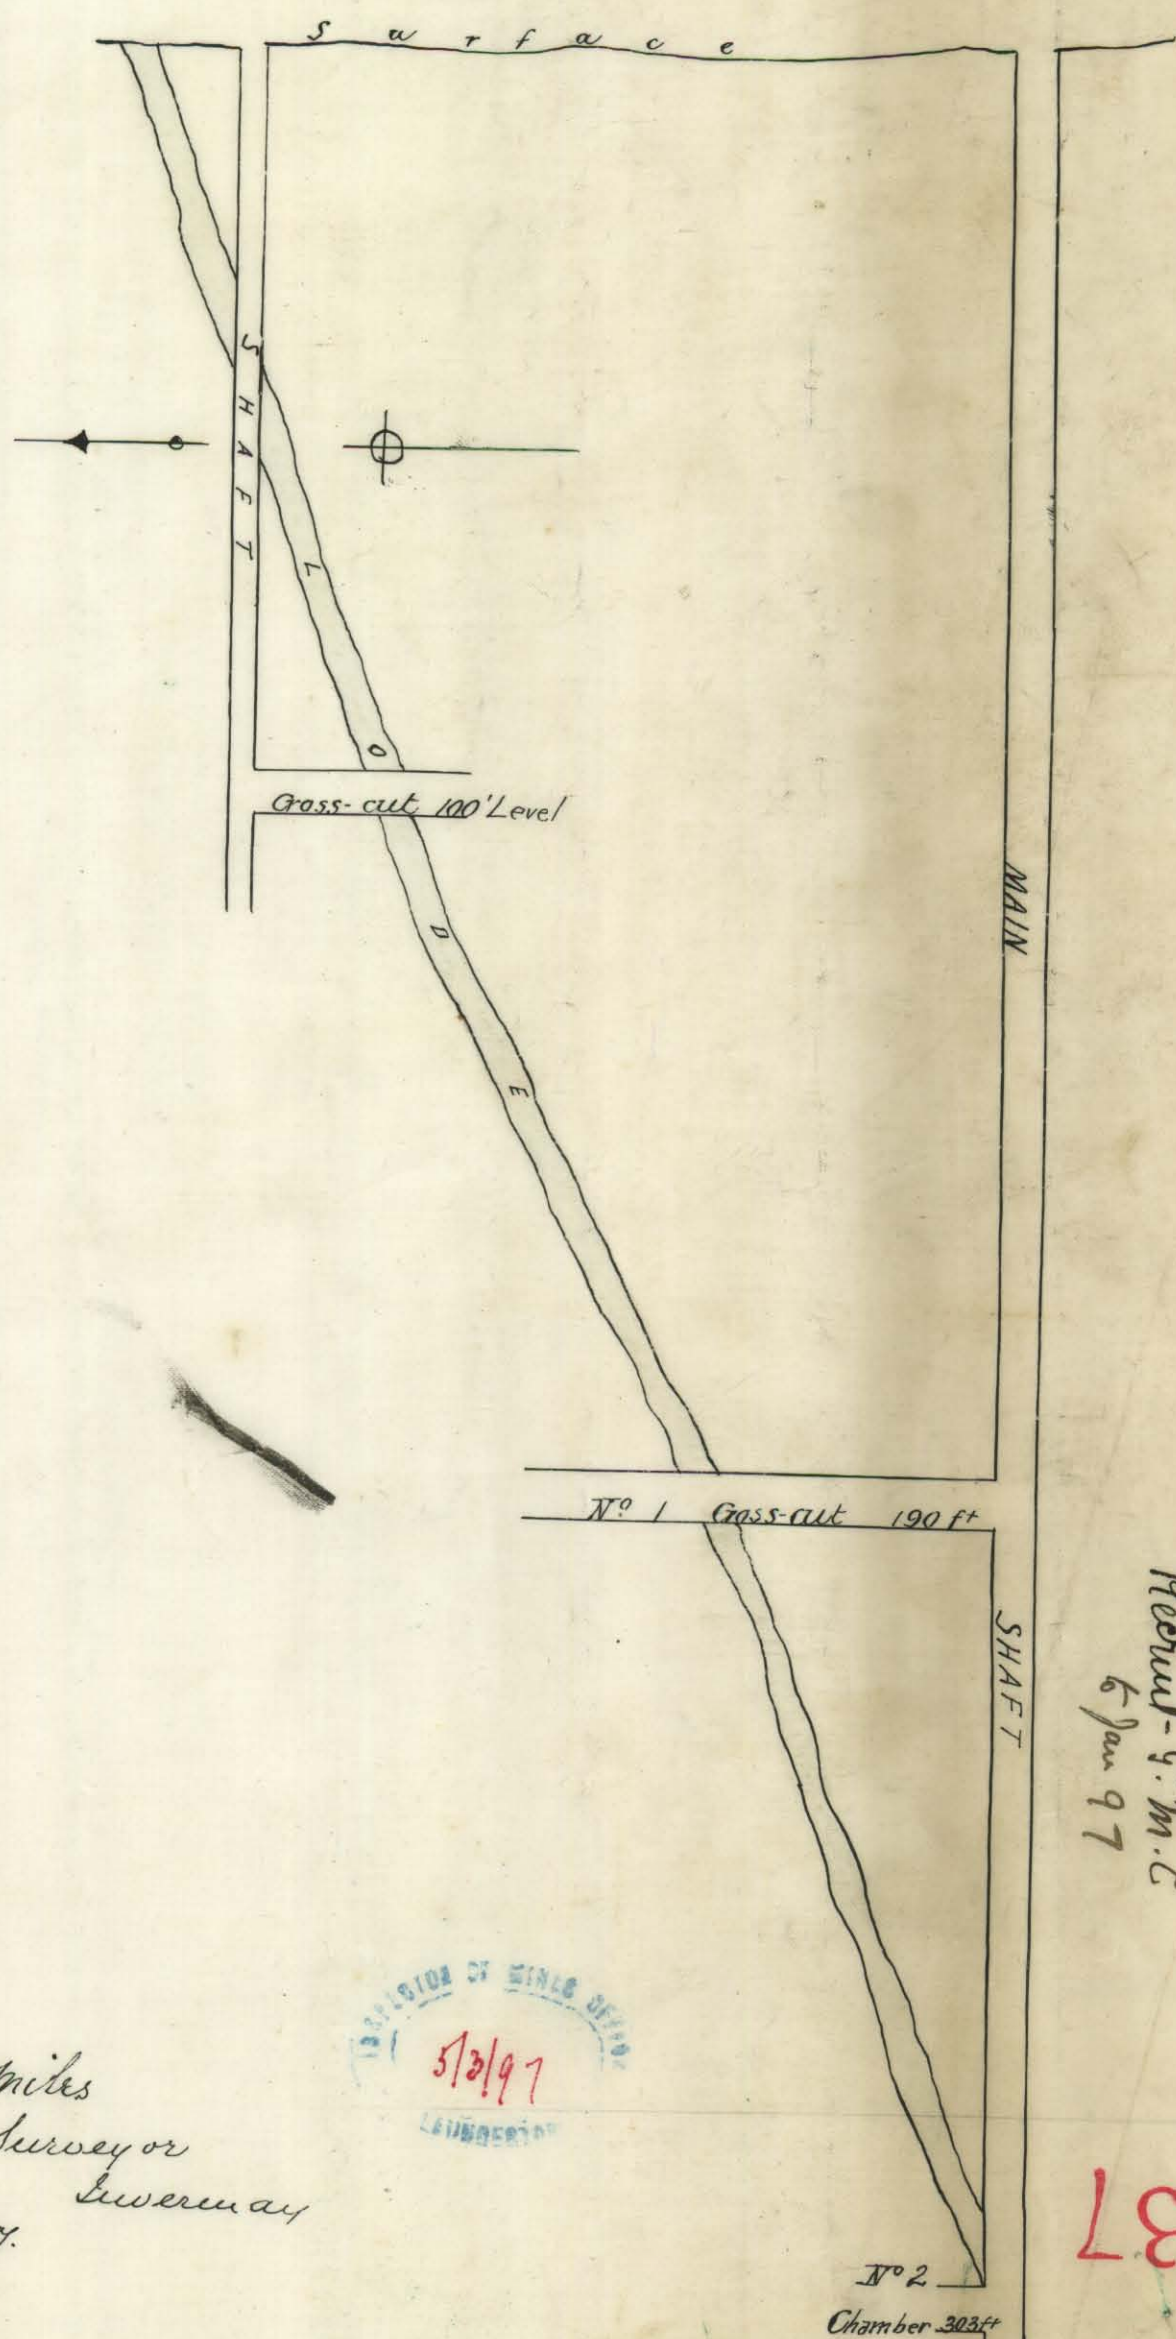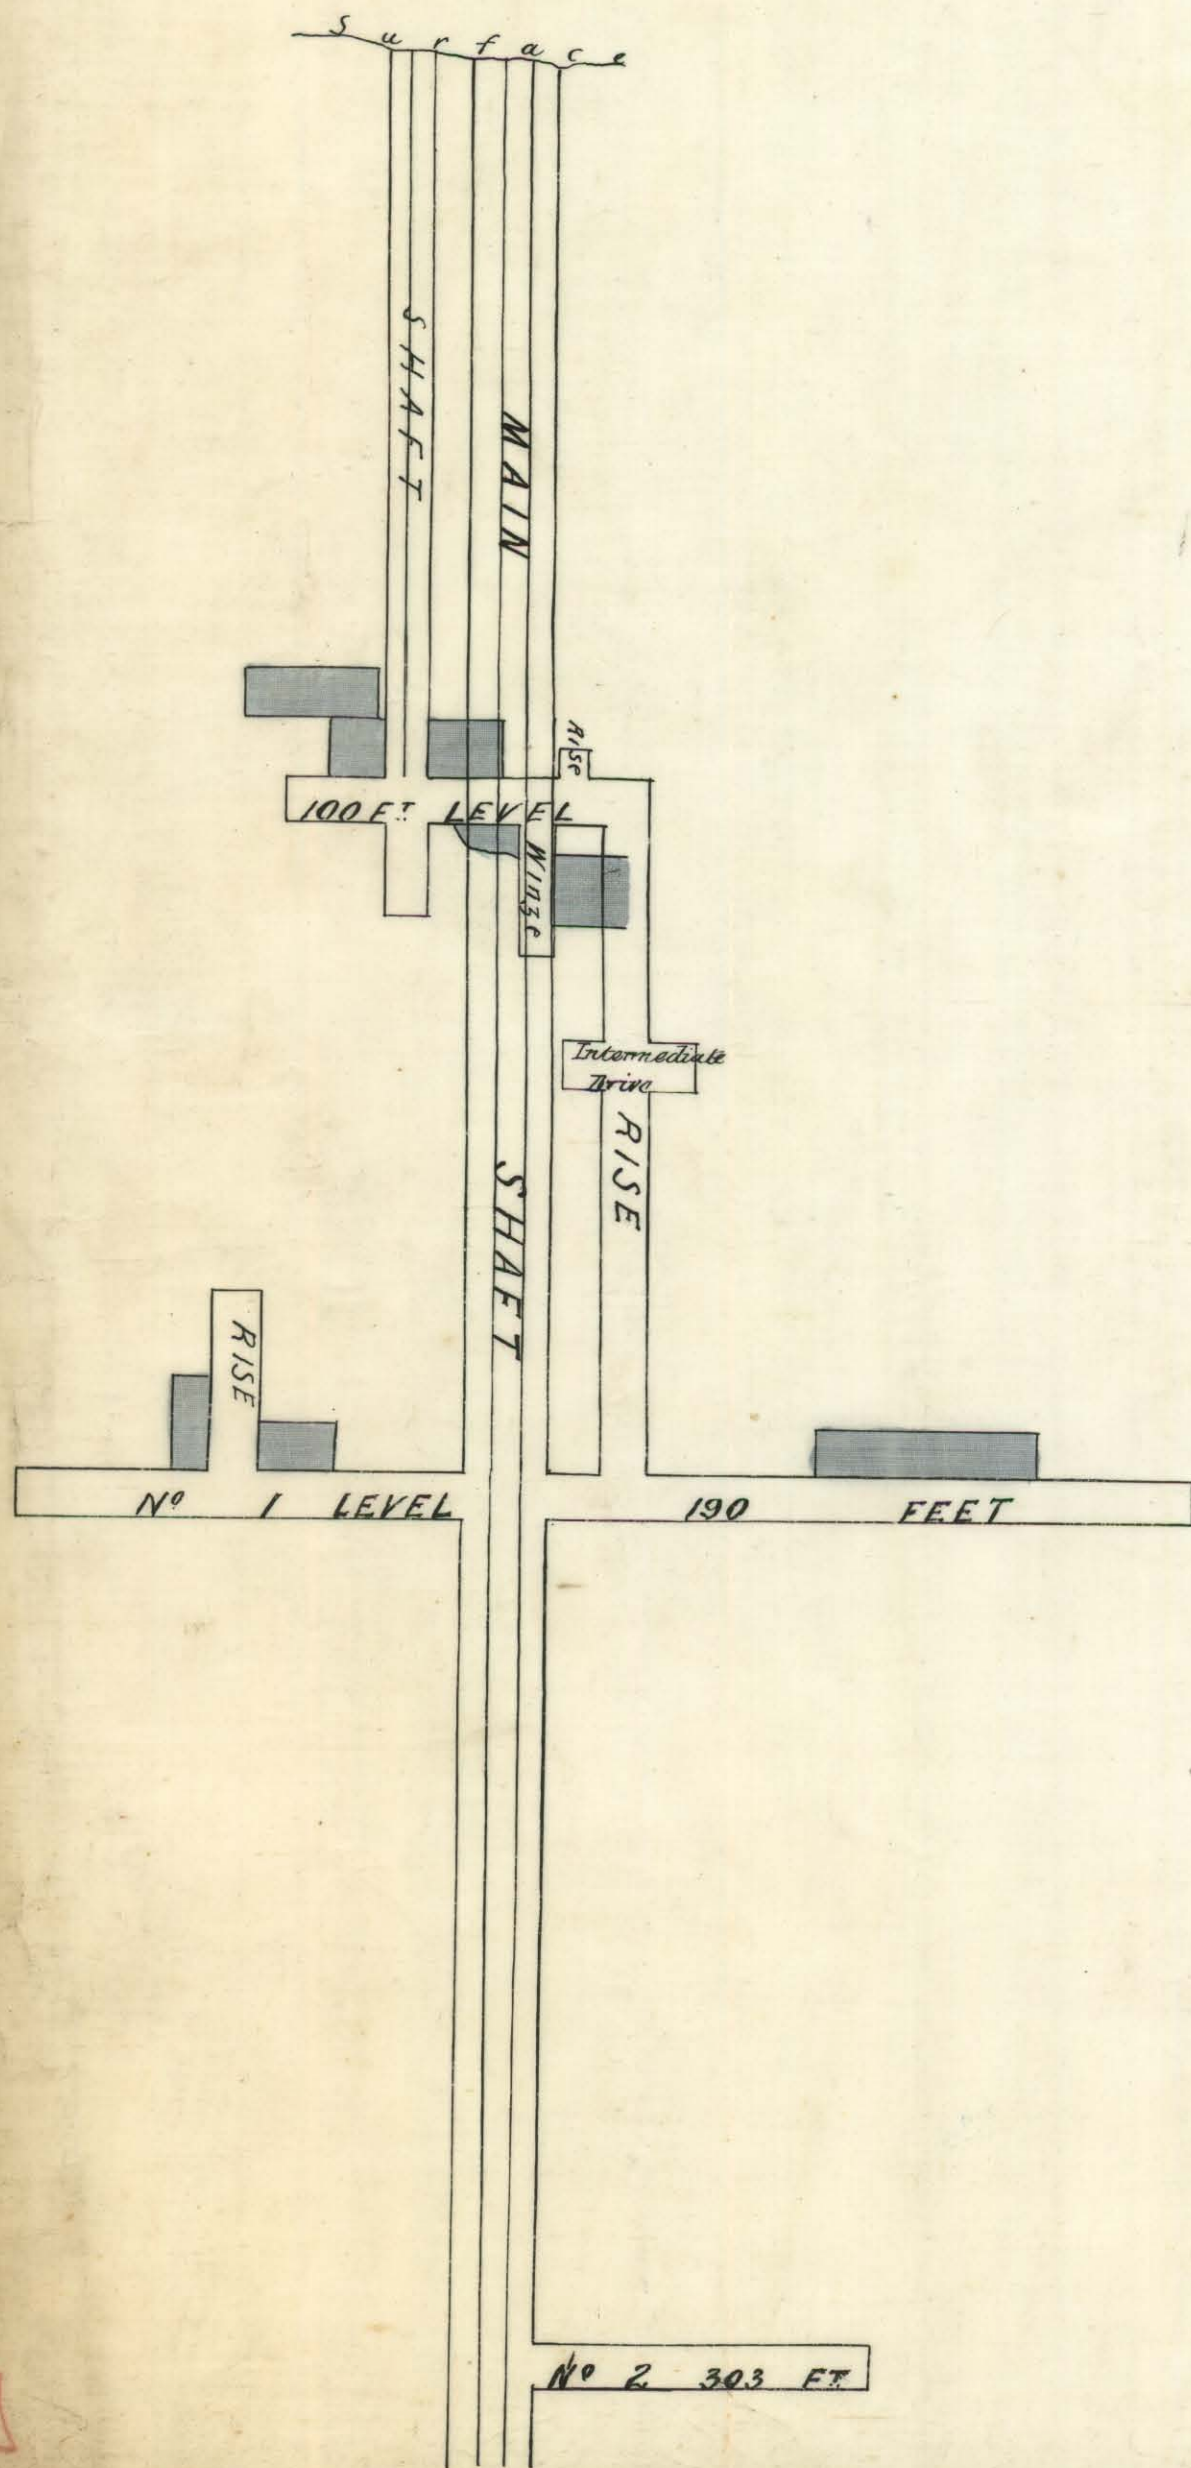

H. J. Miles
Surveyor
January 97.



Recruit-G.M.C.
6 Jan 97

37