


WESTERN DATUM BOUNDARY

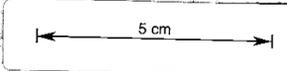

199-01

Light-levels Compared to Lapelins


New City of Melbourne S.M. Co.
Mathenia

Cross Section

25 feet to 1 inch



Brown
14-4-96

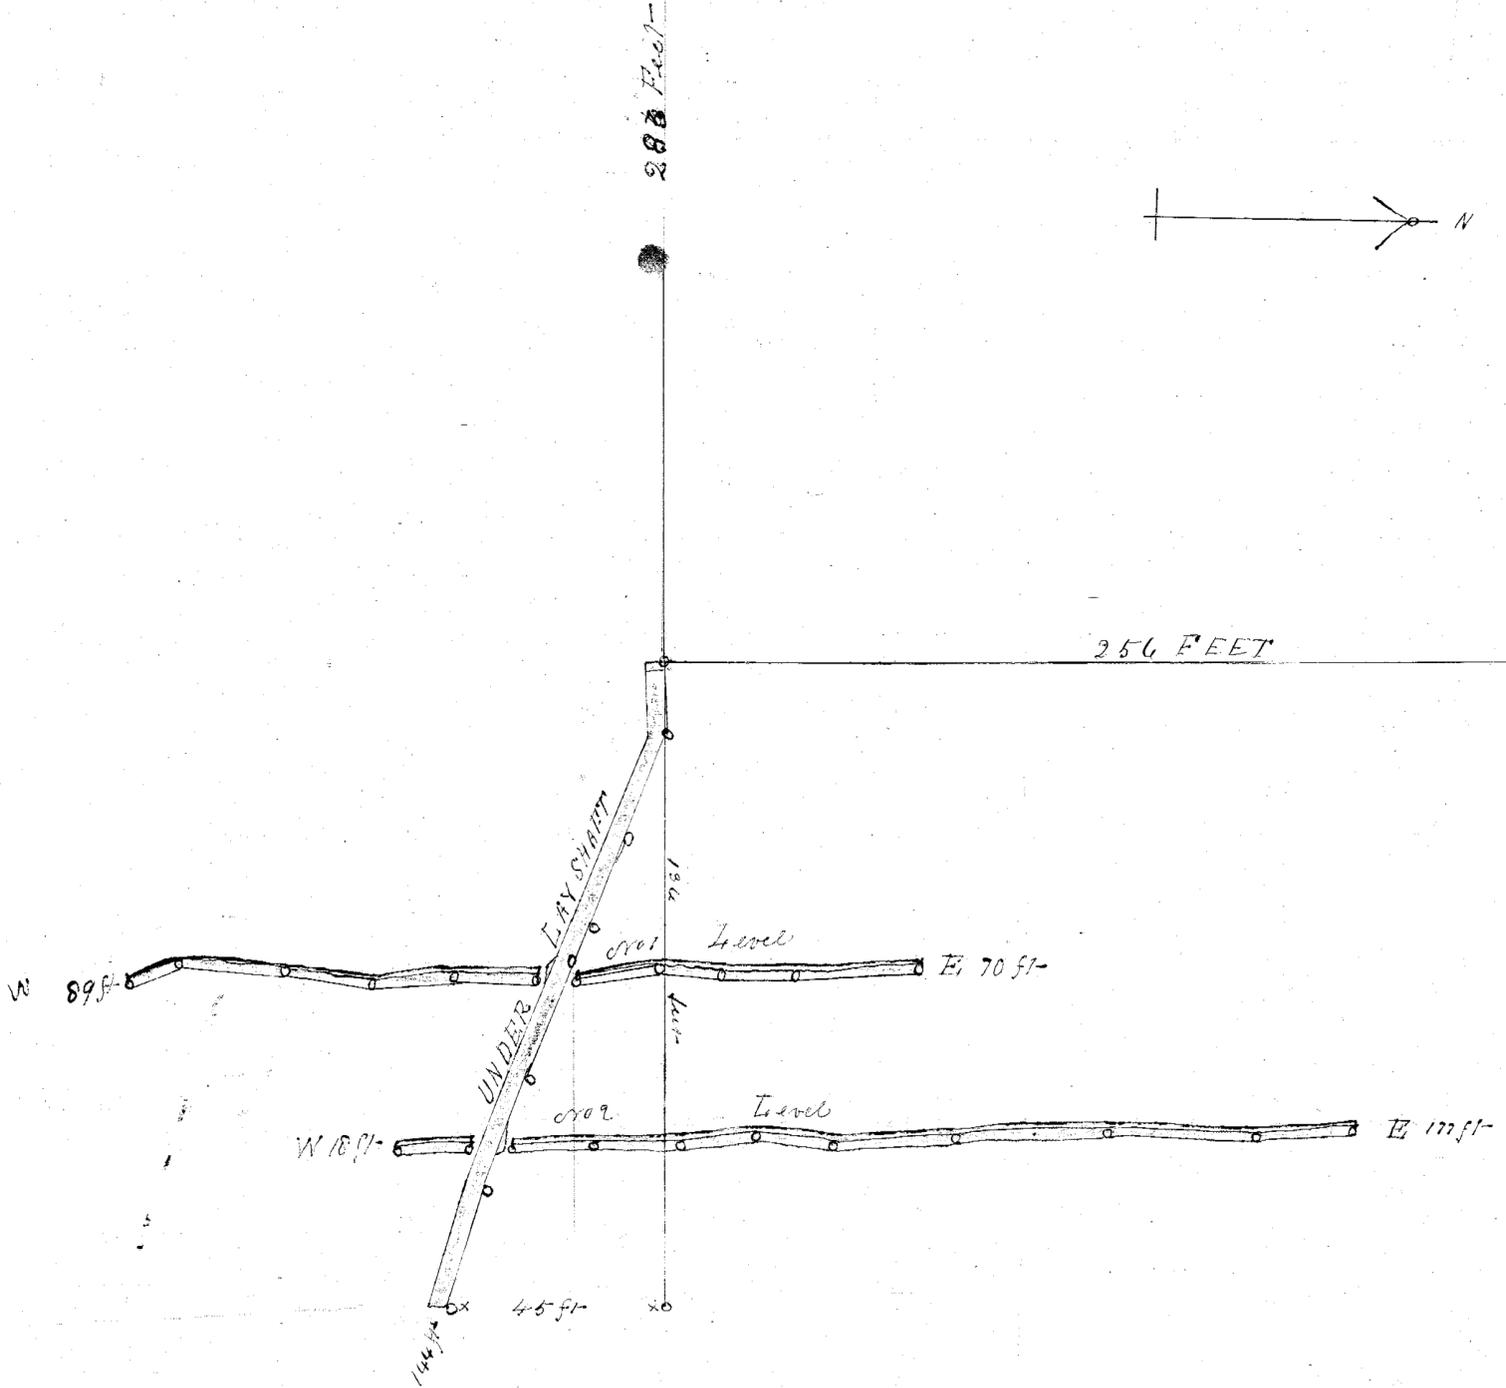

This was a section of the
shaft (no. 1) which was
cut off at a point of each
of the two levels placed relatively
to the position on the
cross-section
H. H. H.
11/9/41