


199-03

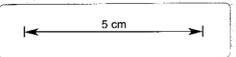

New City of Melbourne

1053
879


283 FT NORTH BOUNDARY OF SECTIONS
530 TO CHAINS E & W
DATUM

NEW CITY OF MELBOURNE .C.M.C. N.L.

MATHINNA

10 ACRES
NEW CITY OF
MELBOURNE

SURVEY MADE WITH SIGHT LEVEL +
LEVEL + SECTOR AND
TAPELINE

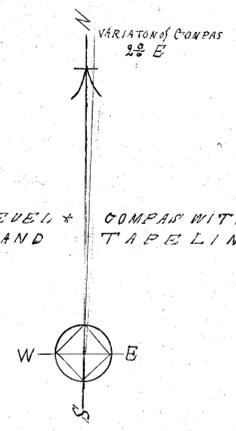

SCALE 25 Feet to 1 Inch




G. Brown
mine manager
19-1-96

LEASE
1053
879

266 Feet

SURFACE

LINE

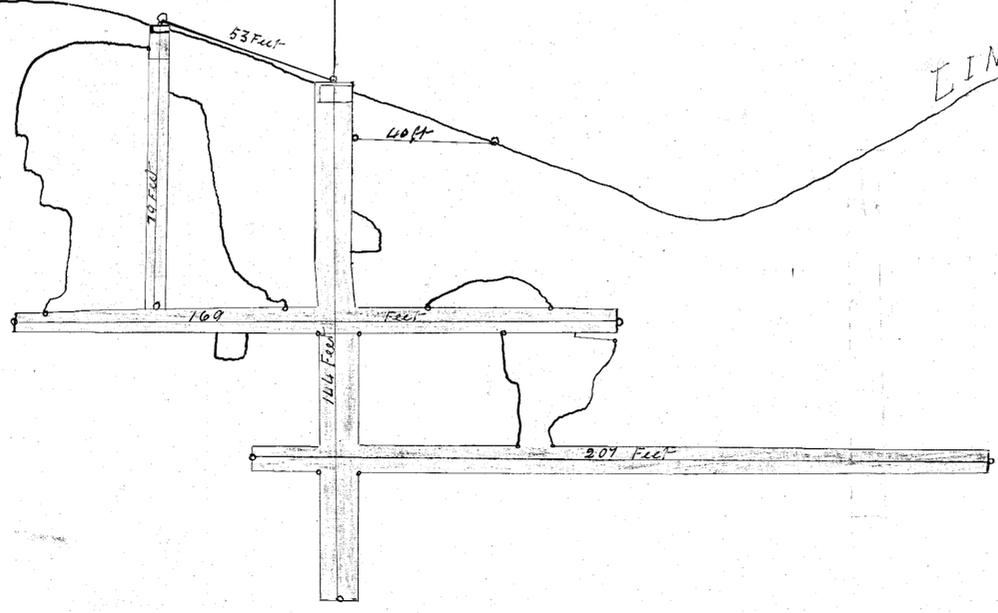

*E-W Longitudinal Section
(Looking North)*