





150 ft
100 ft
50 ft
20 ft

SMITHY

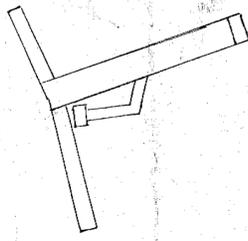


201-02

Central Ringarooma
— Scale 25 feet —

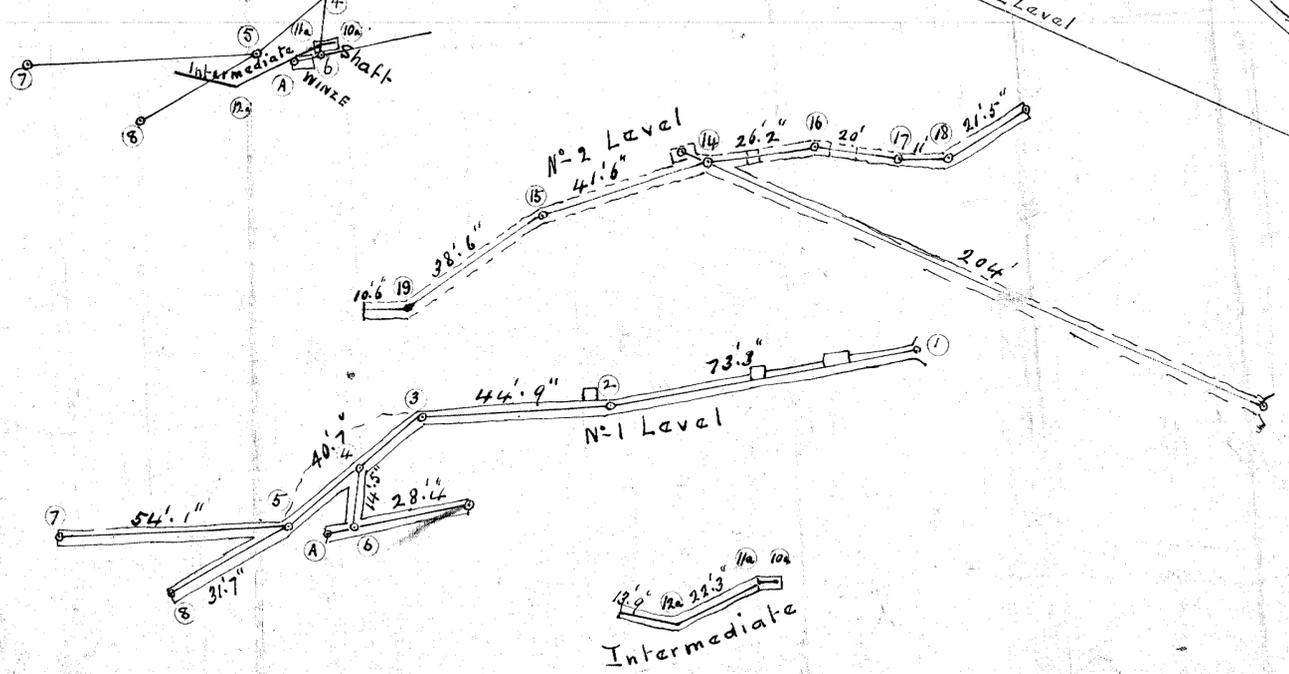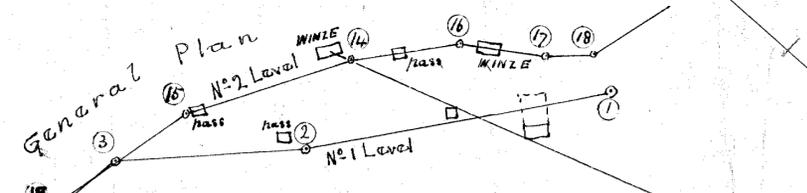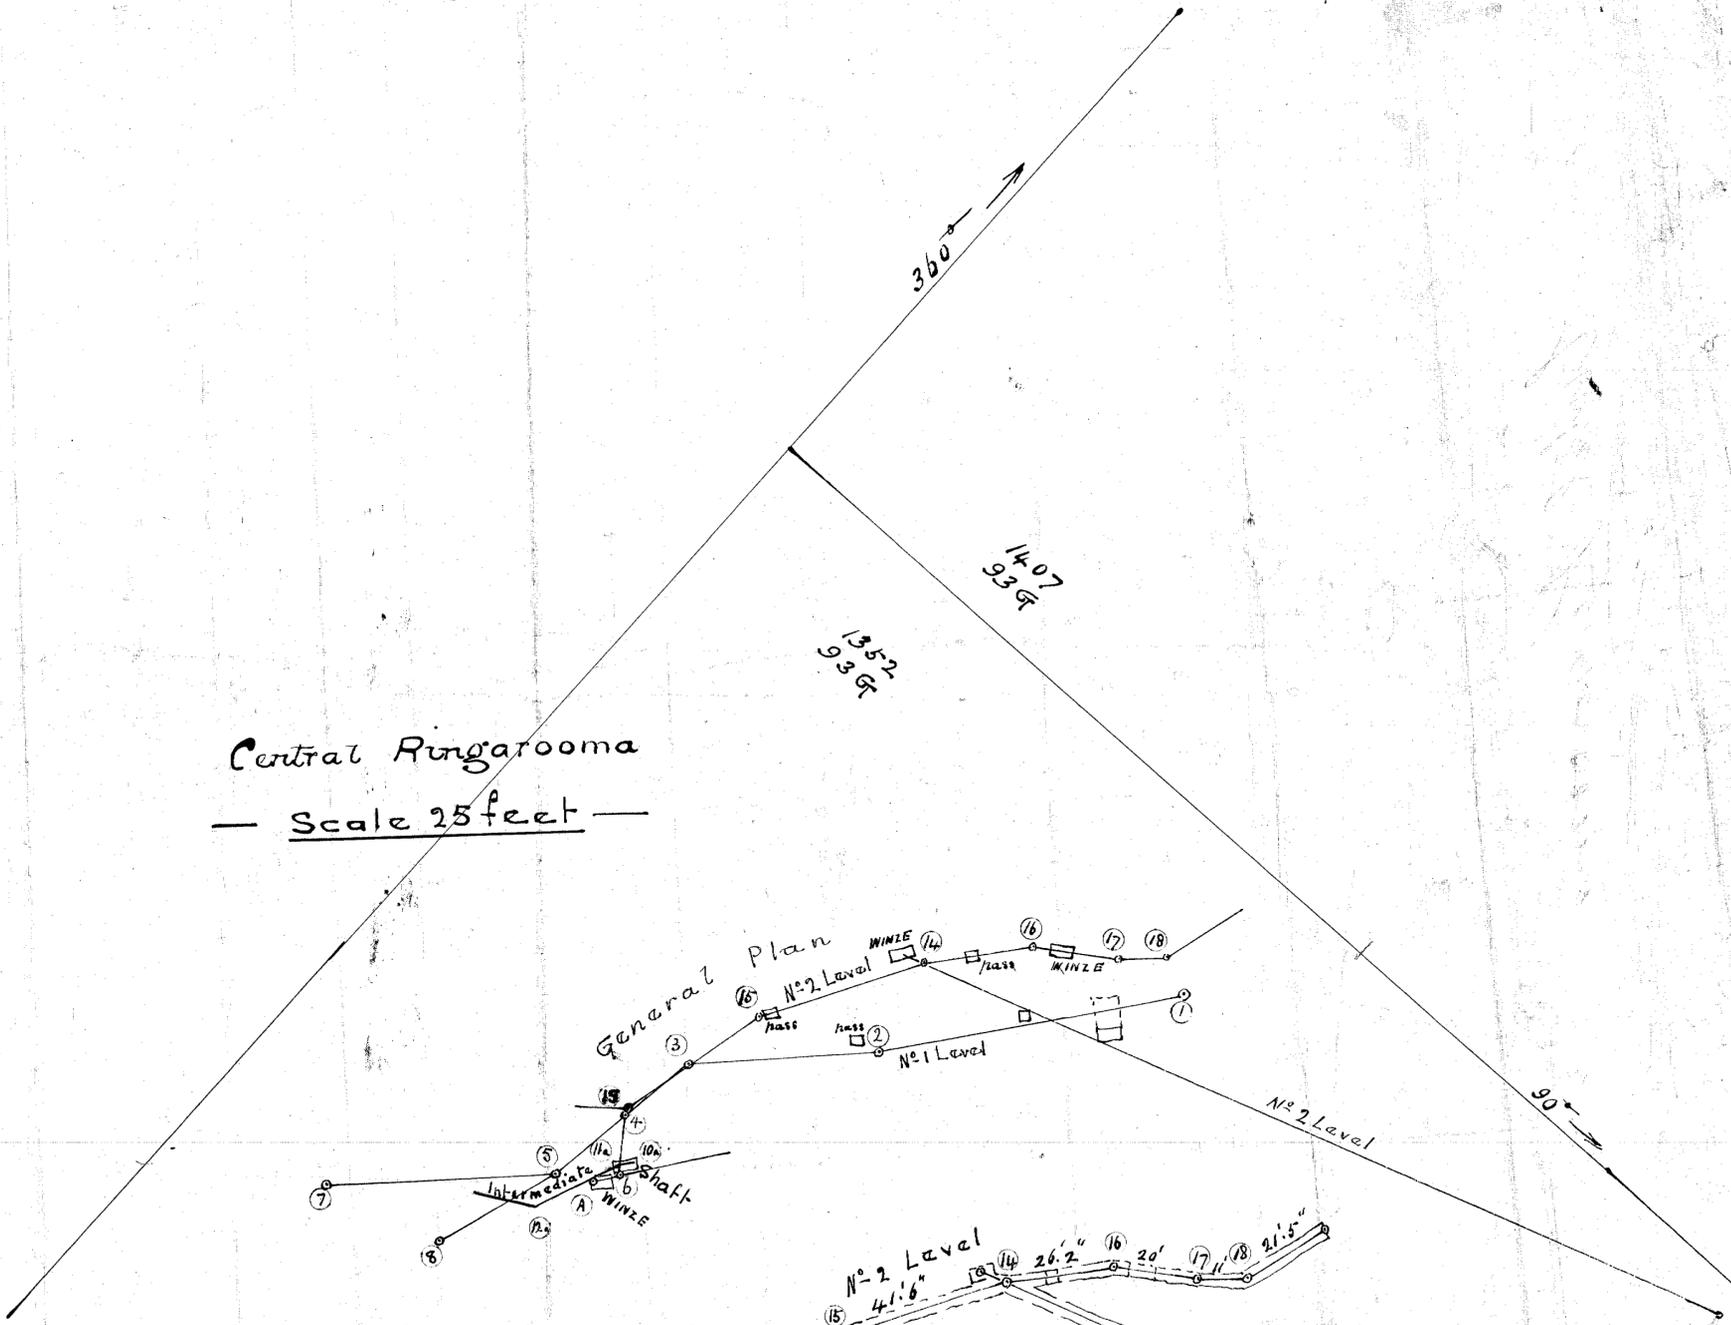

201-02

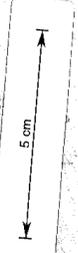

150
100
50
20