


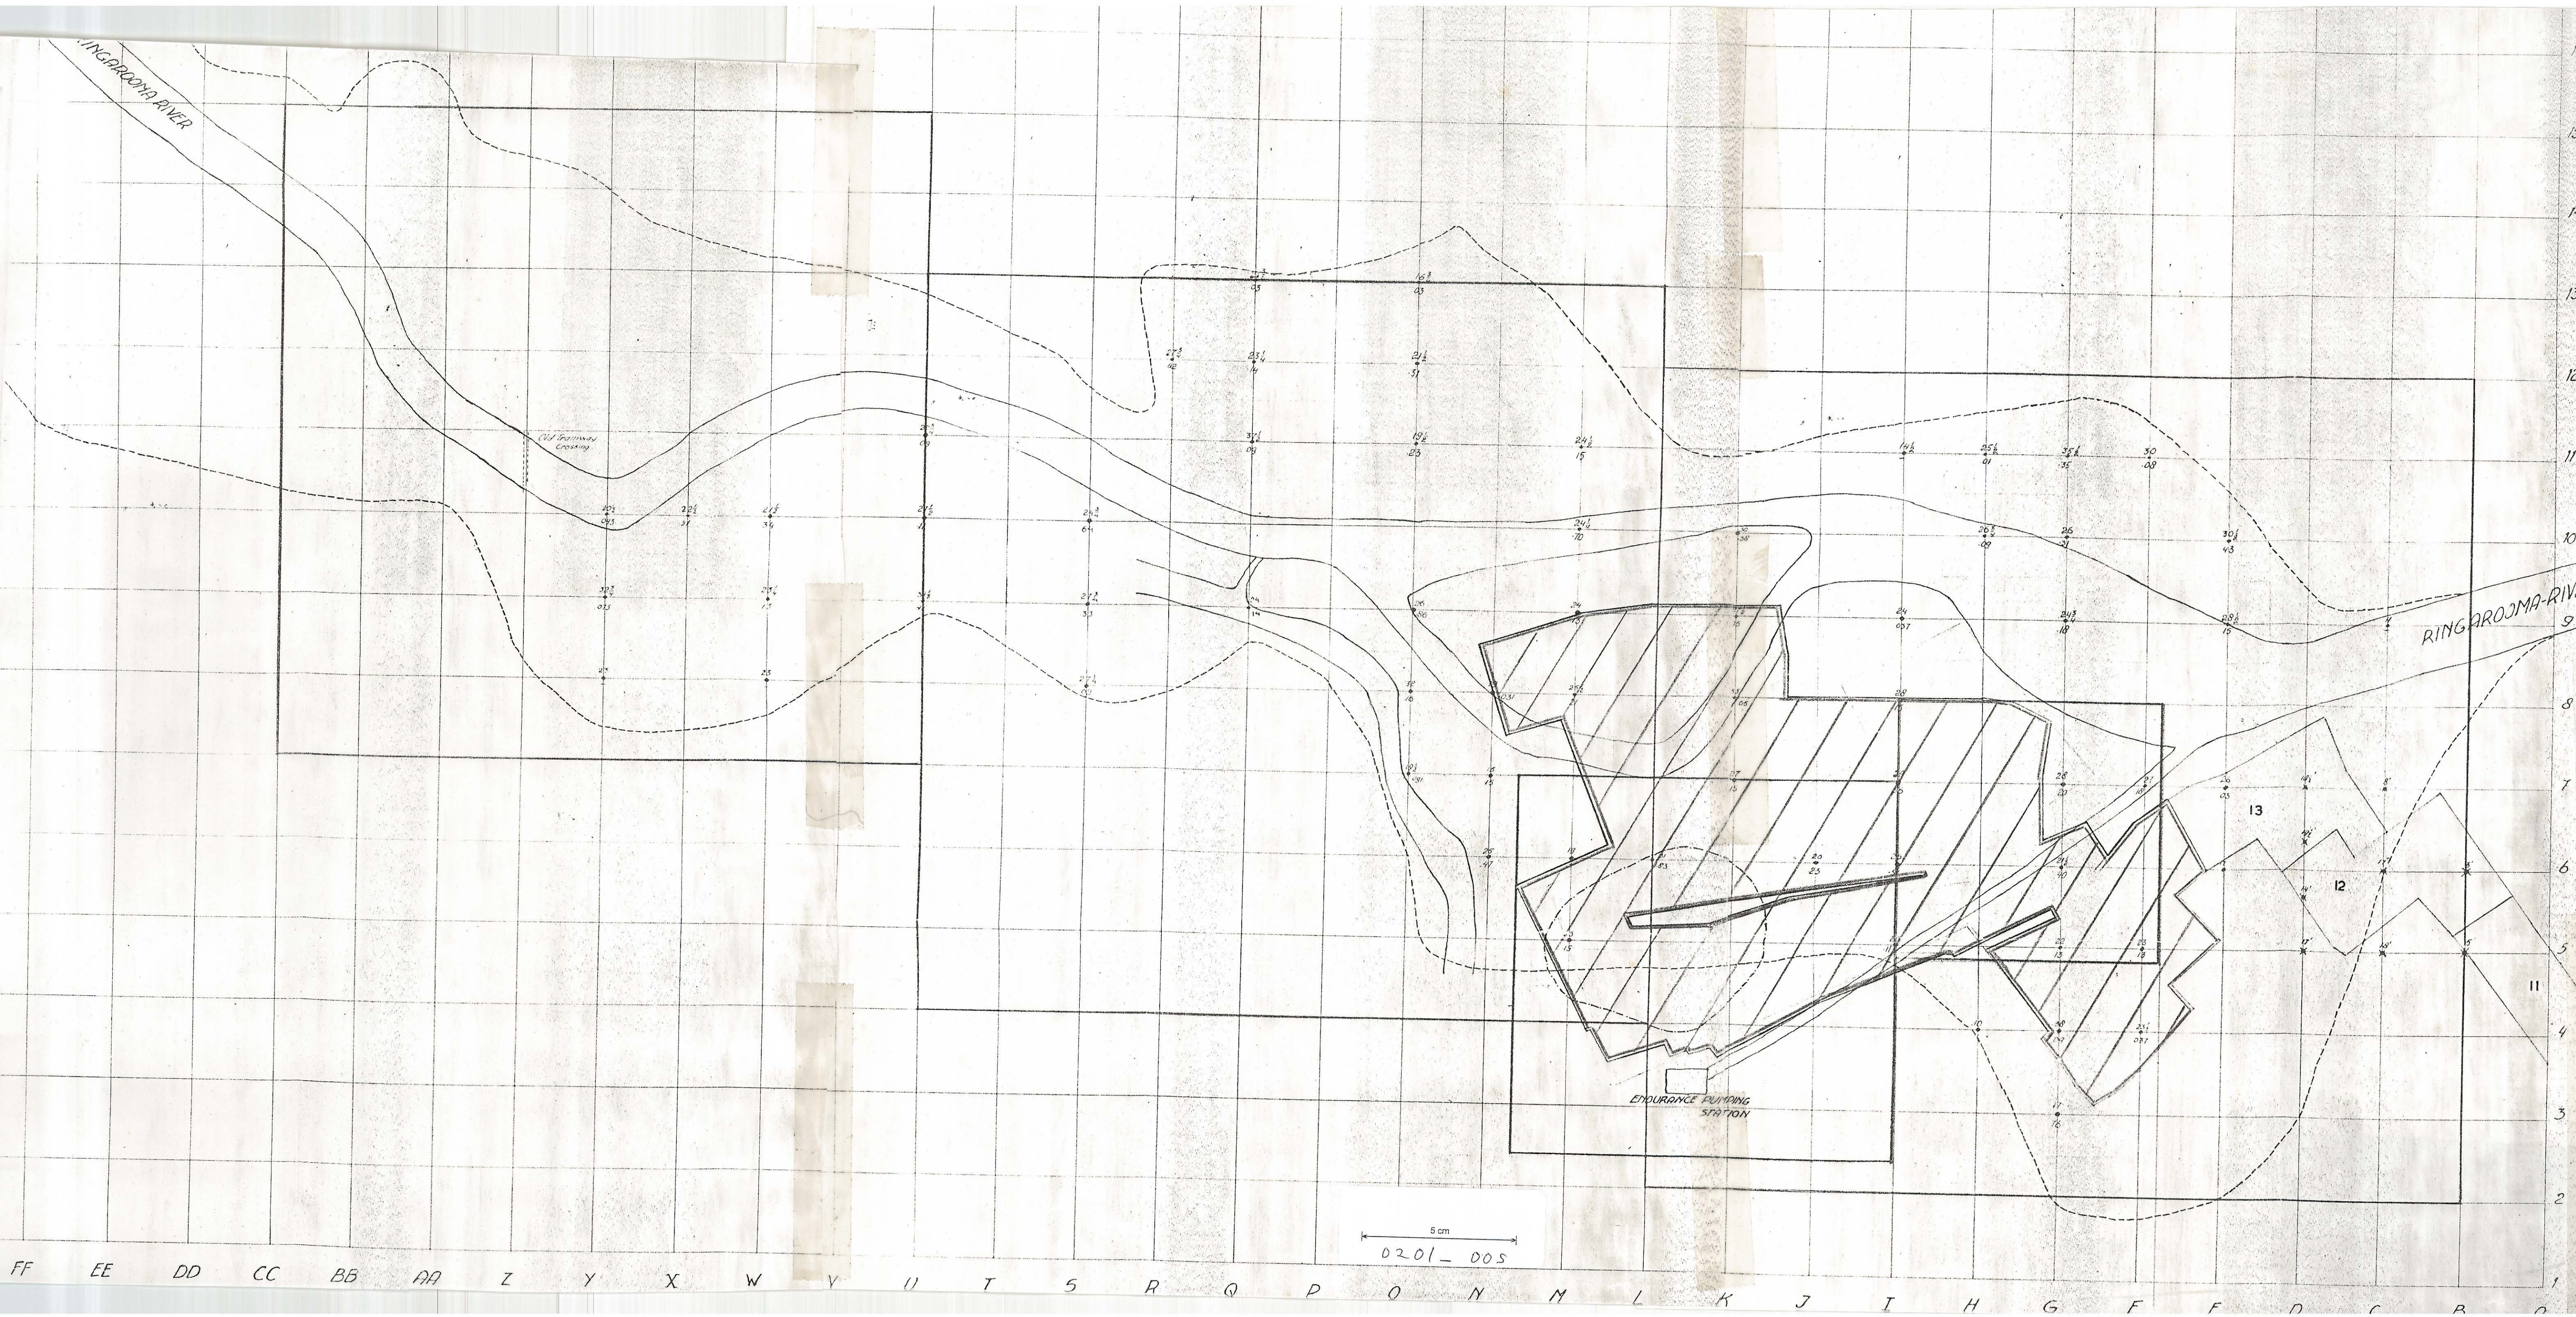

LEGEND:
 --- TERRACE
 --- WORKED BY DIESEL-BARGE
 * BENT HOLES BY 16" CONRAD PLANT
 --- LEASE ENDURANCE TINY MINING CO.
 X 5" HAND PLANT TEST-BORES
 [Hatched Box] AREA DREDGED 1960
 [Solid Box] DORSET EXTENDED LEASES

Storeys Creek Tin Mining Co. H.L.
 DORSET TINDREDGING
 DORSET EXTENDED
 1960
 SCALE: 3 in. = 1" DATE: SUND:

obtained 6/1980.

0201-005

from D of M underground mines

Collection

DORSET EXTENDED