

ABBOTSFORD CREEK

OMC

Morgan Reef Workings

Scale 30 feet to an inch


Vertical Scale 3' to an inch

Horizontal Scale 3' to an inch


By

Richard Richards Civil Engineer


Longitudinal Section
"Morgan Reef"
(Looking East)
Scale 30 feet = 1 inch

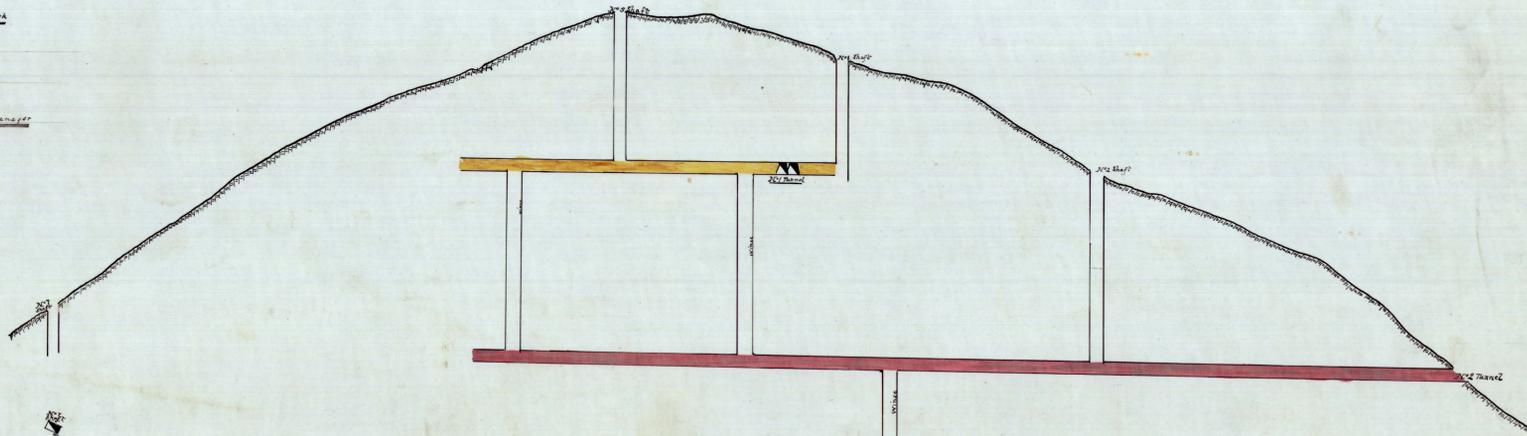

Plan of
"Morgan Reef"
Tullachganm Eathie
Scale 30 feet = 1 inch

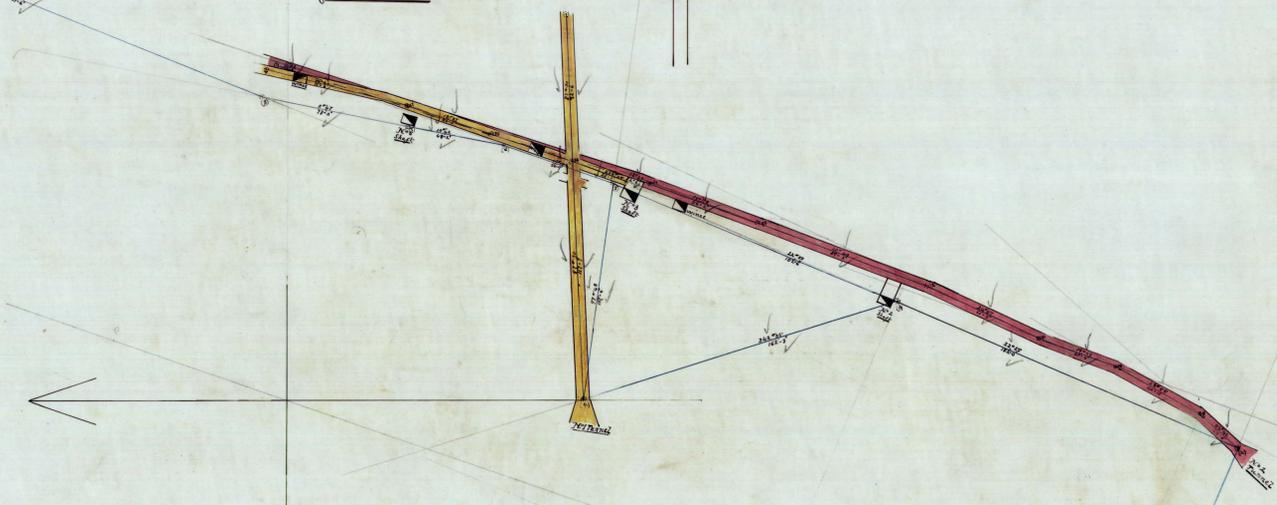

CROSS SECTION
Scale 30 feet = 1 inch

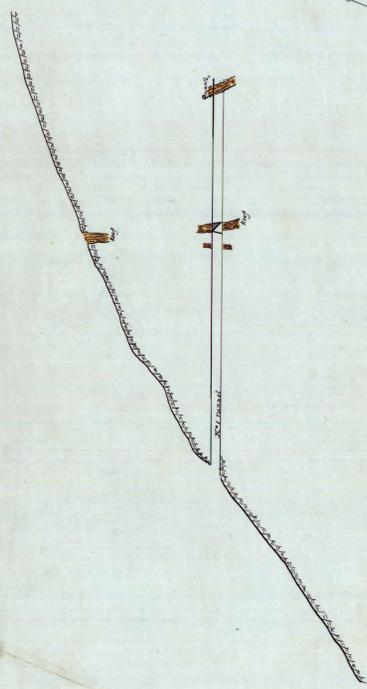

202-01



Corner 1380

1920

Handwritten notes on the right edge of the page.

Handwritten notes at the bottom right corner.