


Abbotsford Creek
G. M. Coy

Longitudinal Section
(looking N.E.)
Scale 30 feet to an inch

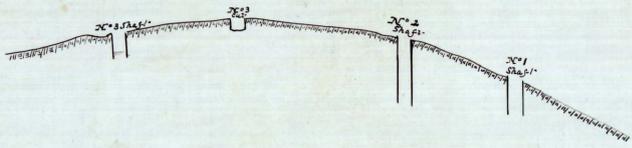

Entrance Tunnel
Entrance Tunnel





Plan of
'Beauty' Reef Workings
Scale 30 feet to an inch

Instrument used: theodolite



Cross Section
Scale 30 feet to an inch

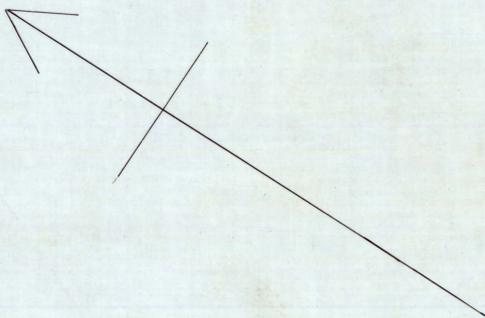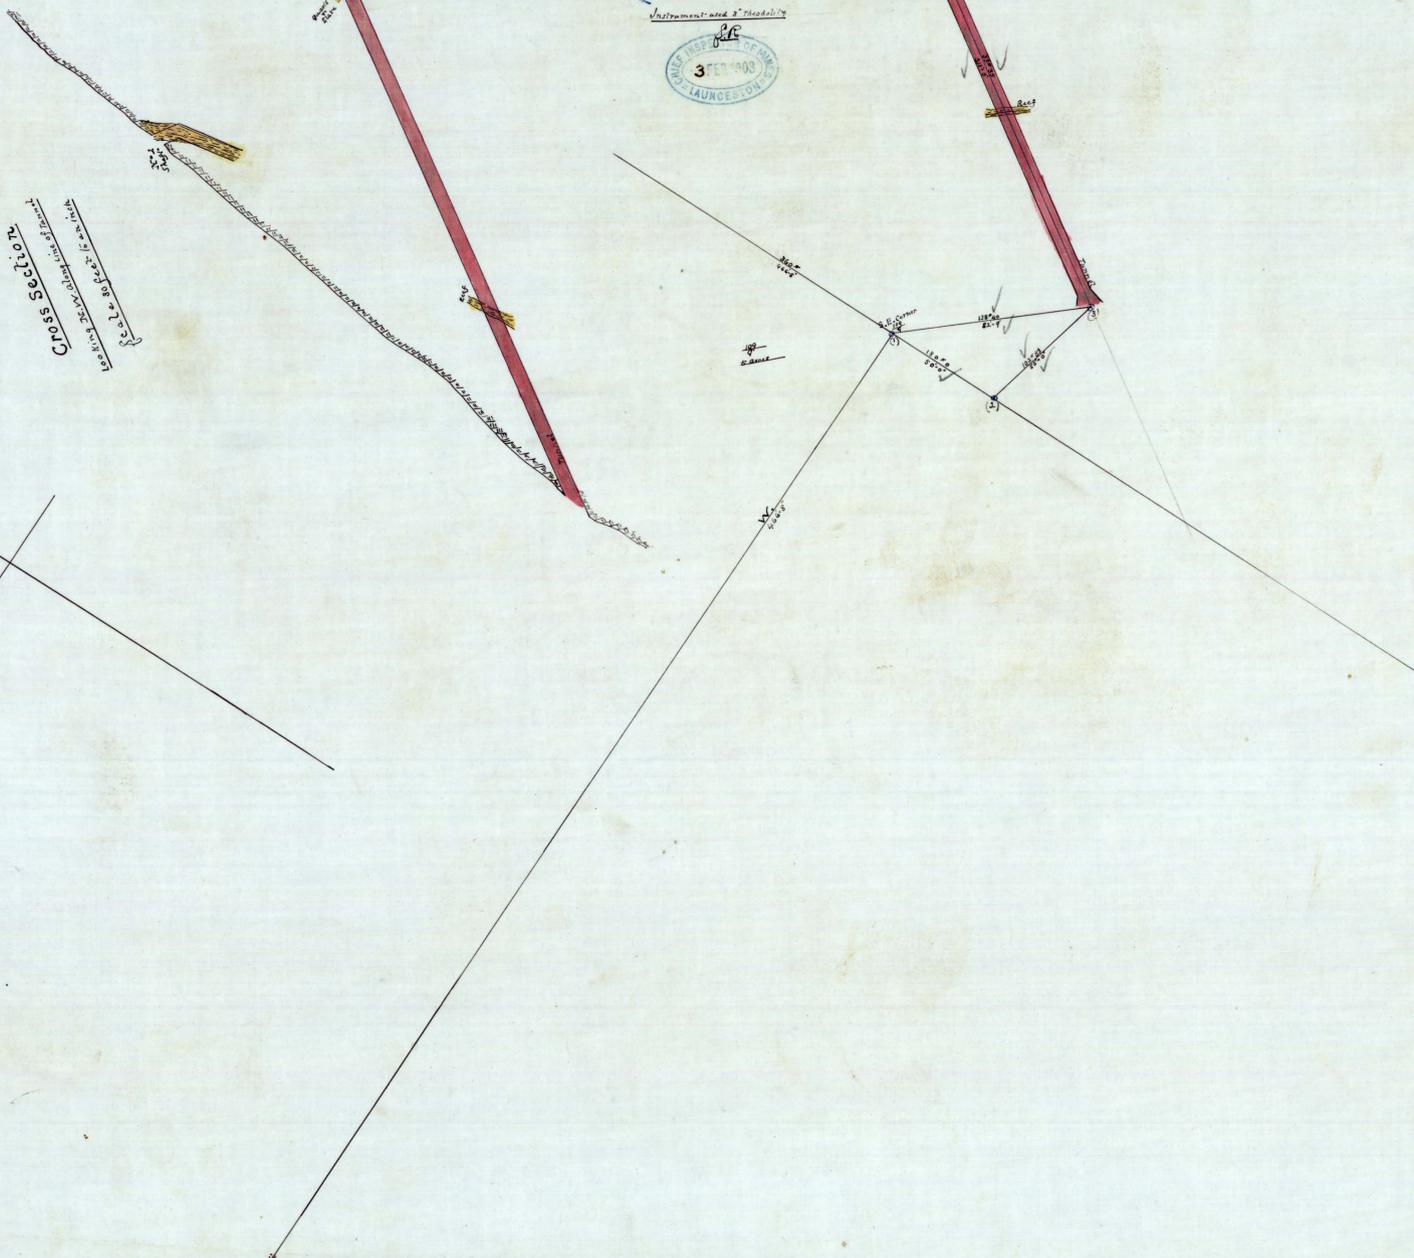

202-02

202-02



500

002

Surveyed
Nov 1903
G. M. Coy

202-02

500