

100  
M. S. Hand  
E. O. P. and  
M. S. Hand

Abbotsford Creek

G. M. Cox

J. R. B.




Longitudinal Section

Burns Reef


(Looking N.W.)

Scale 30 feet to an inch

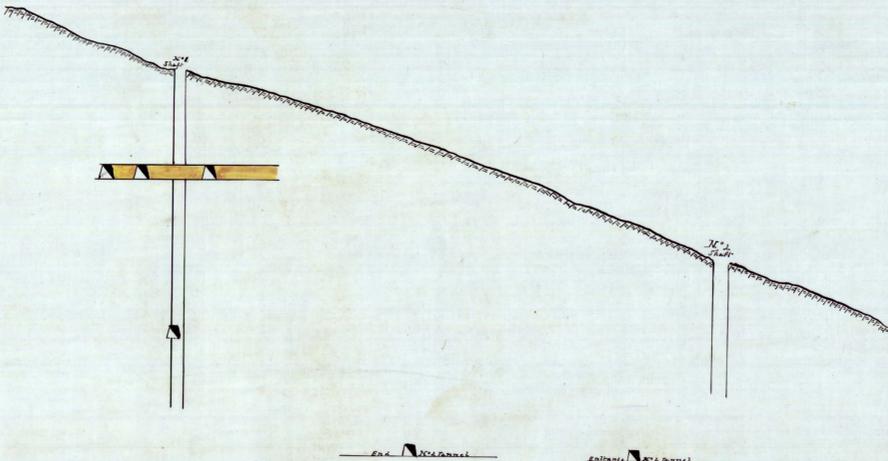

End of Channel

202-03

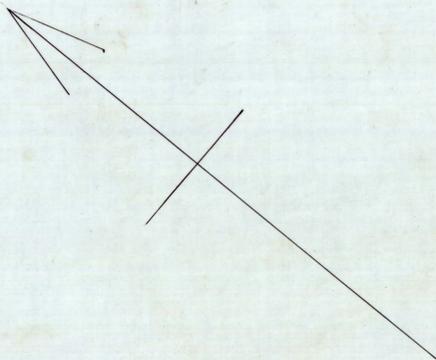


Plan of

Burns Reef

Scale 30 feet to an inch

Instrument used 3" Transit

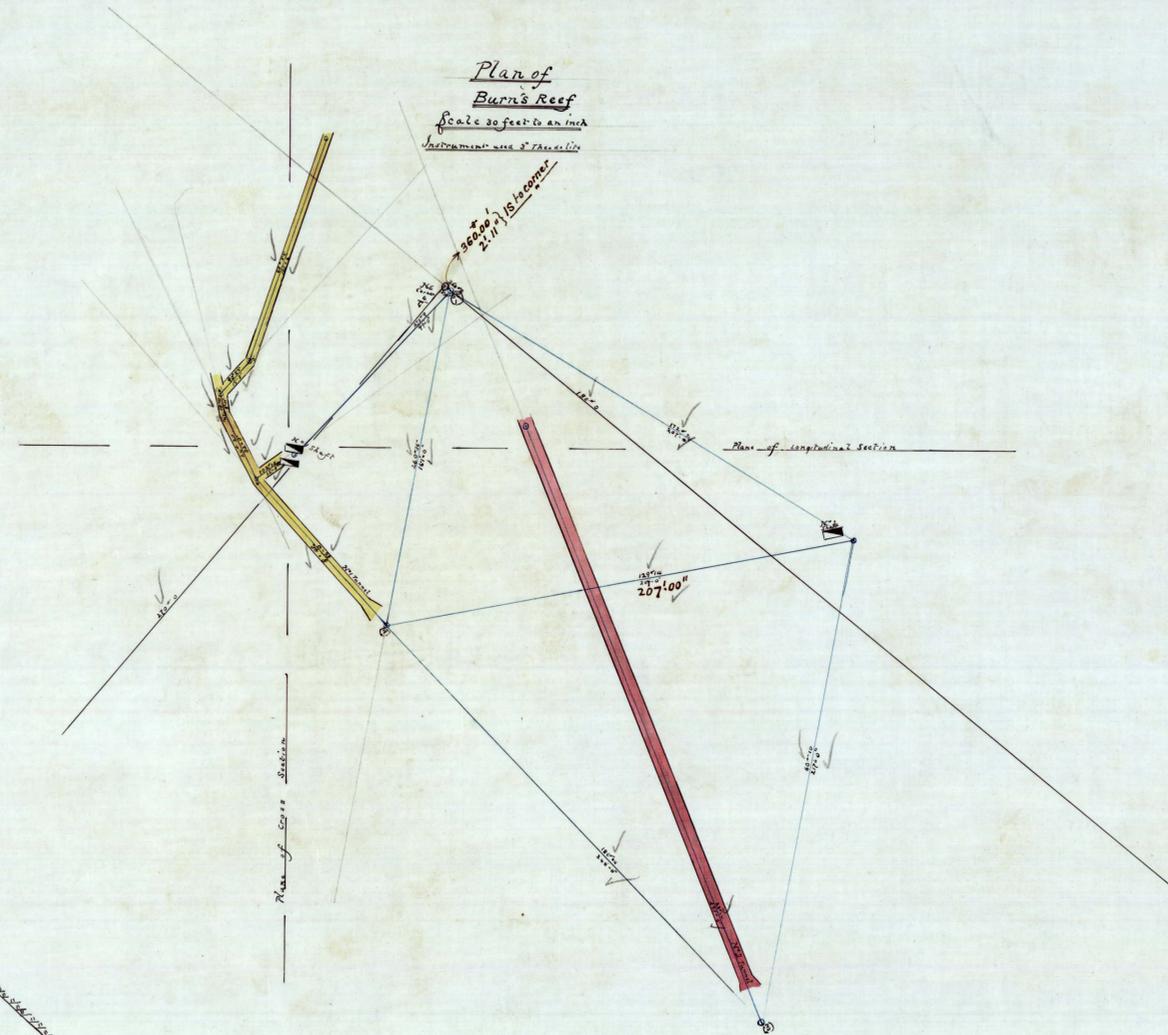


Cross Section

Burns Reef

(Looking N.W.)

Scale 30 feet to an inch

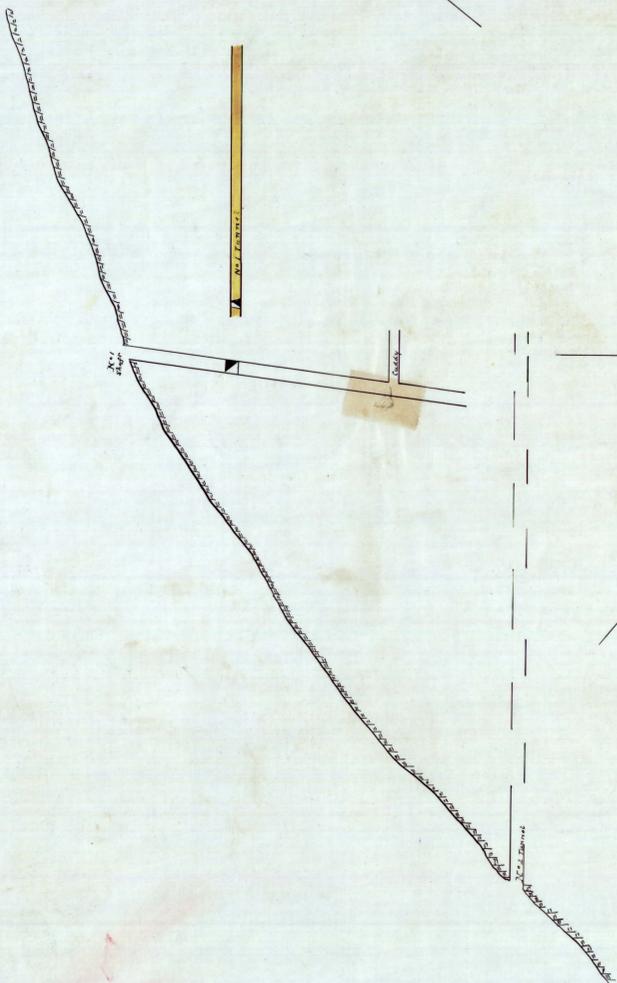

202-03



500

500