

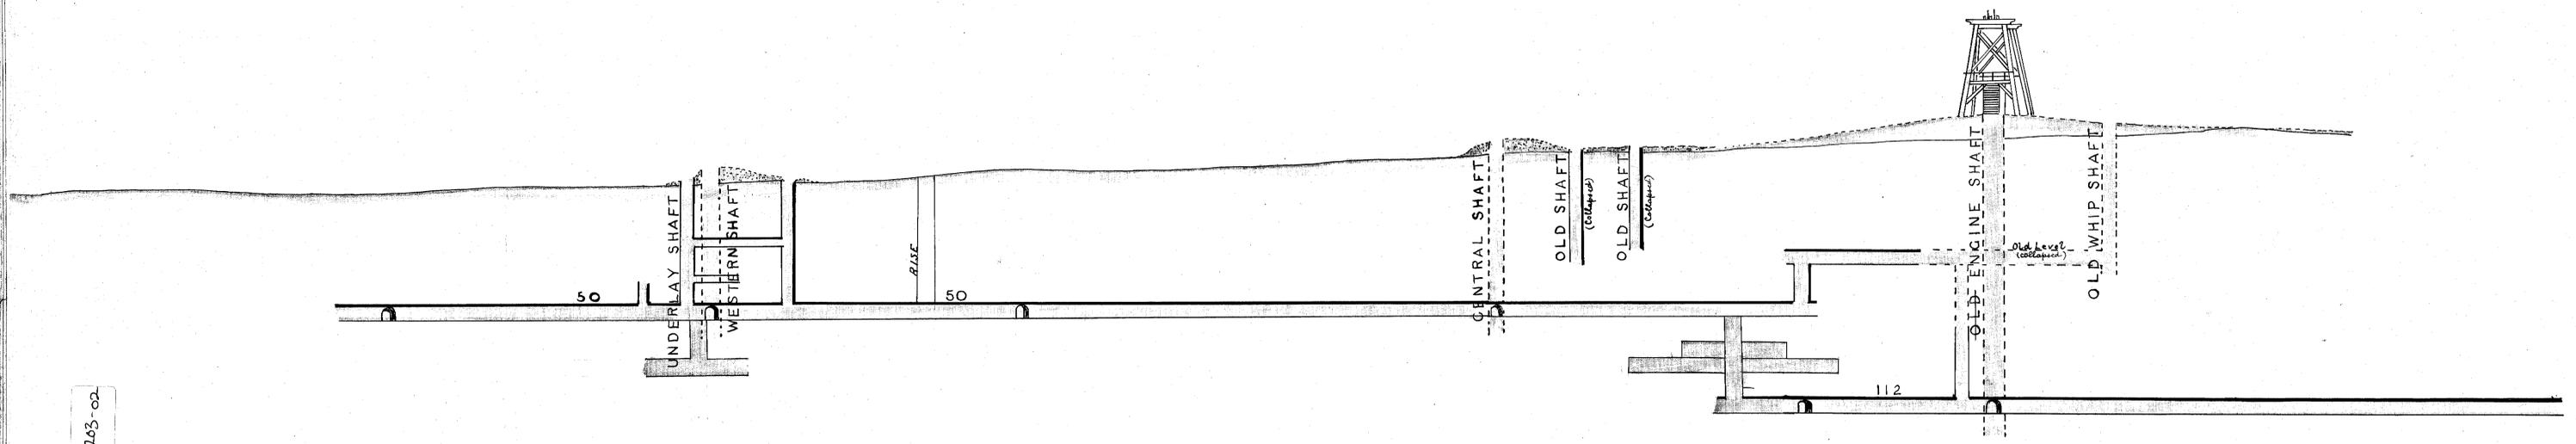


203-02

— THE MAJOR GOLD MINE —  
 — LONGITUDINAL SECTION —  
 of the  
 — MAIN LODE —

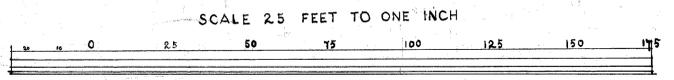

745-02

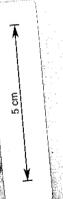

REGISTRAR OF MINES  
 24th March  
 1896  
 TAUNTON

The old shafts are inaccessible and their depths are approximately shown from information furnished by persons who were  
 Richard Francis A.M.I.C.E.  
 January 1896

1/2/97  
 TAUNTON

Entered  
 A. J. Miles  
 Registered Surveyor  
 January '97