
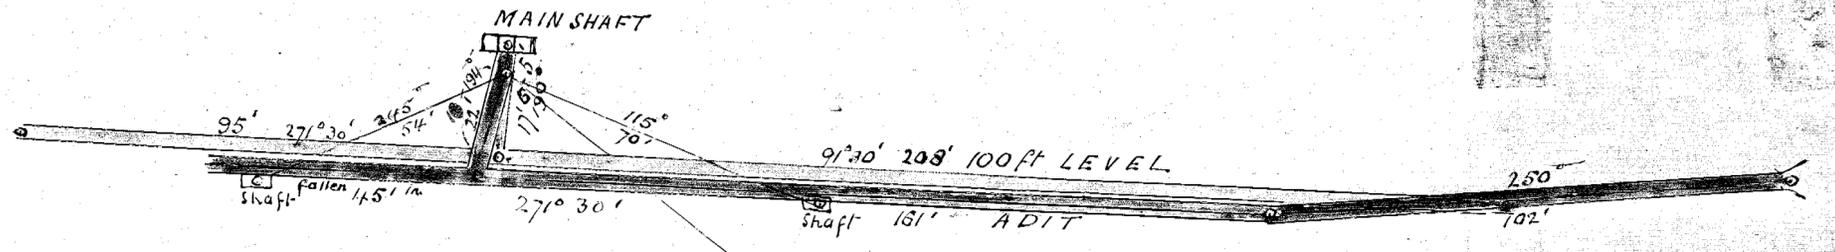


206-01

# NEW BURNS CREEK G. M.

Scale 25ft to 1 inch

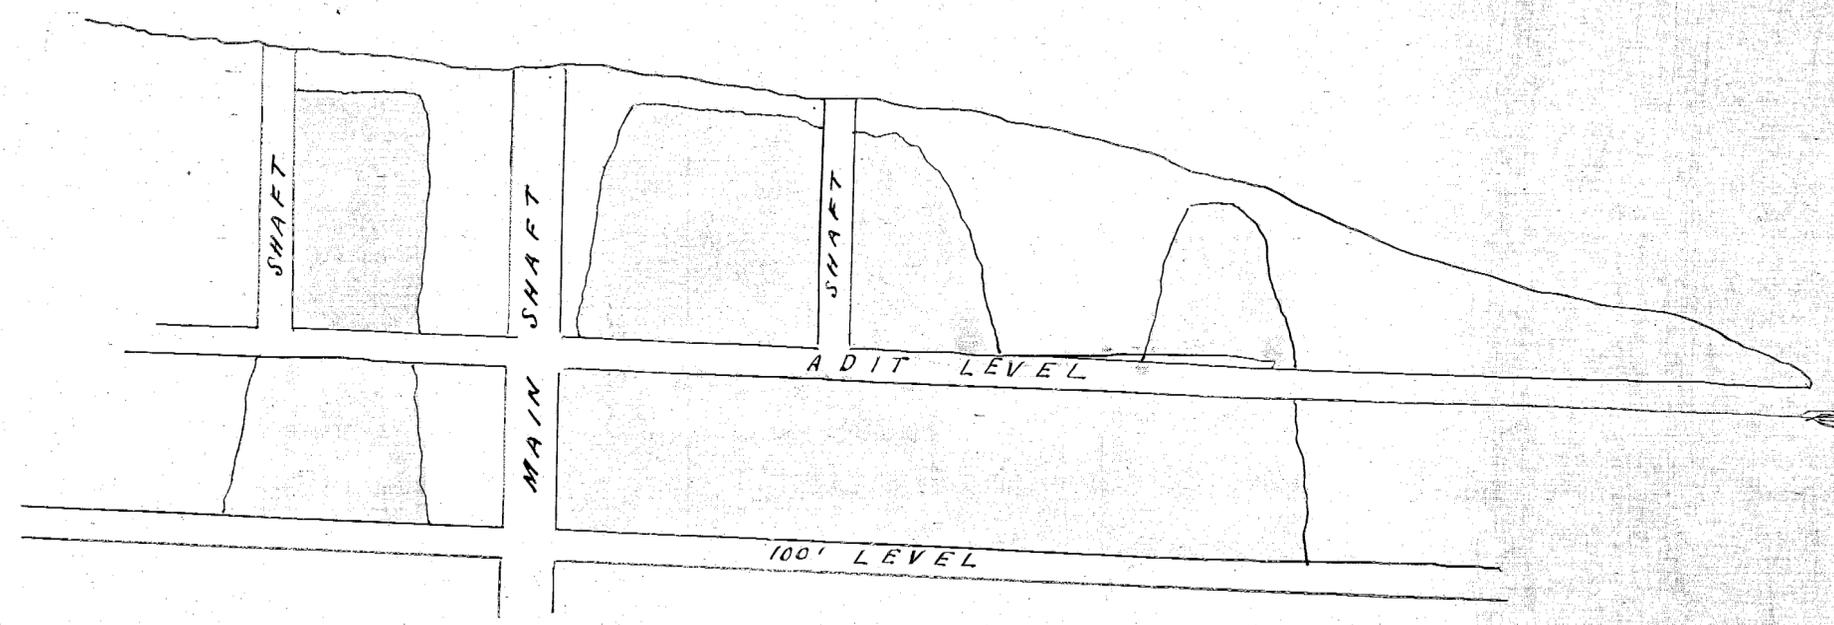

*Corrected  
copy of survey of New Burns  
Creek G. M. Survey with  
Shoshone party with  
Company. July 1907  
C. Dingle  
Geo. A. Turner*



*See general map*