


207-01

AMALGAMATED ENTERPRISE & GEM SECTIONS

Scale 50ft to 1 inch Horizontal
" 40 " " " Vertical

Workings in Blue by original Company
" " Red of present date

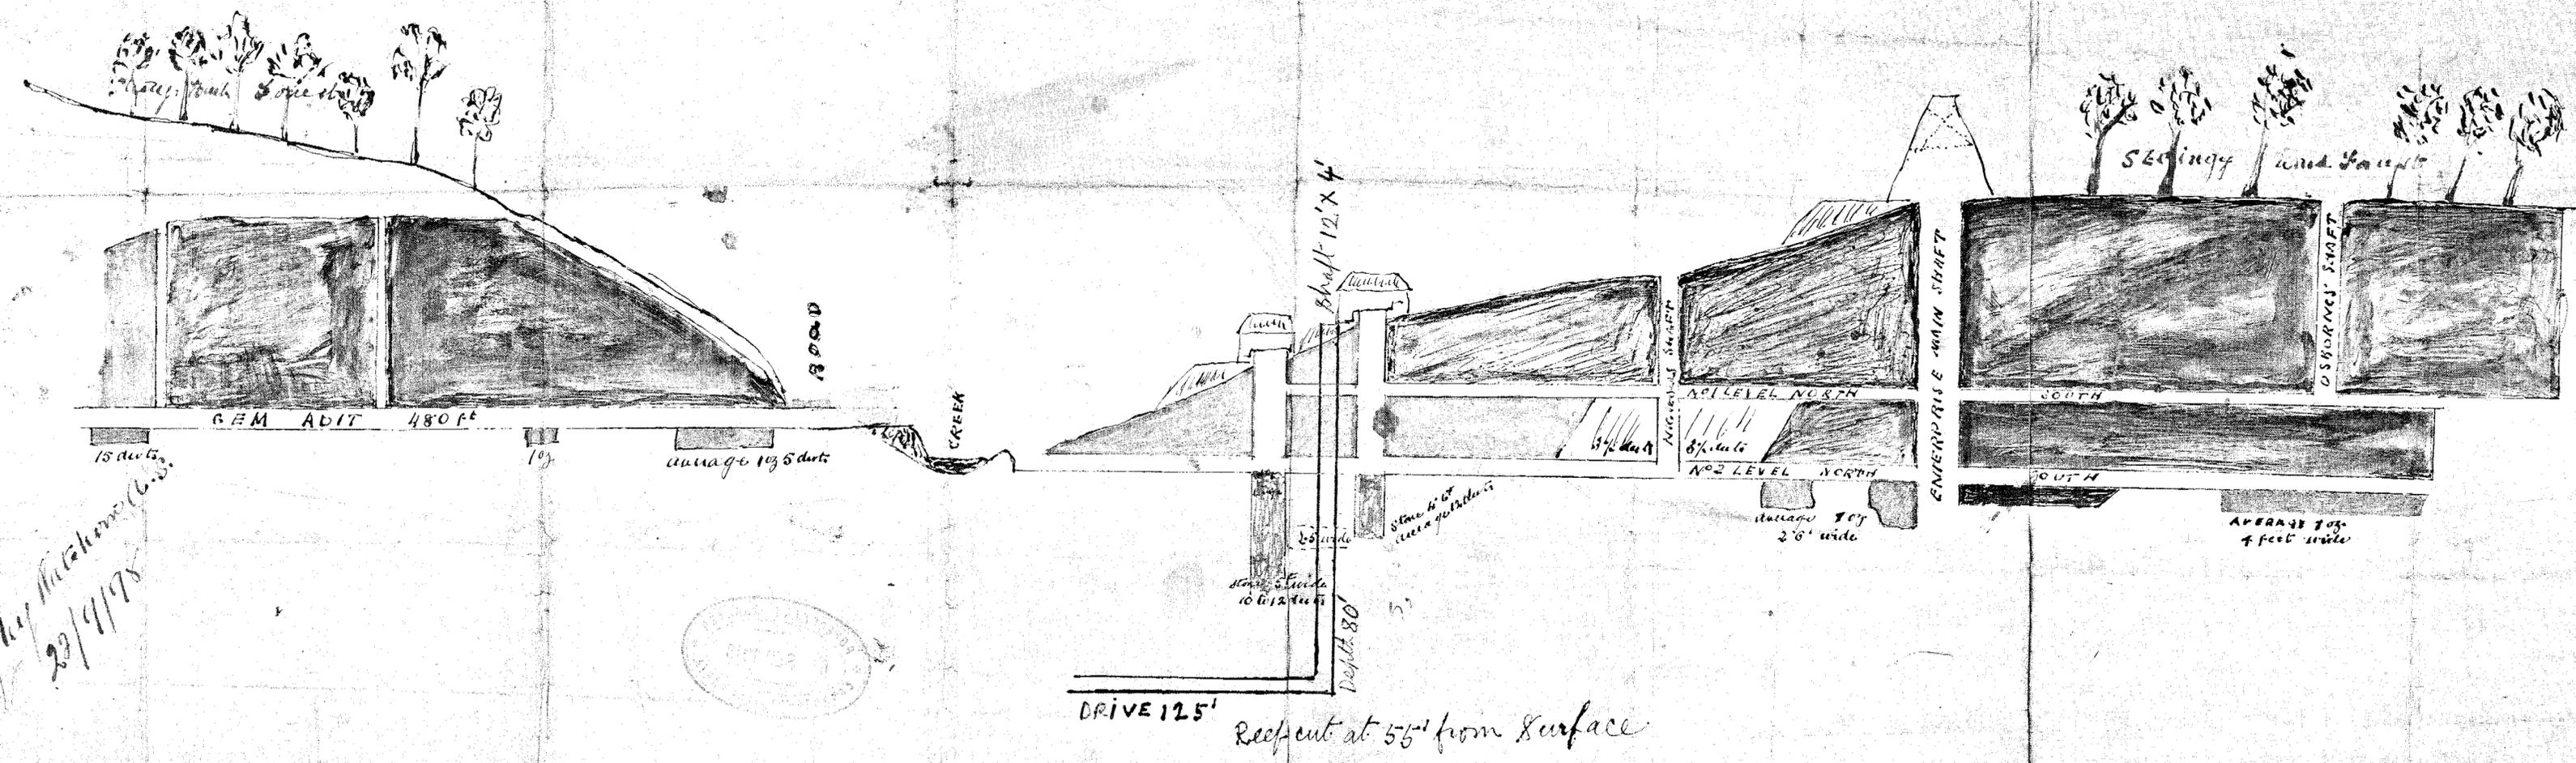

Copy of plan
Bep
C. King by Michigan C.S.
22/9/98

