
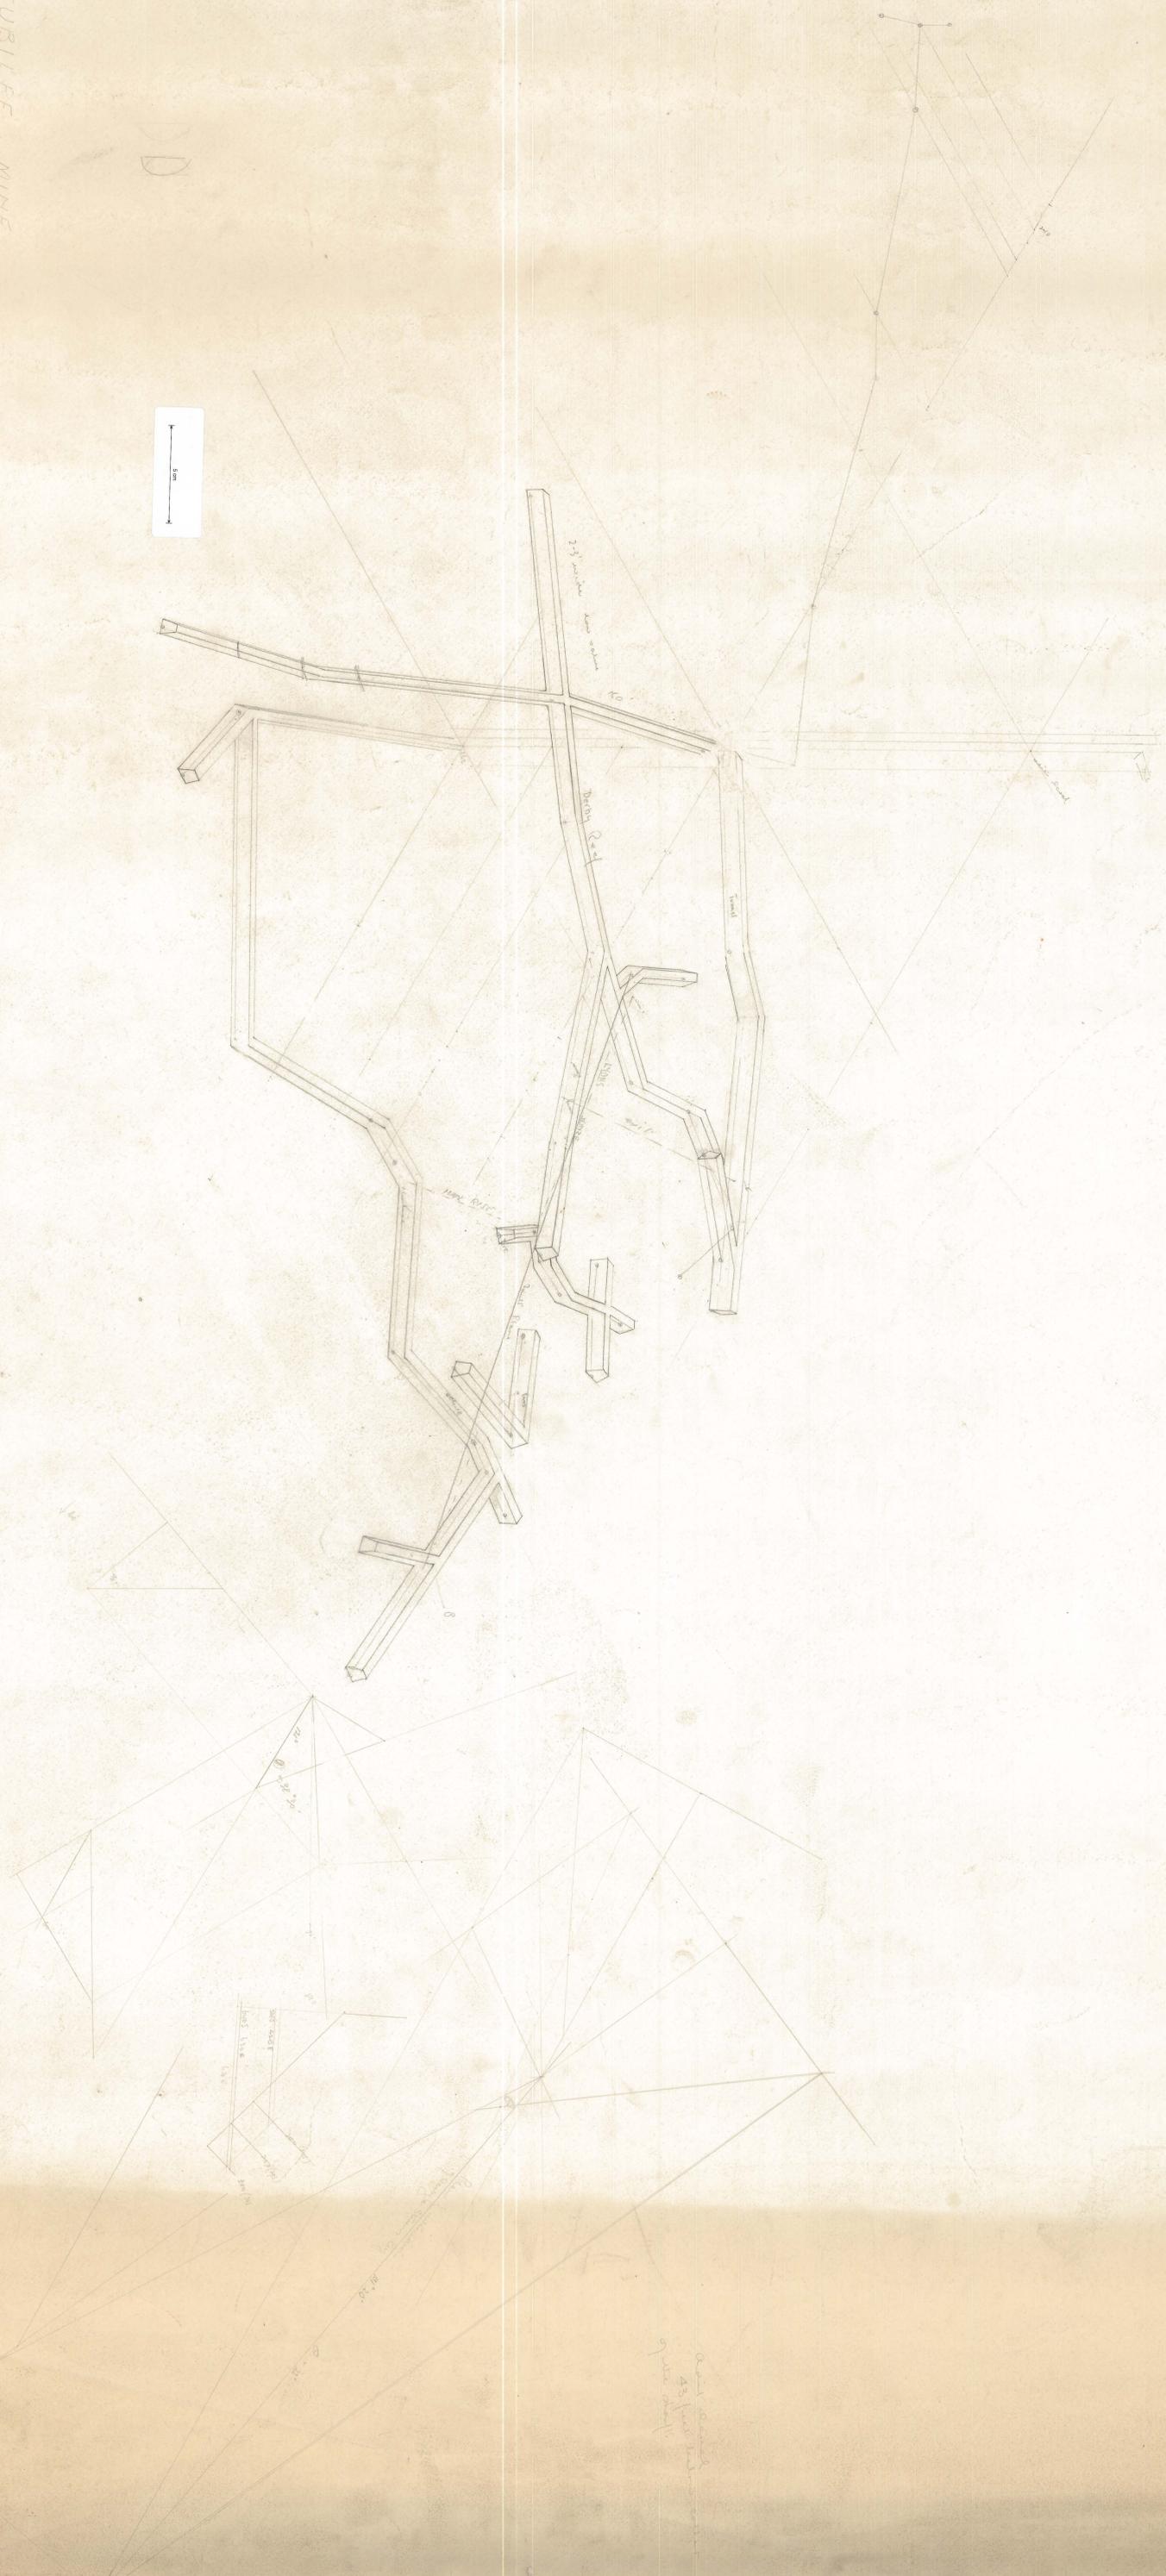


841A/40
JUBILEE MINE
Scale 1" = 10'

DD

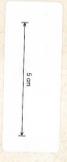

Quartz veins
43 feet thick
quite abundant