



CROSS SECTION

ALONG LINE AB.

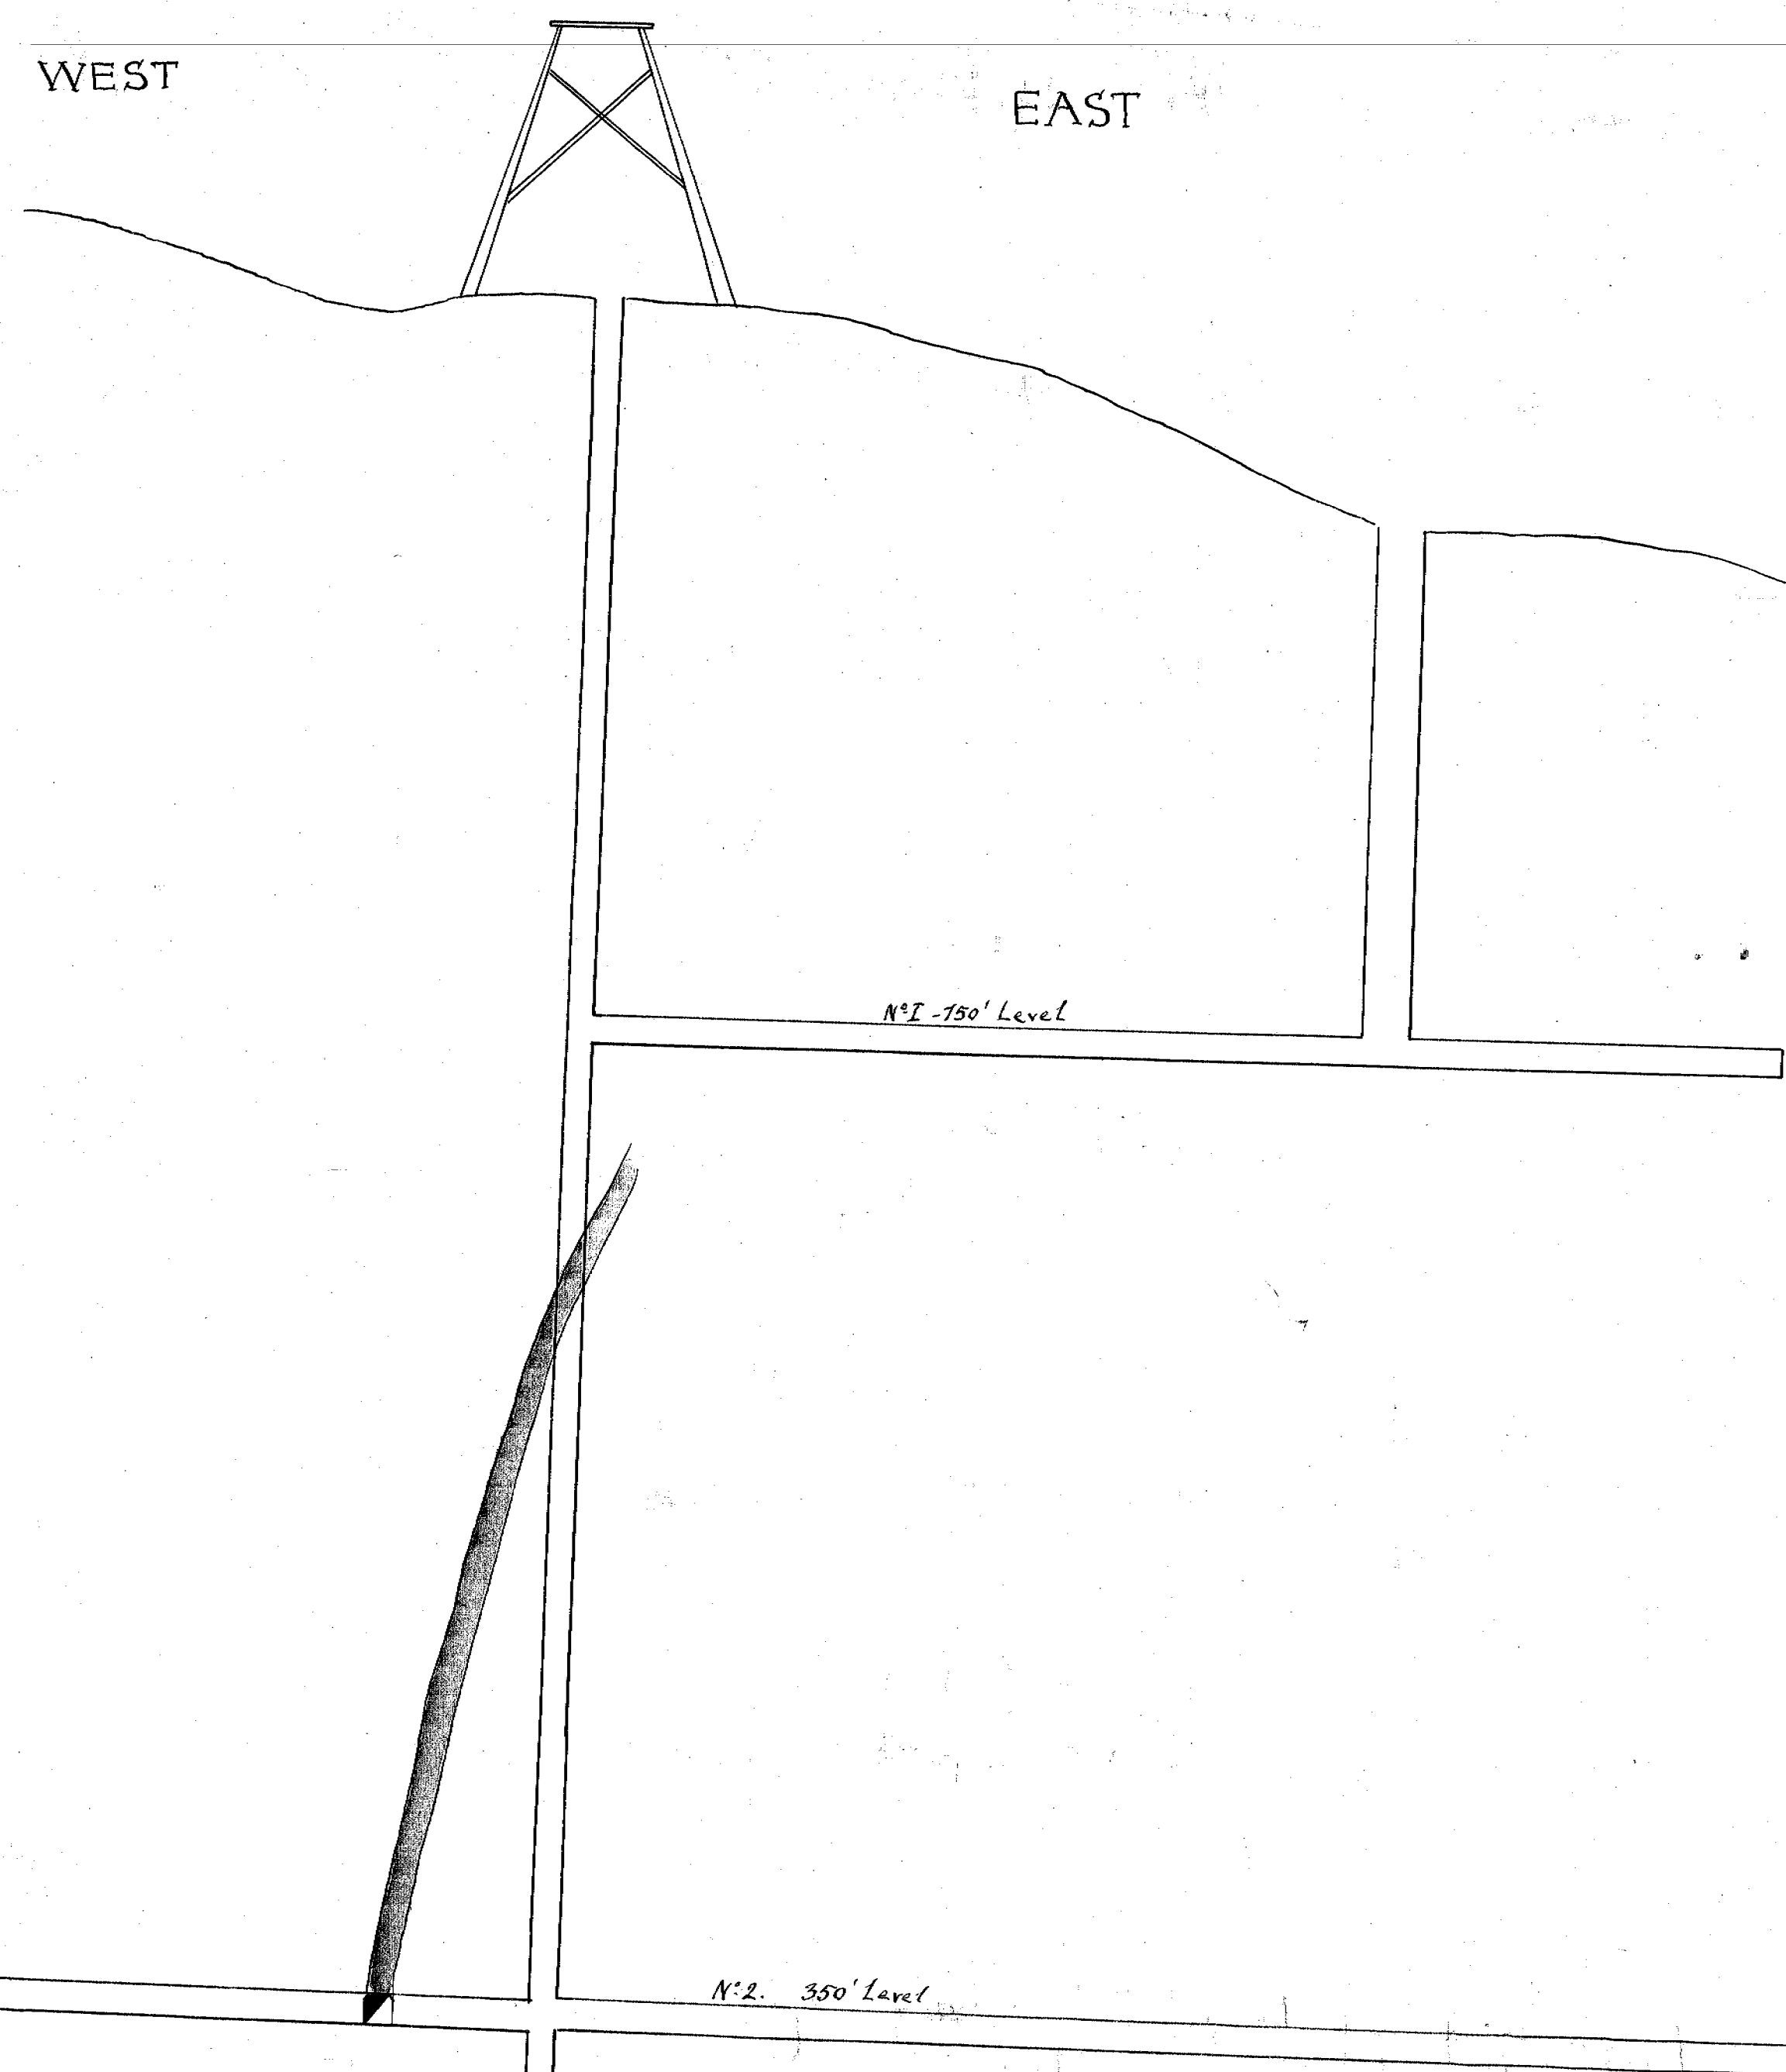

LONGITUDINAL SECTION

ALONG LINE CD

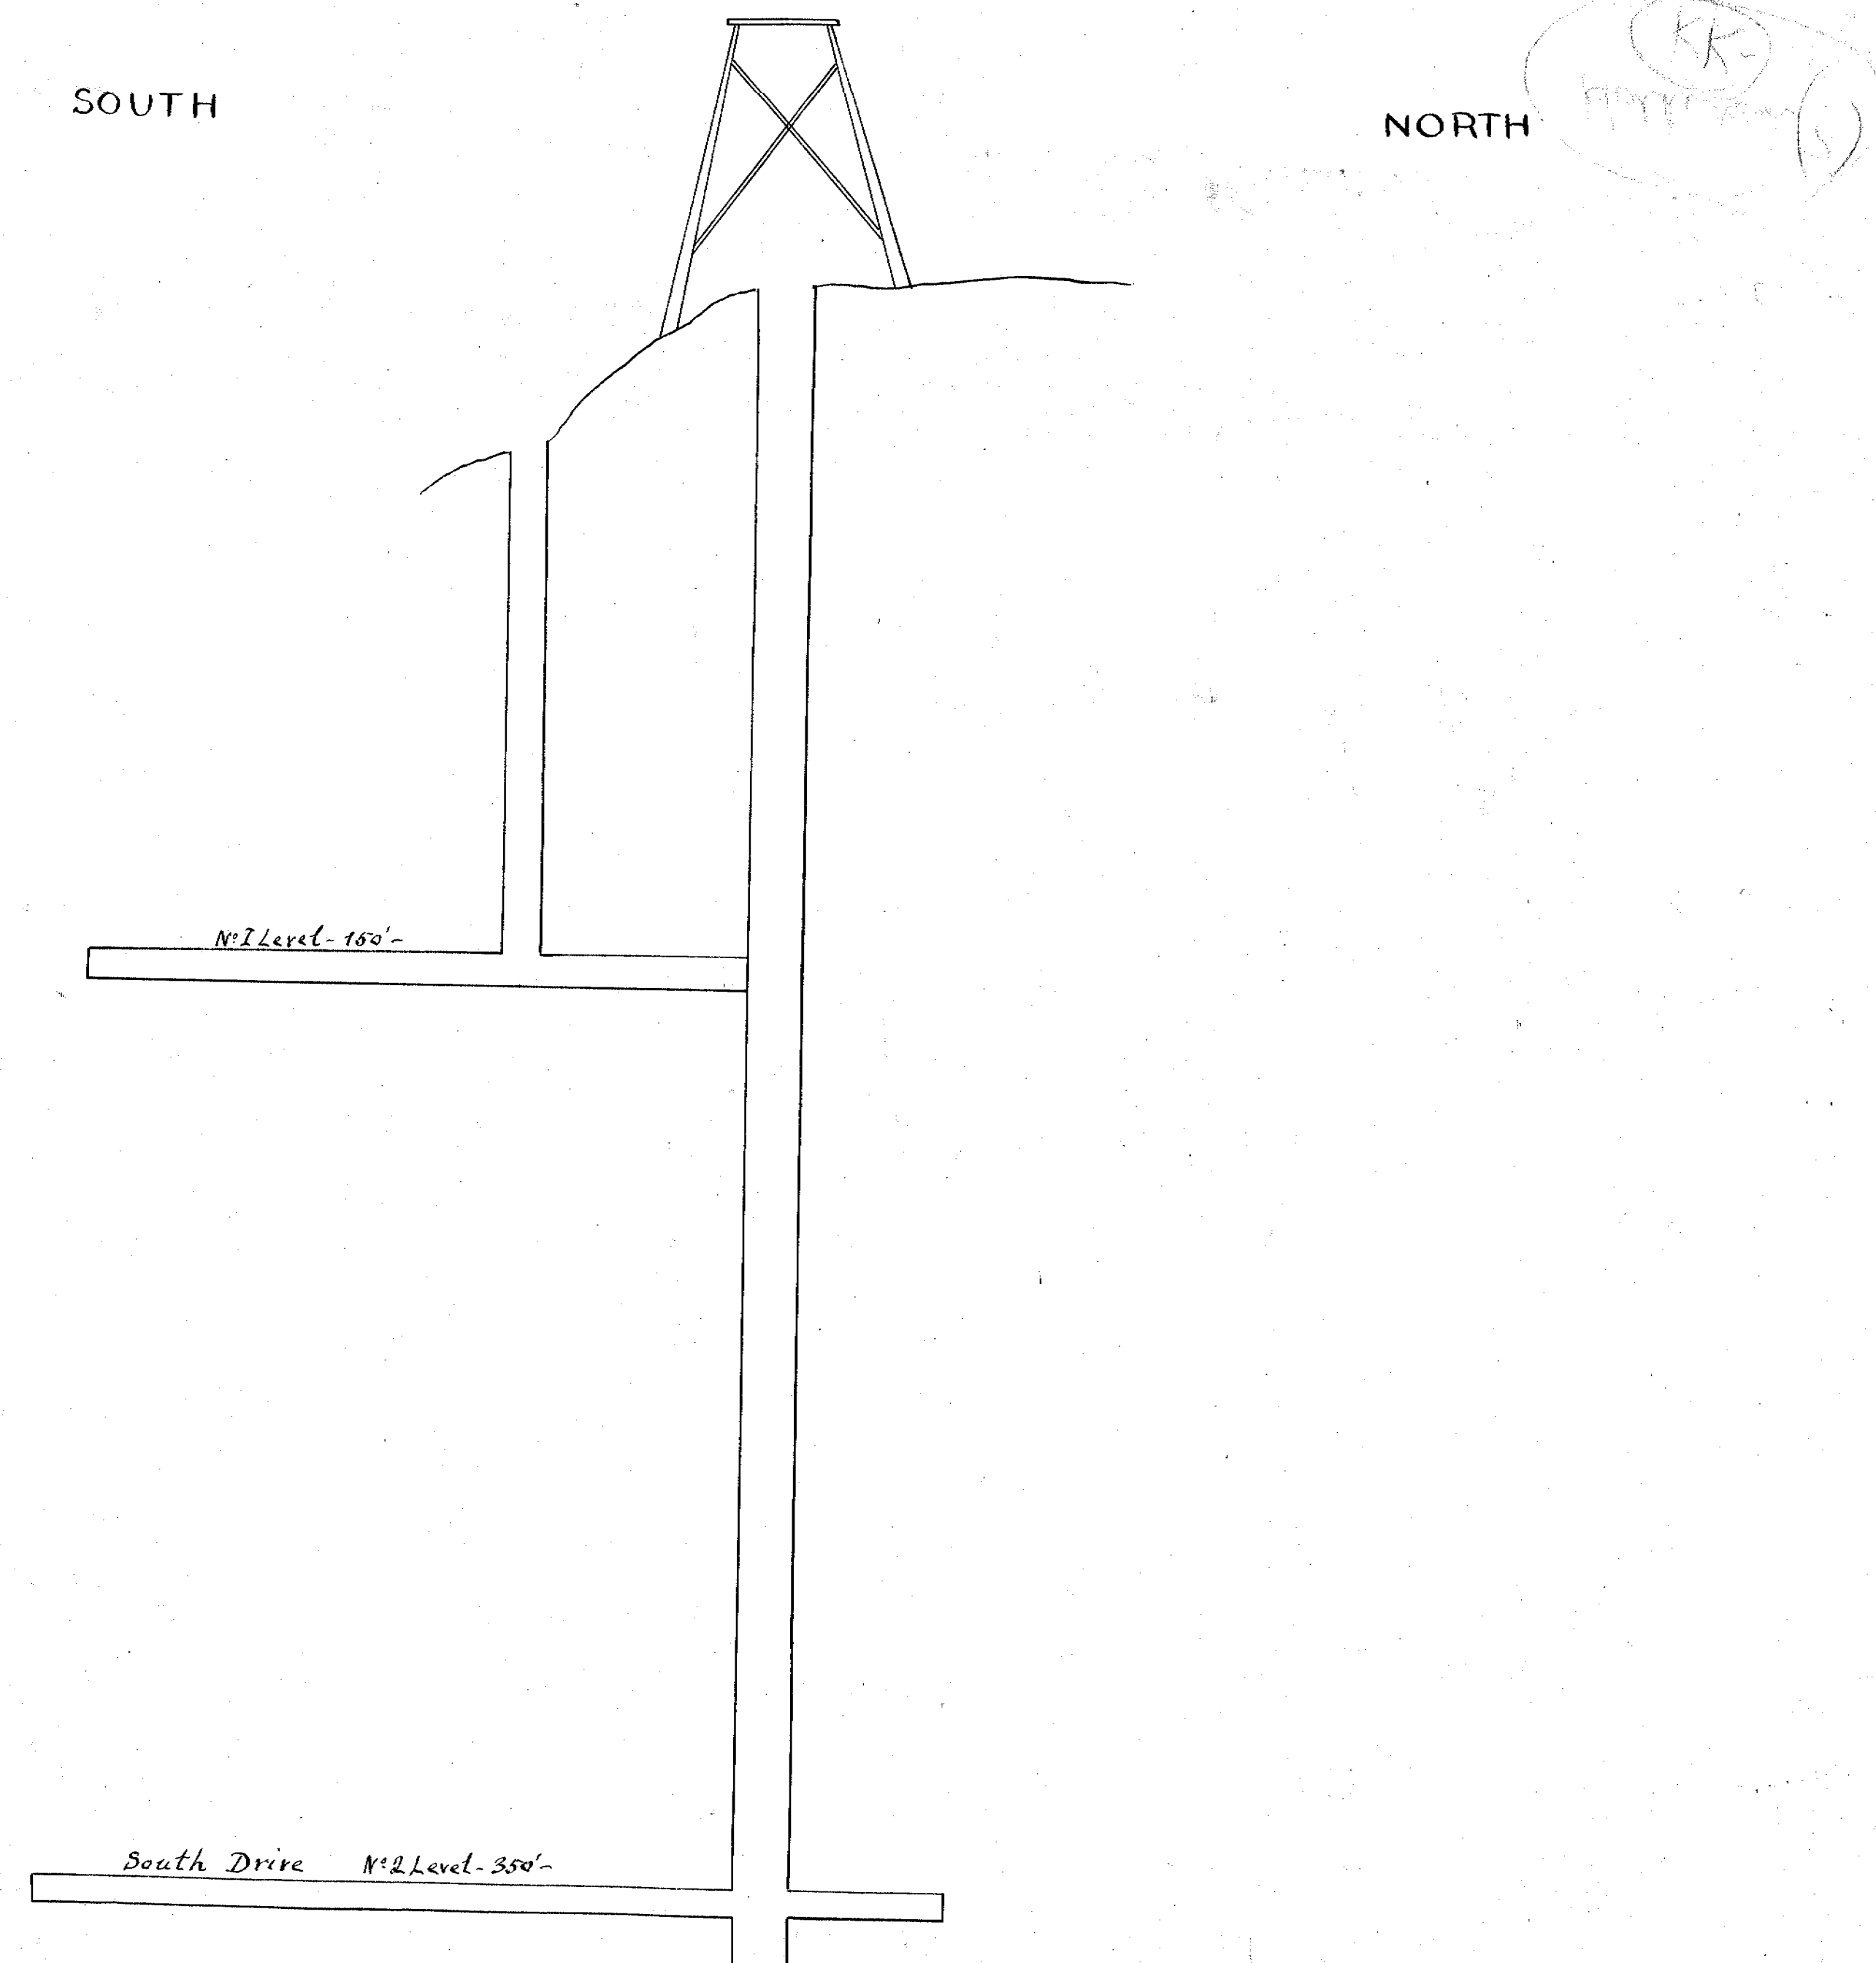

0 10 20 30 40 50 60 70 80 90 100 Feet

1 JAN 1898
TORONTO