
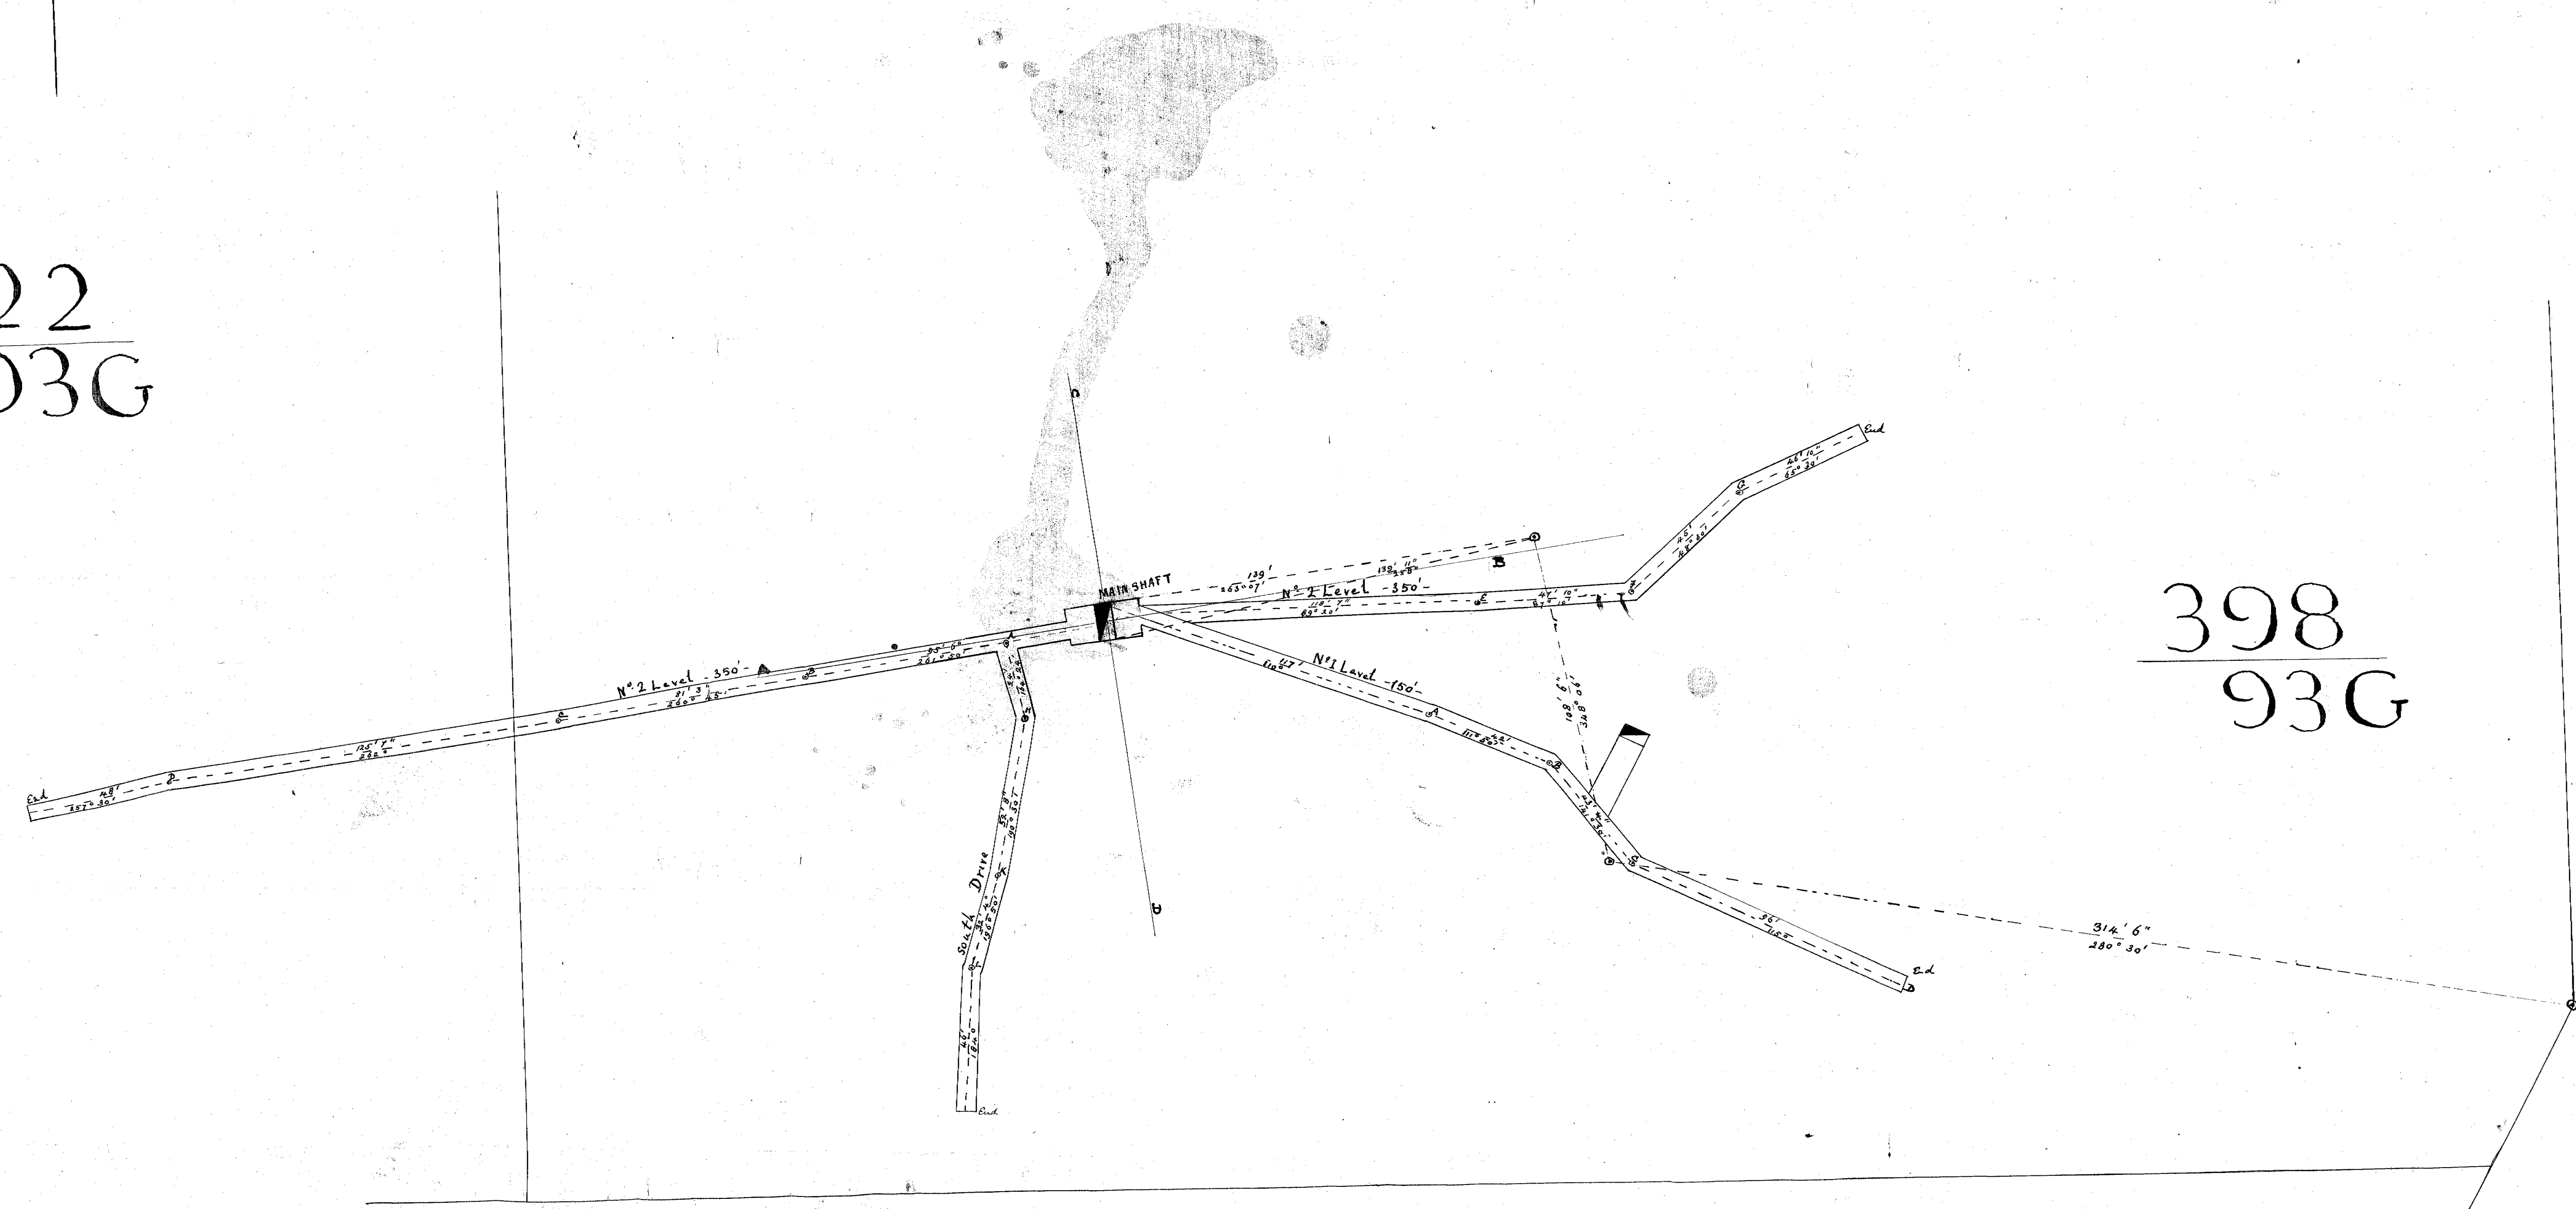


HATHERTON MINE

PLAN

422
93G

398
93G

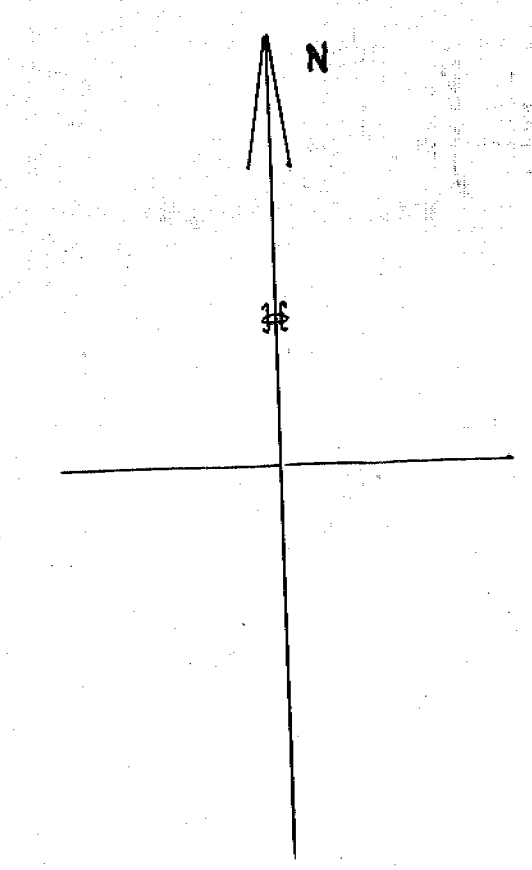

Surveyed and drawn by Arthur Robinson R.S.M. and G.R. Jones

Instrument Used Theodolite.

