

PLAN
AND
SECTIONS

of the

RIO TINTO MINING CO:




UNDERGROUND WORKS

Scale 50 Feet to 1 Inch.

1898

I, David Jones, Surveyor of Tasmania, hereby declare this plan to be sufficiently correct for the purposes of the Mining Act, 1893.

David Jones
District Surveyor,
Tasmania.

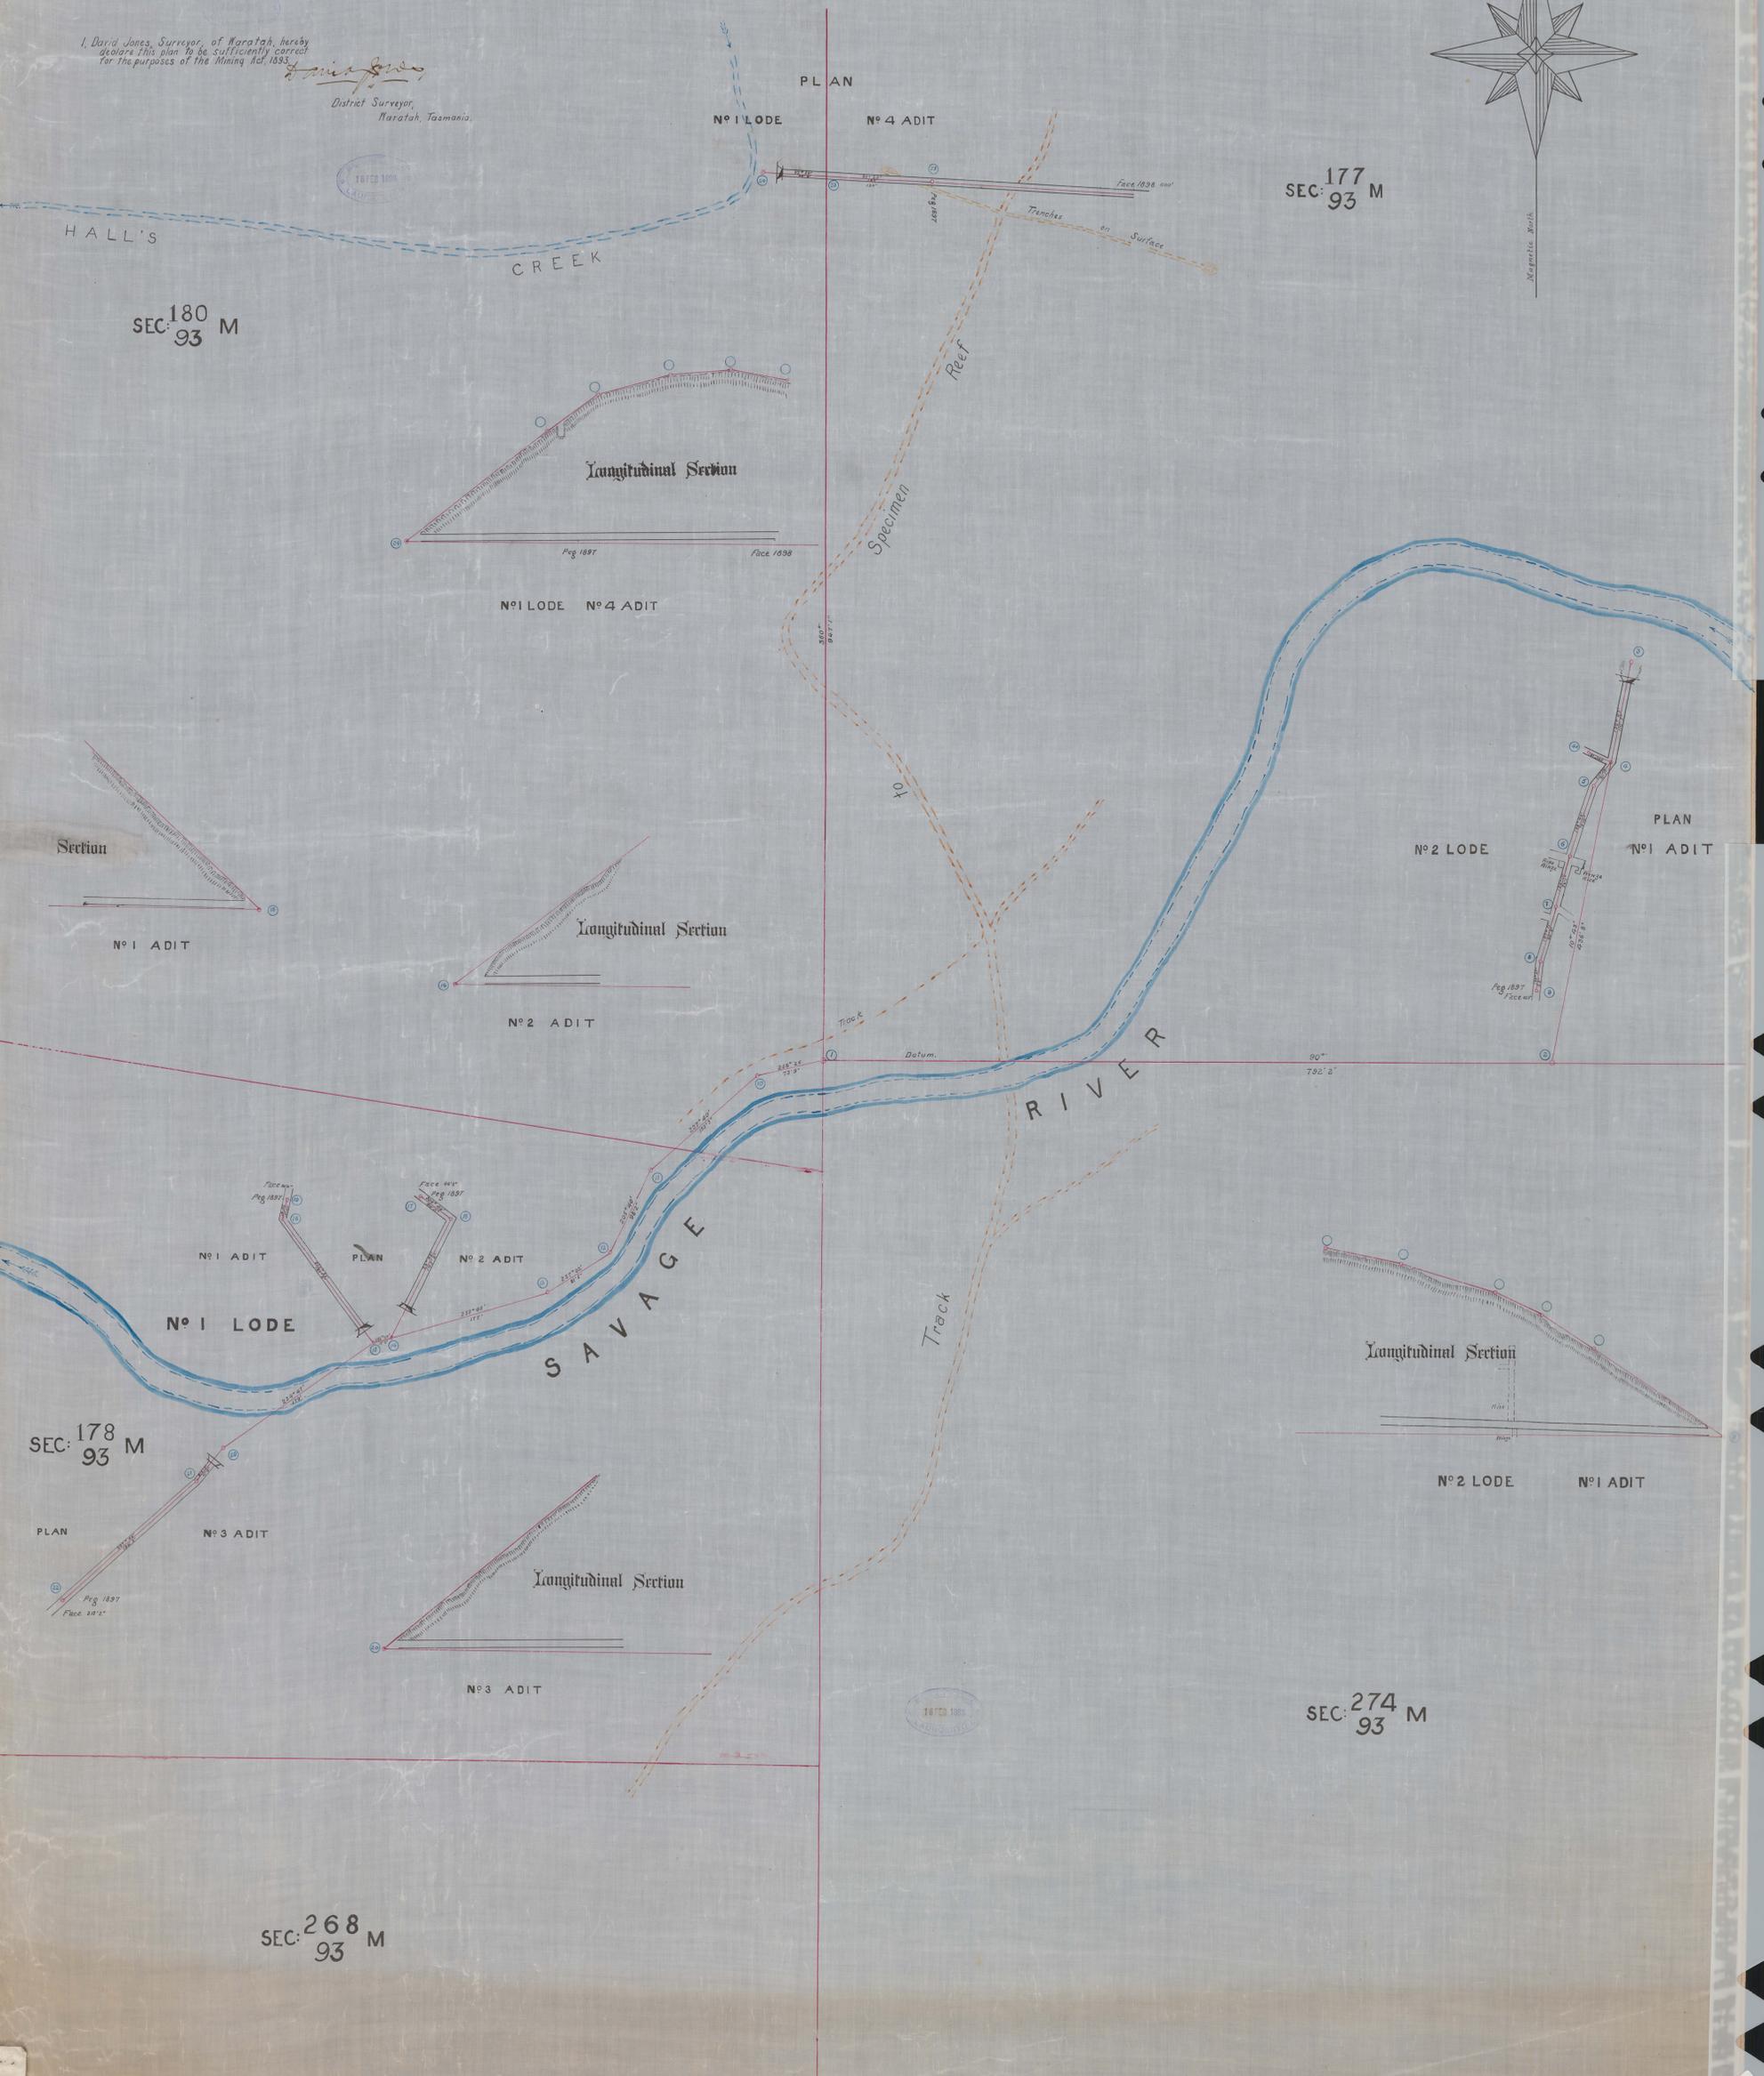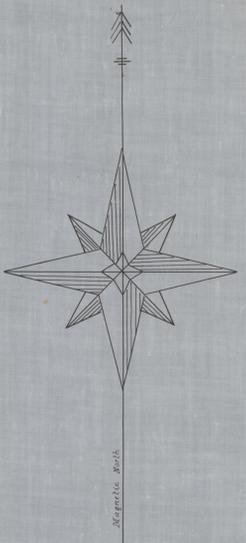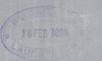

SEC: 180
93 M

SEC: 177
93 M

SEC: 178
93 M

SEC: 274
93 M

SEC: 268
93 M

