

212-01

PLAN

M^CKIMMIE SILVER & NICKEL



MINING CO^Y N.L.

306

JANUARY 1897

Scale 40 feet to an inch.

305

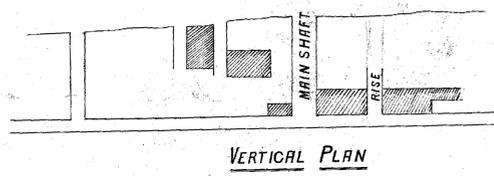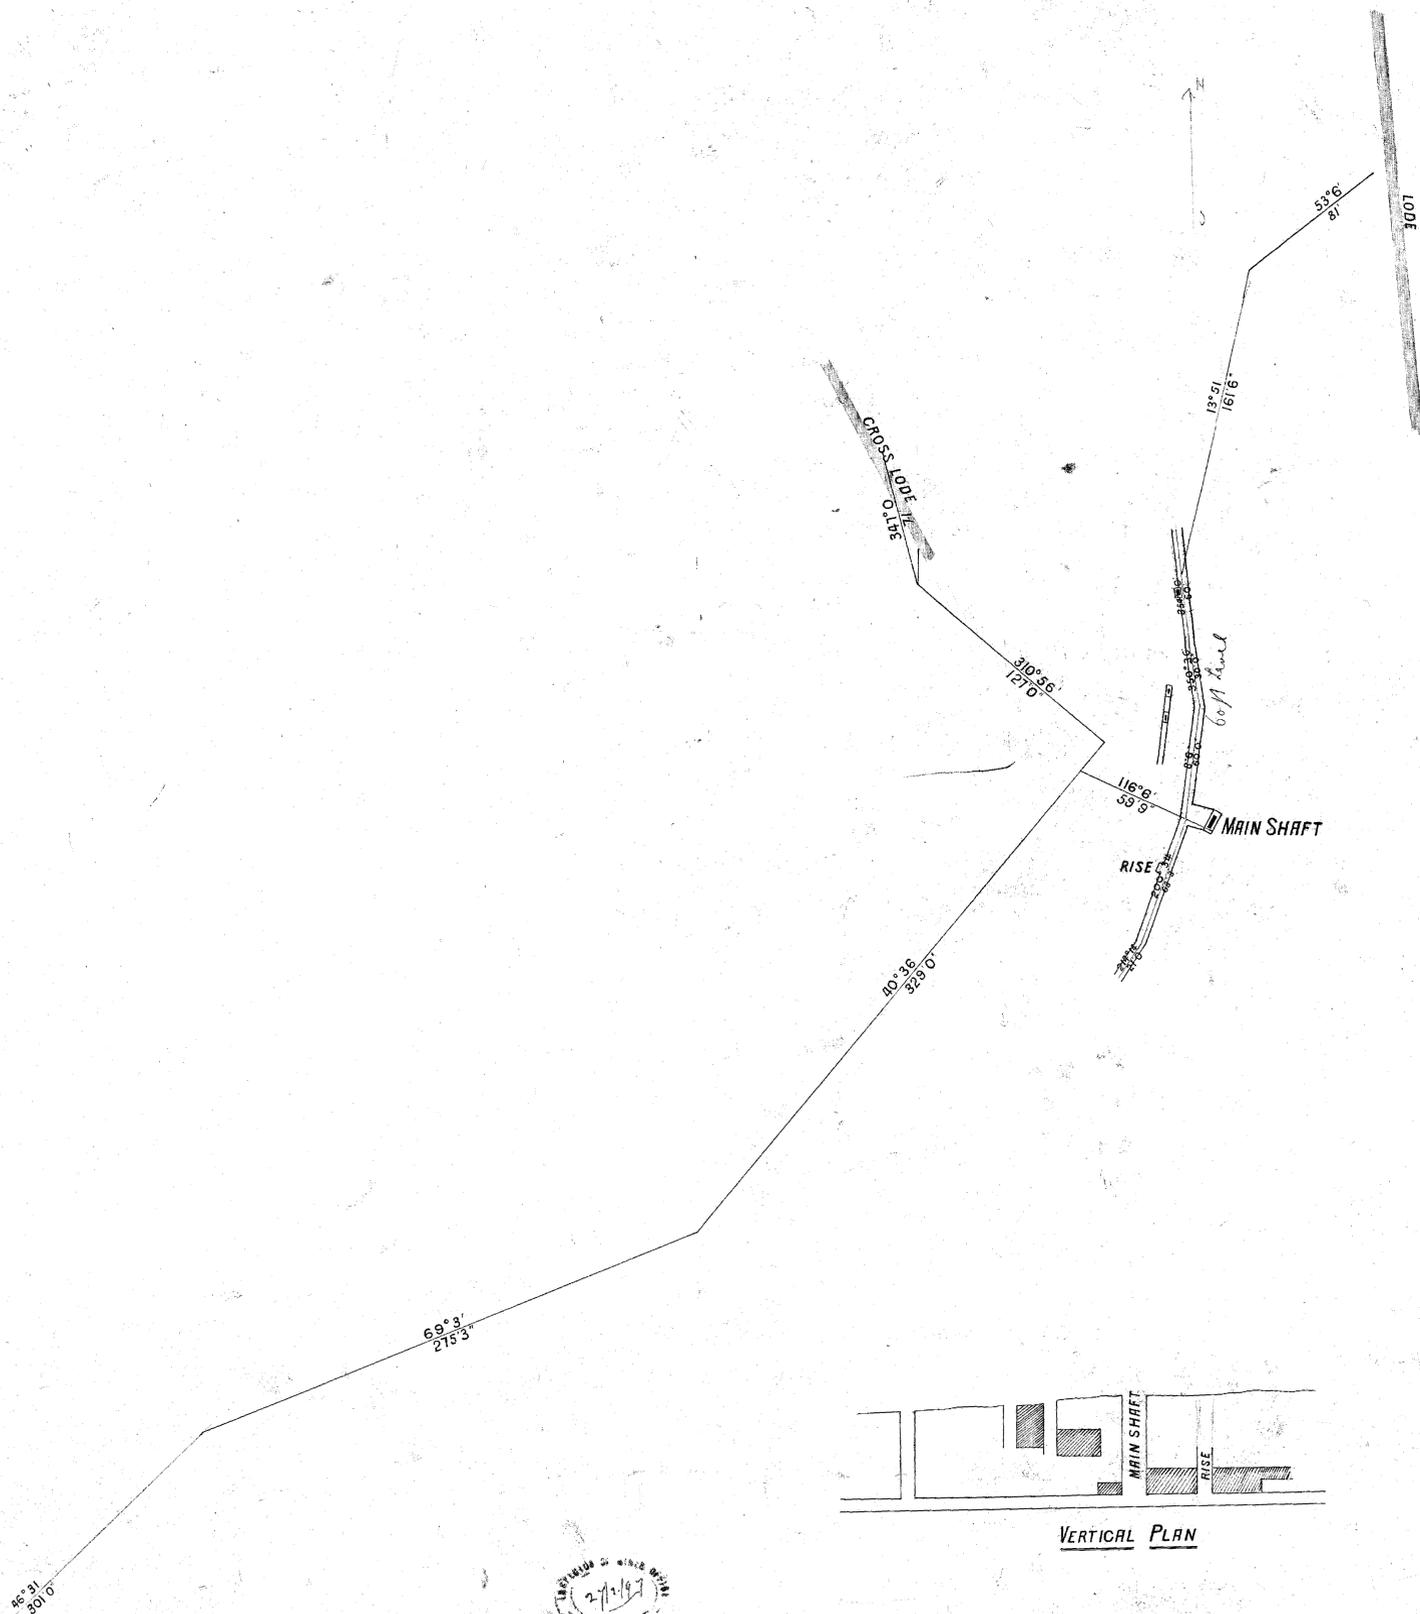

VERTICAL PLAN

