
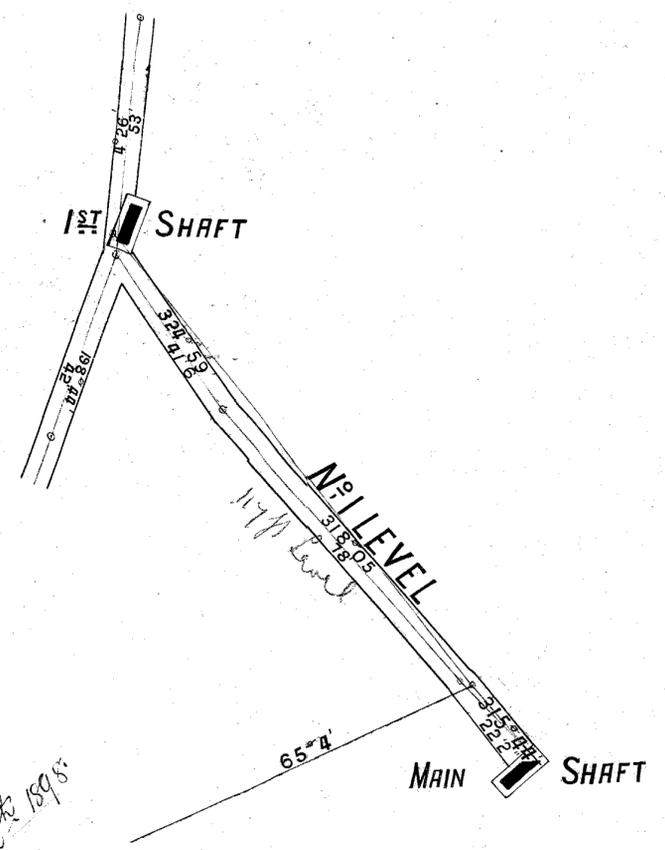
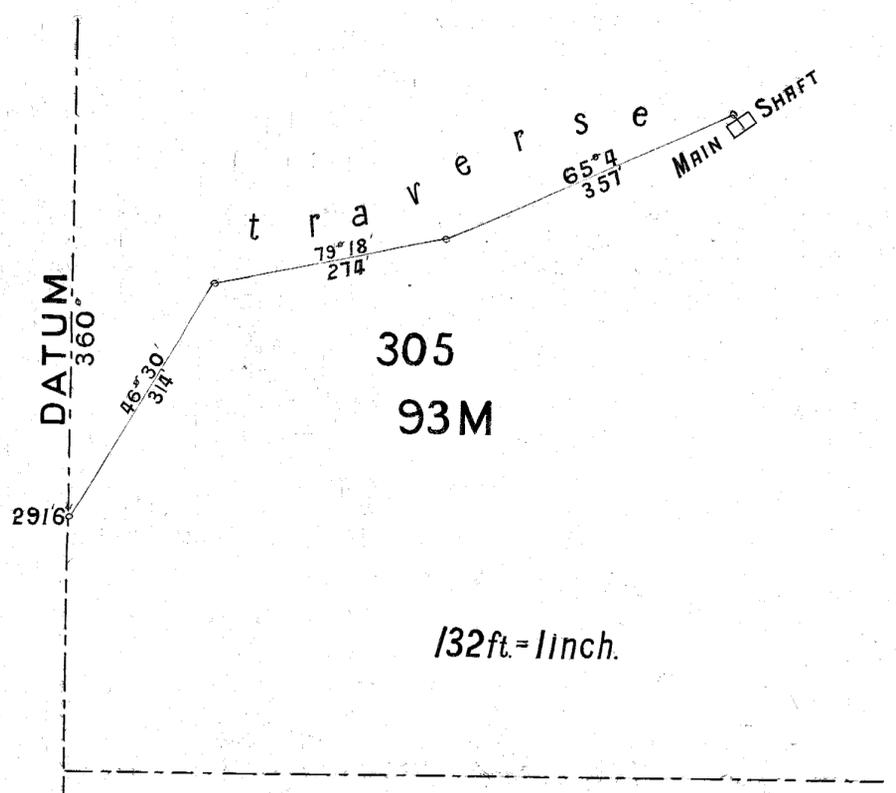


212-02

PLAN

M^C KIMMIE S. & N.M^G C^O N.L.

Scale 25 feet to an inch.

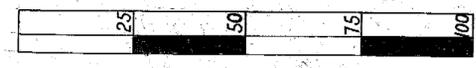

*Mathew Moore
 Fechner
 March 12th 1895*