



# BONANZA PROP<sup>RTY</sup> G.M.

Scale 40ft to 1inch

Showing work done to March 1909. Survey partly with theodolite & compass where theodolite is impracticable.  
C. B. Watson  
Govt. Surveyor  
3. 4. 09

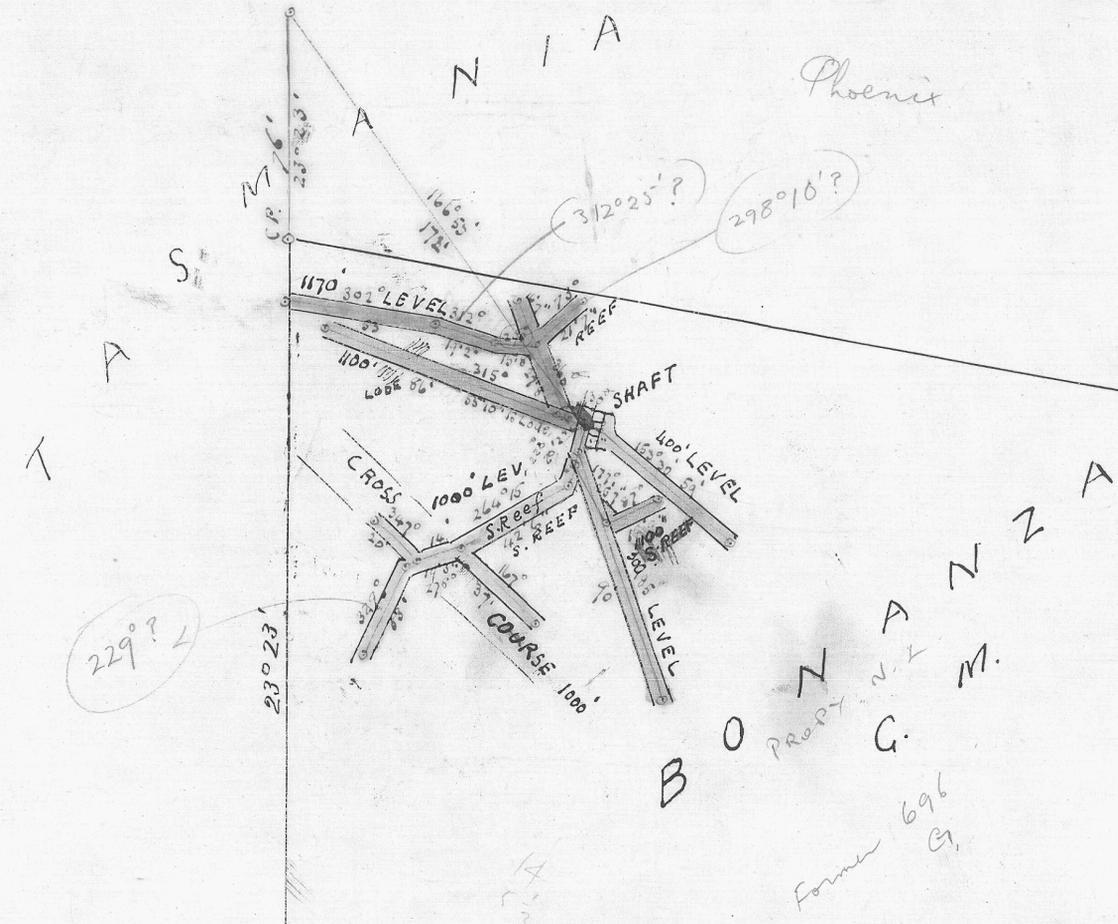

214-02

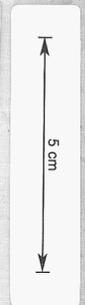

ONSFIELD



214-02