

5 cm


214-03

LEFROY

214-03

COMRADES G.M.

Scale 25ft. to 1 inch.

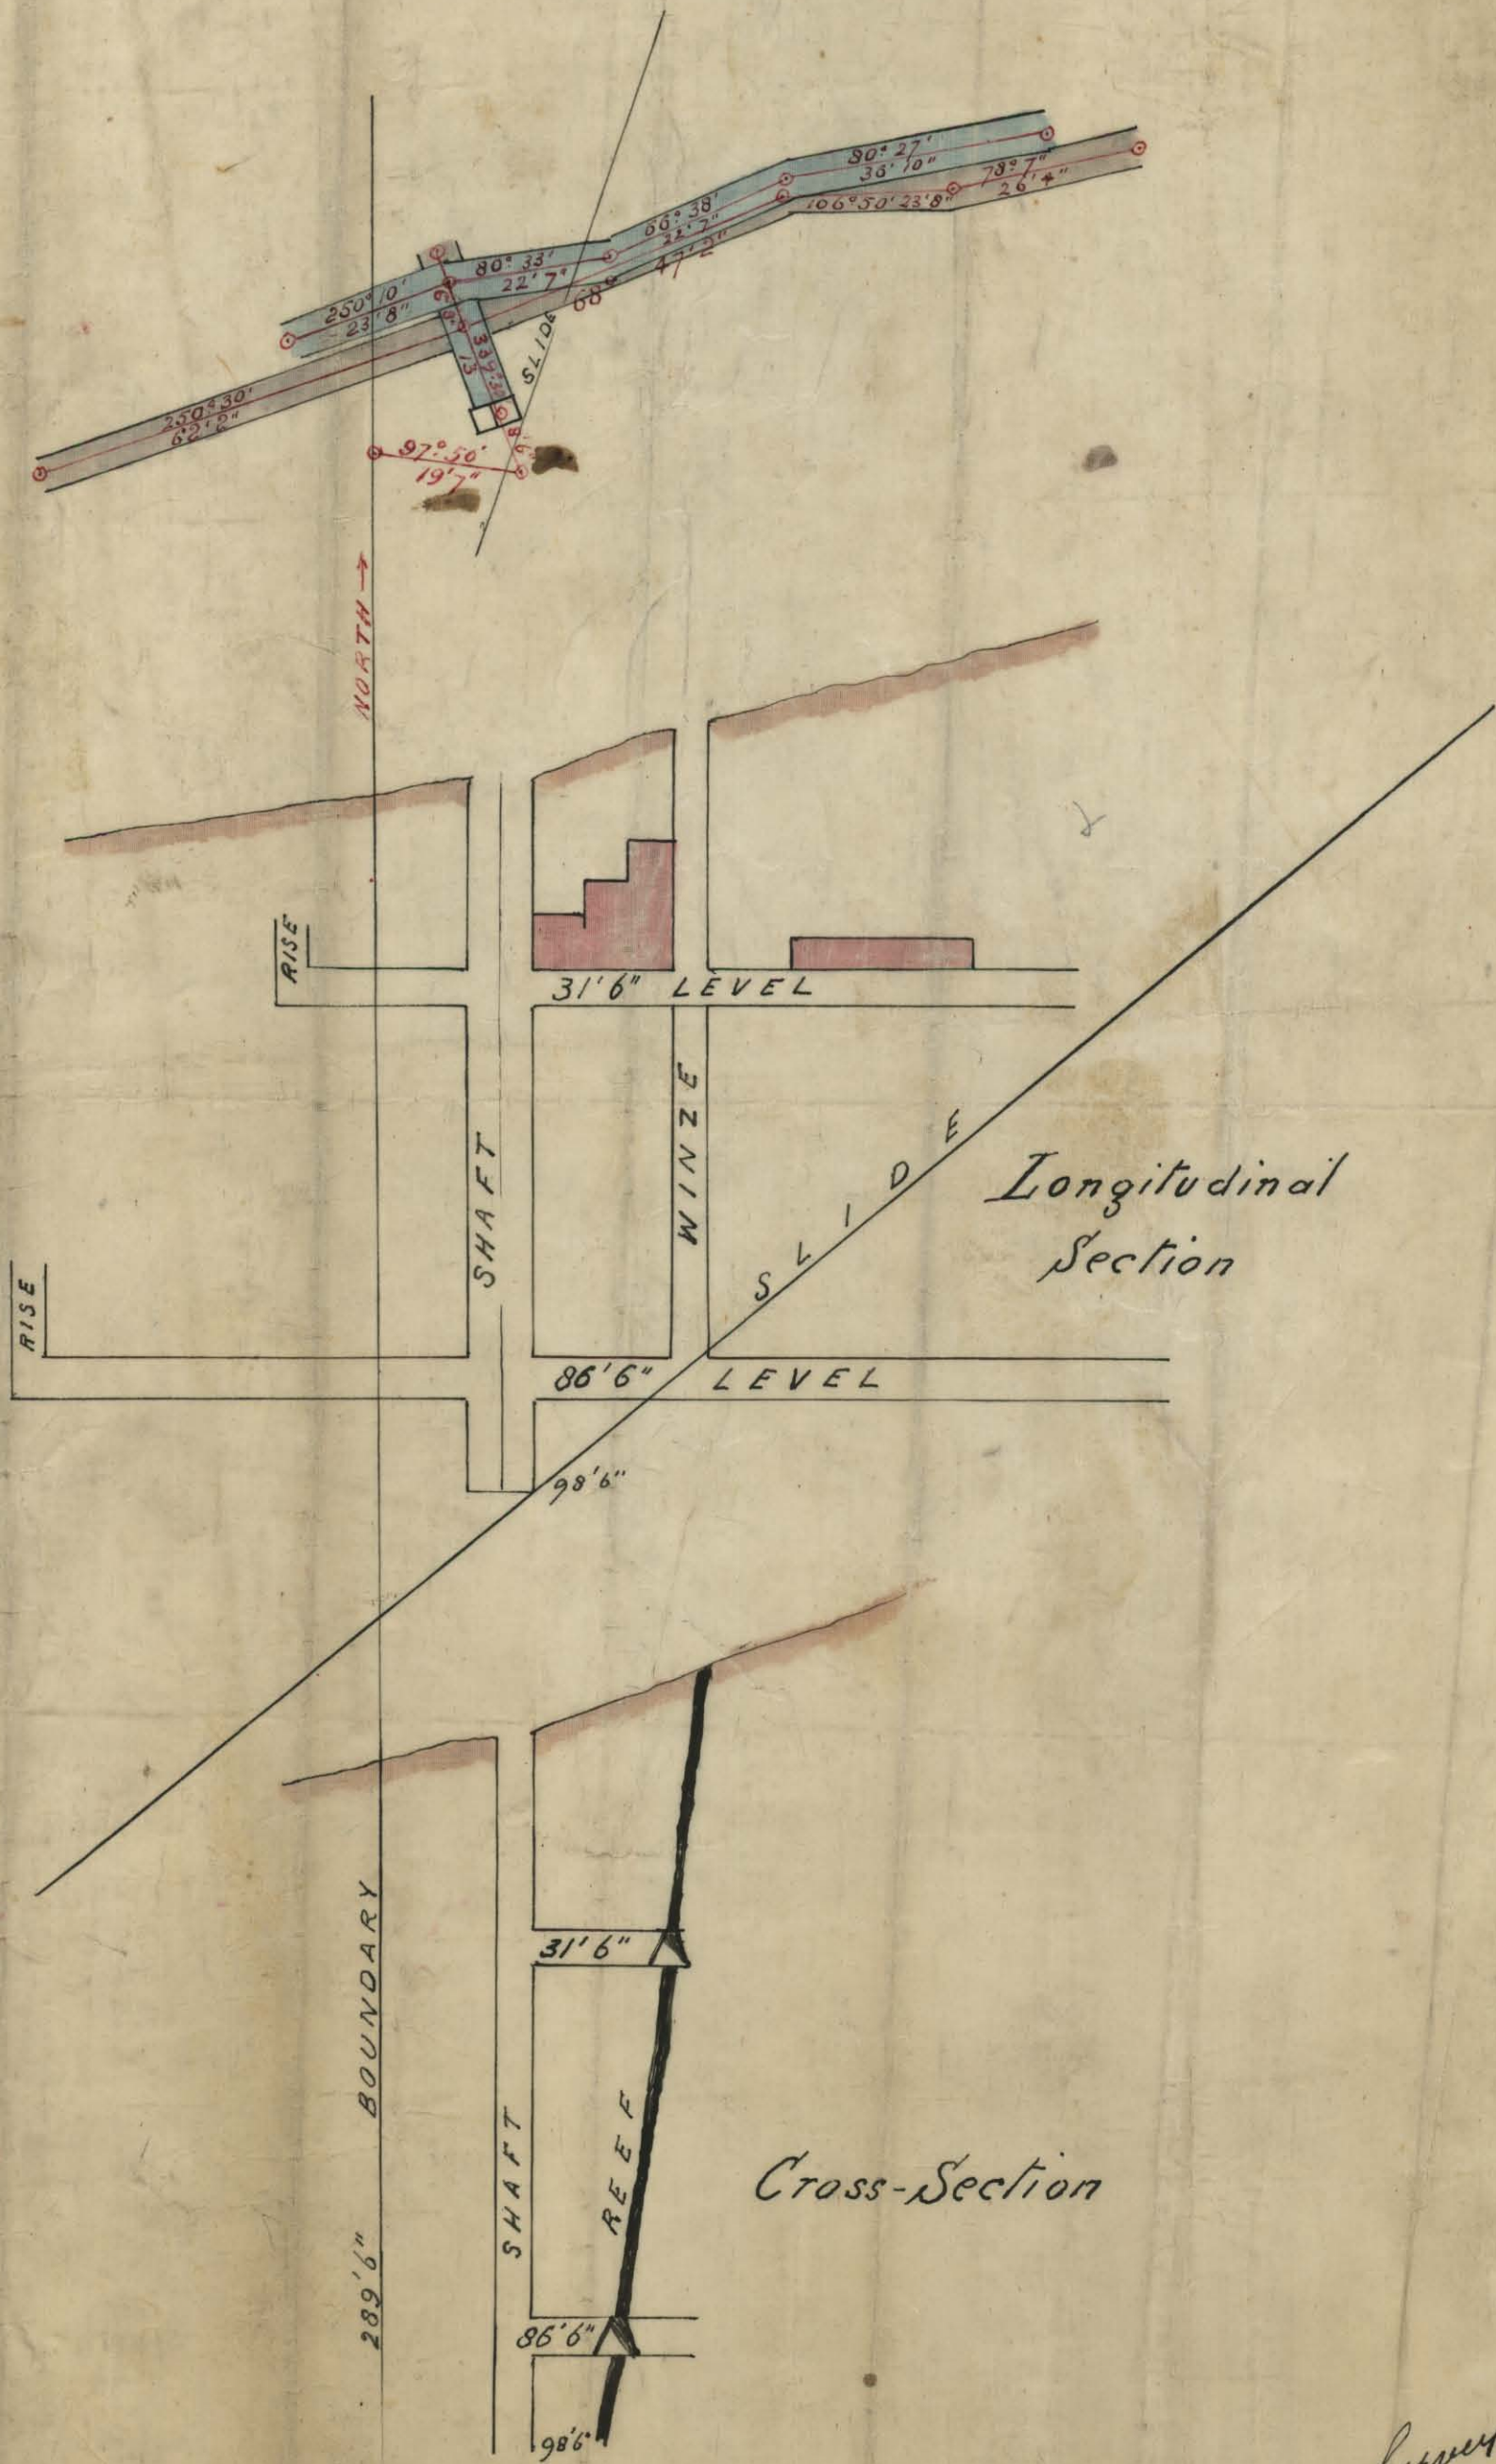

S.W. C. PIN of
Sec 1235
935.

certified correct Theod. Survey.
C. Bingley Watchman.
Auth. Surveyor
14/1/99

415