



215-01

THE McIVOR GOLD MINING COMPANY, NO LIABILITY
LEFROY


5. 67

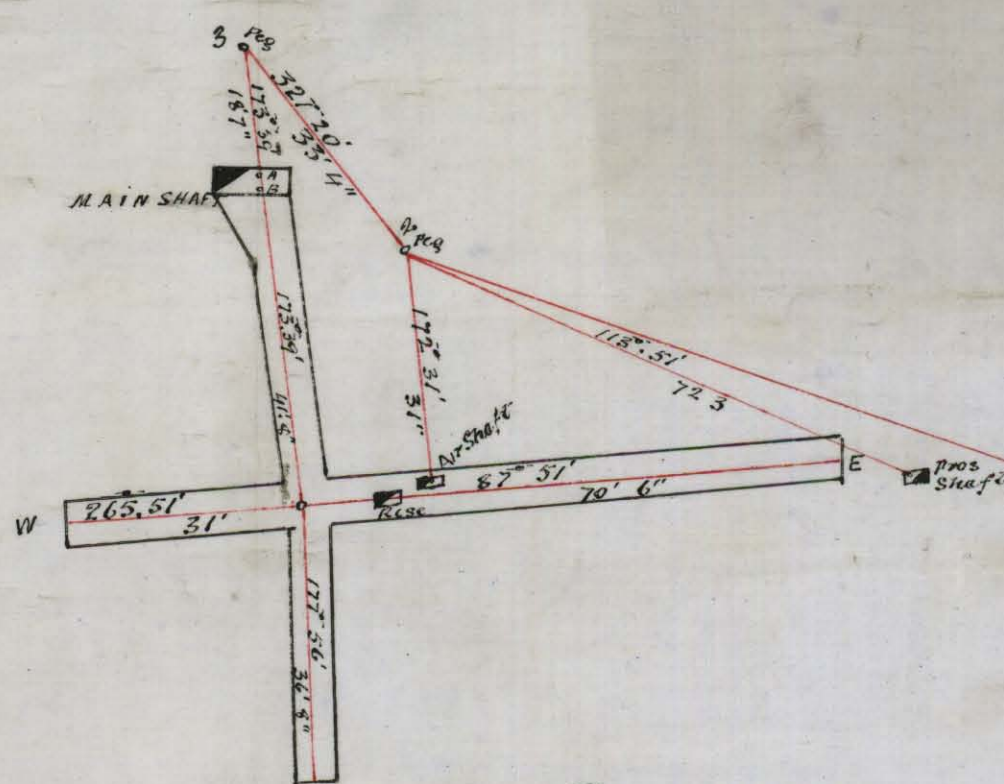

PLAN

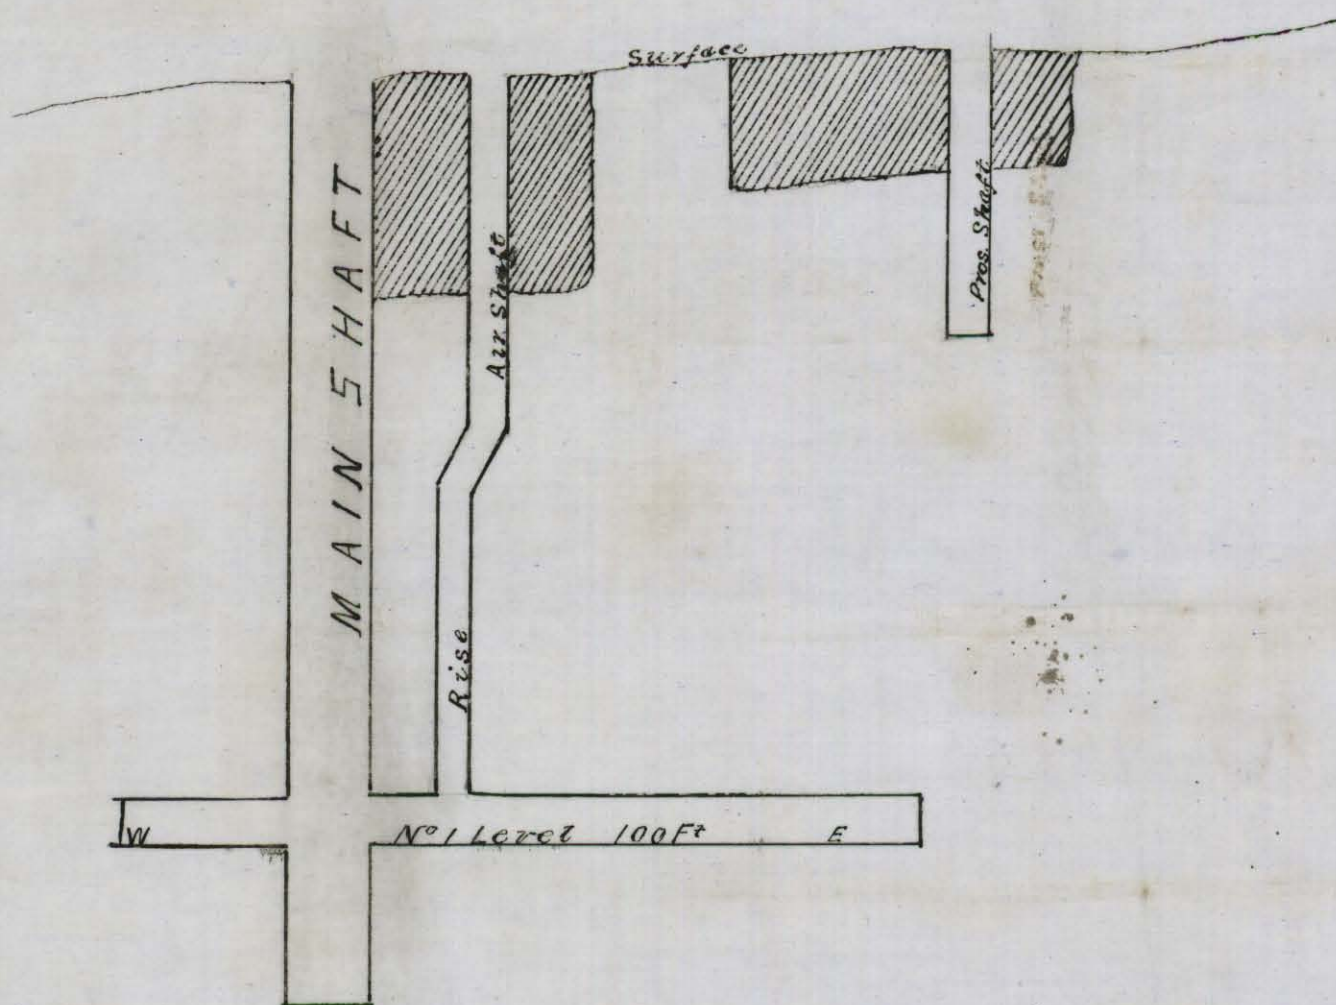

LONG⁶/₇ SECTION

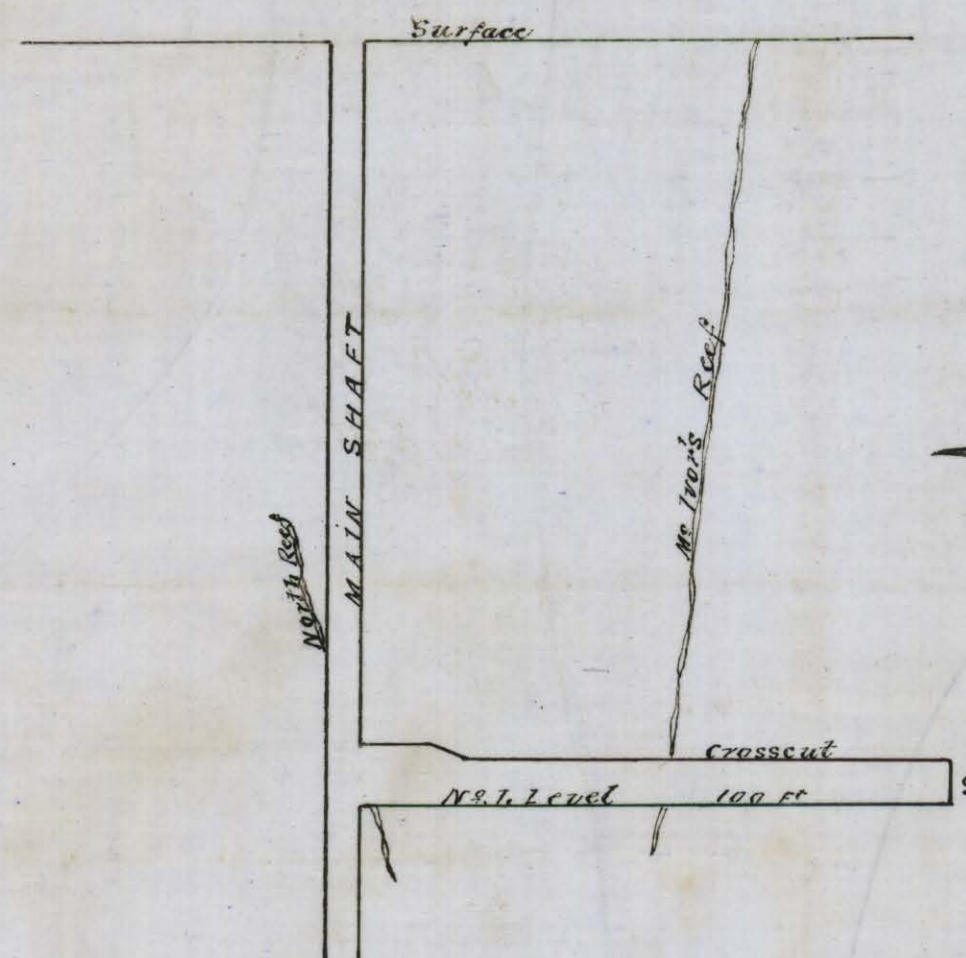

Cross Section

= THE McIVOR GOLD MINING COMPANY, NO LIABILITY

Scale 25. F^t to 1. Inch

J. T. Smith

Maine Manager
Le Roy. Jan 15. 1906



Da. T. W. M. 360

H.C. Graess

180-001

Mr. 1009
Mr. 7001 & 7002