
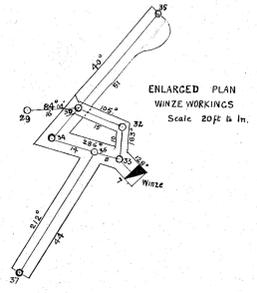
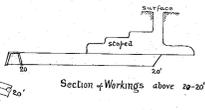
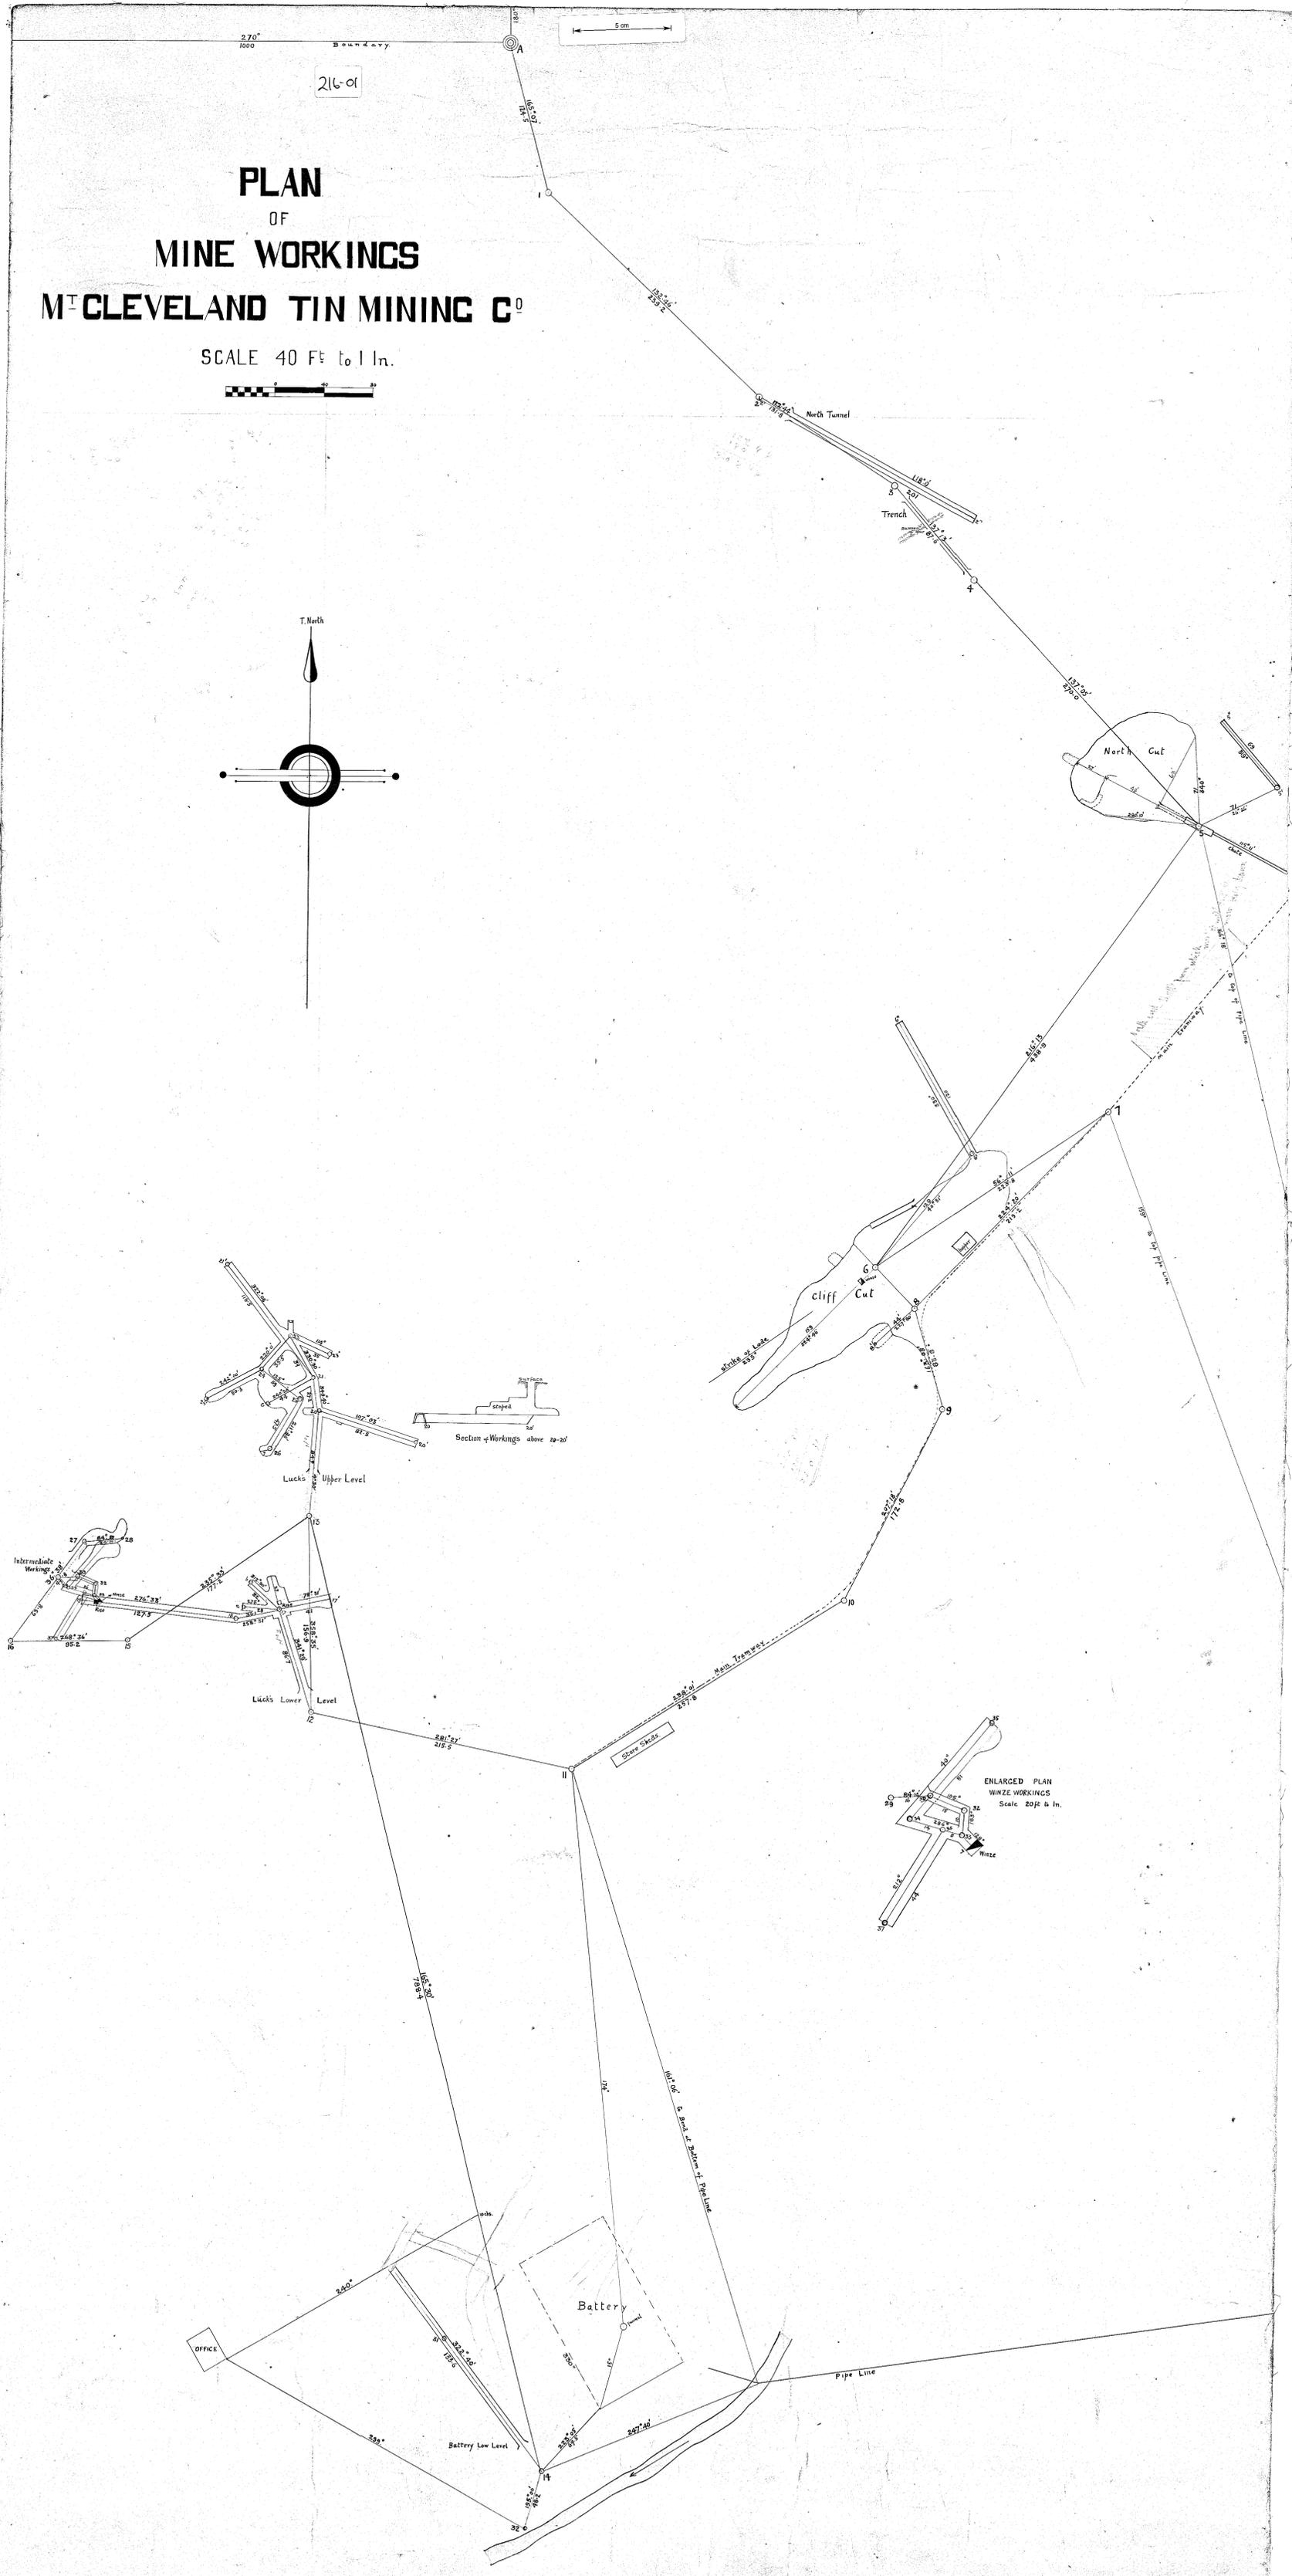
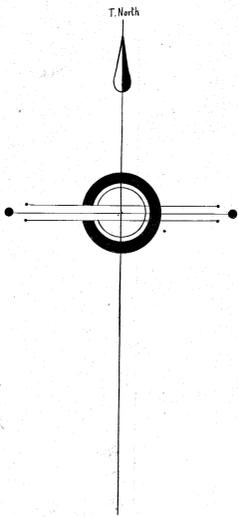


# PLAN OF MINE WORKINGS M<sup>r</sup> CLEVELAND TIN MINING CO

SCALE 40 Ft to 1 In.

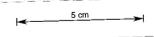

*S. V. Allen  
Authorized Mine Surveyor  
April 1915.*