
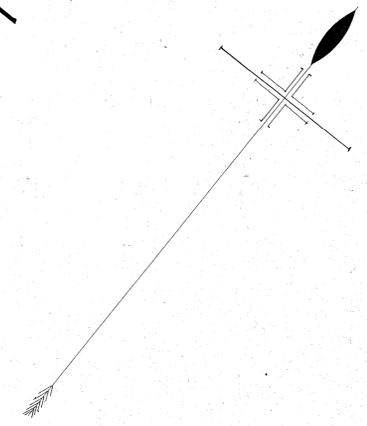
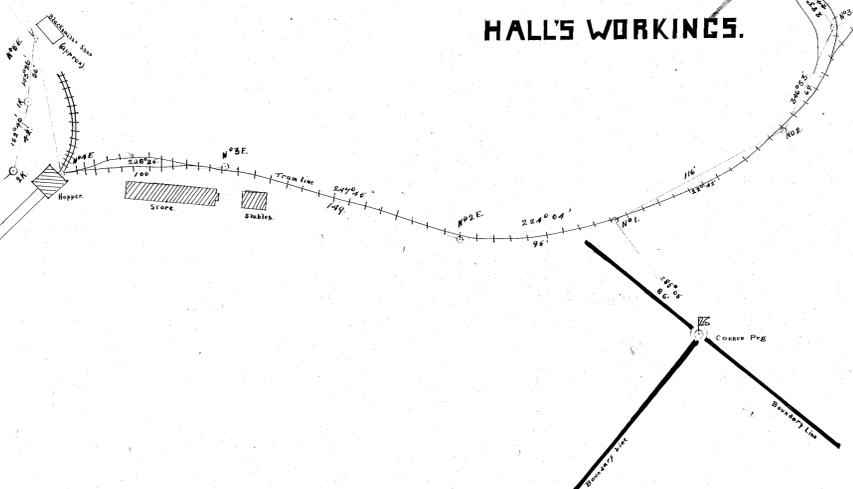
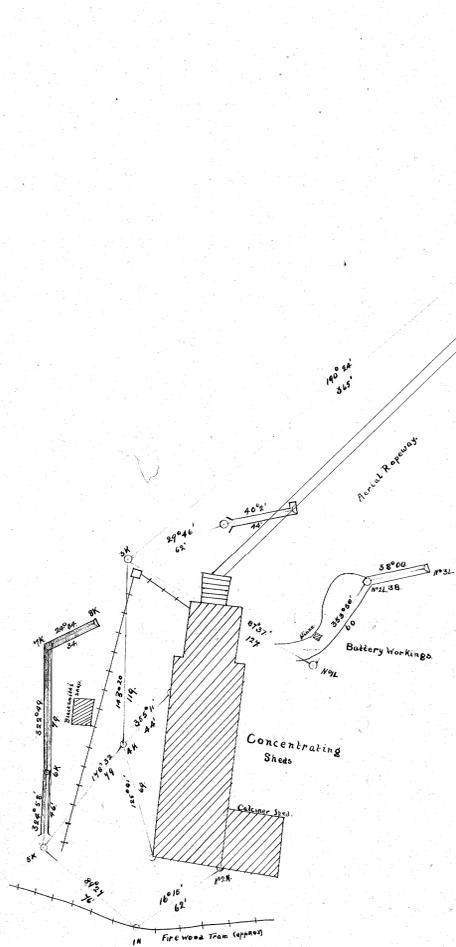
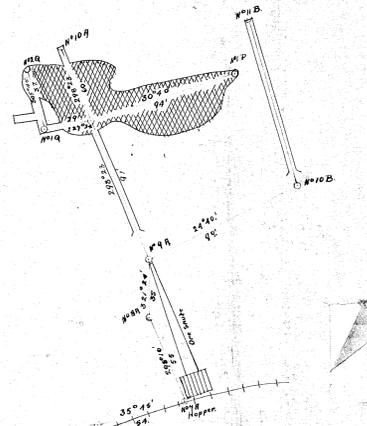
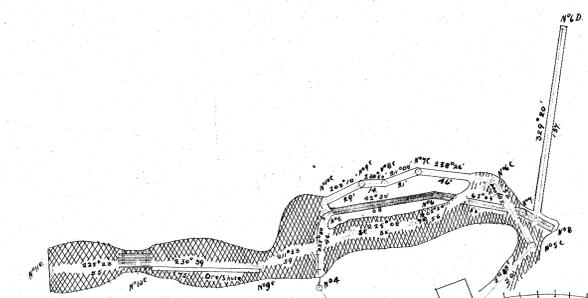
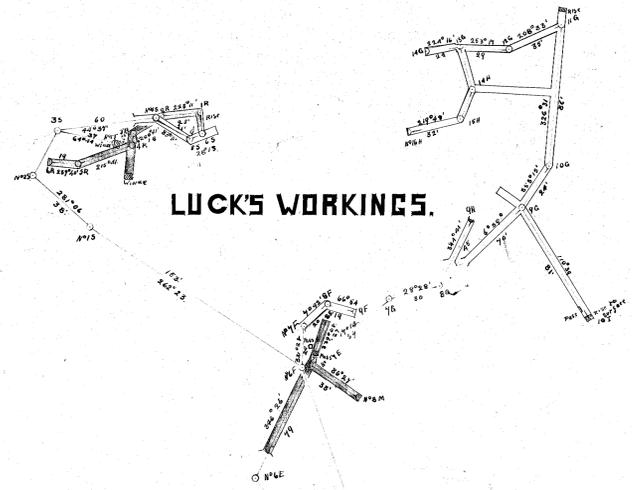


MT. CLEVELAND TIN MINING CO. N. L.

PLAN

SHOWING POSITION OF WORKINGS.

REFERENCE.

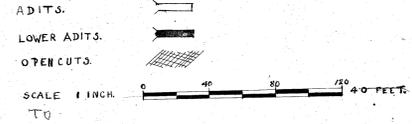

216-06

