


HALLS LONGITUDINAL REFERENCE PLANE

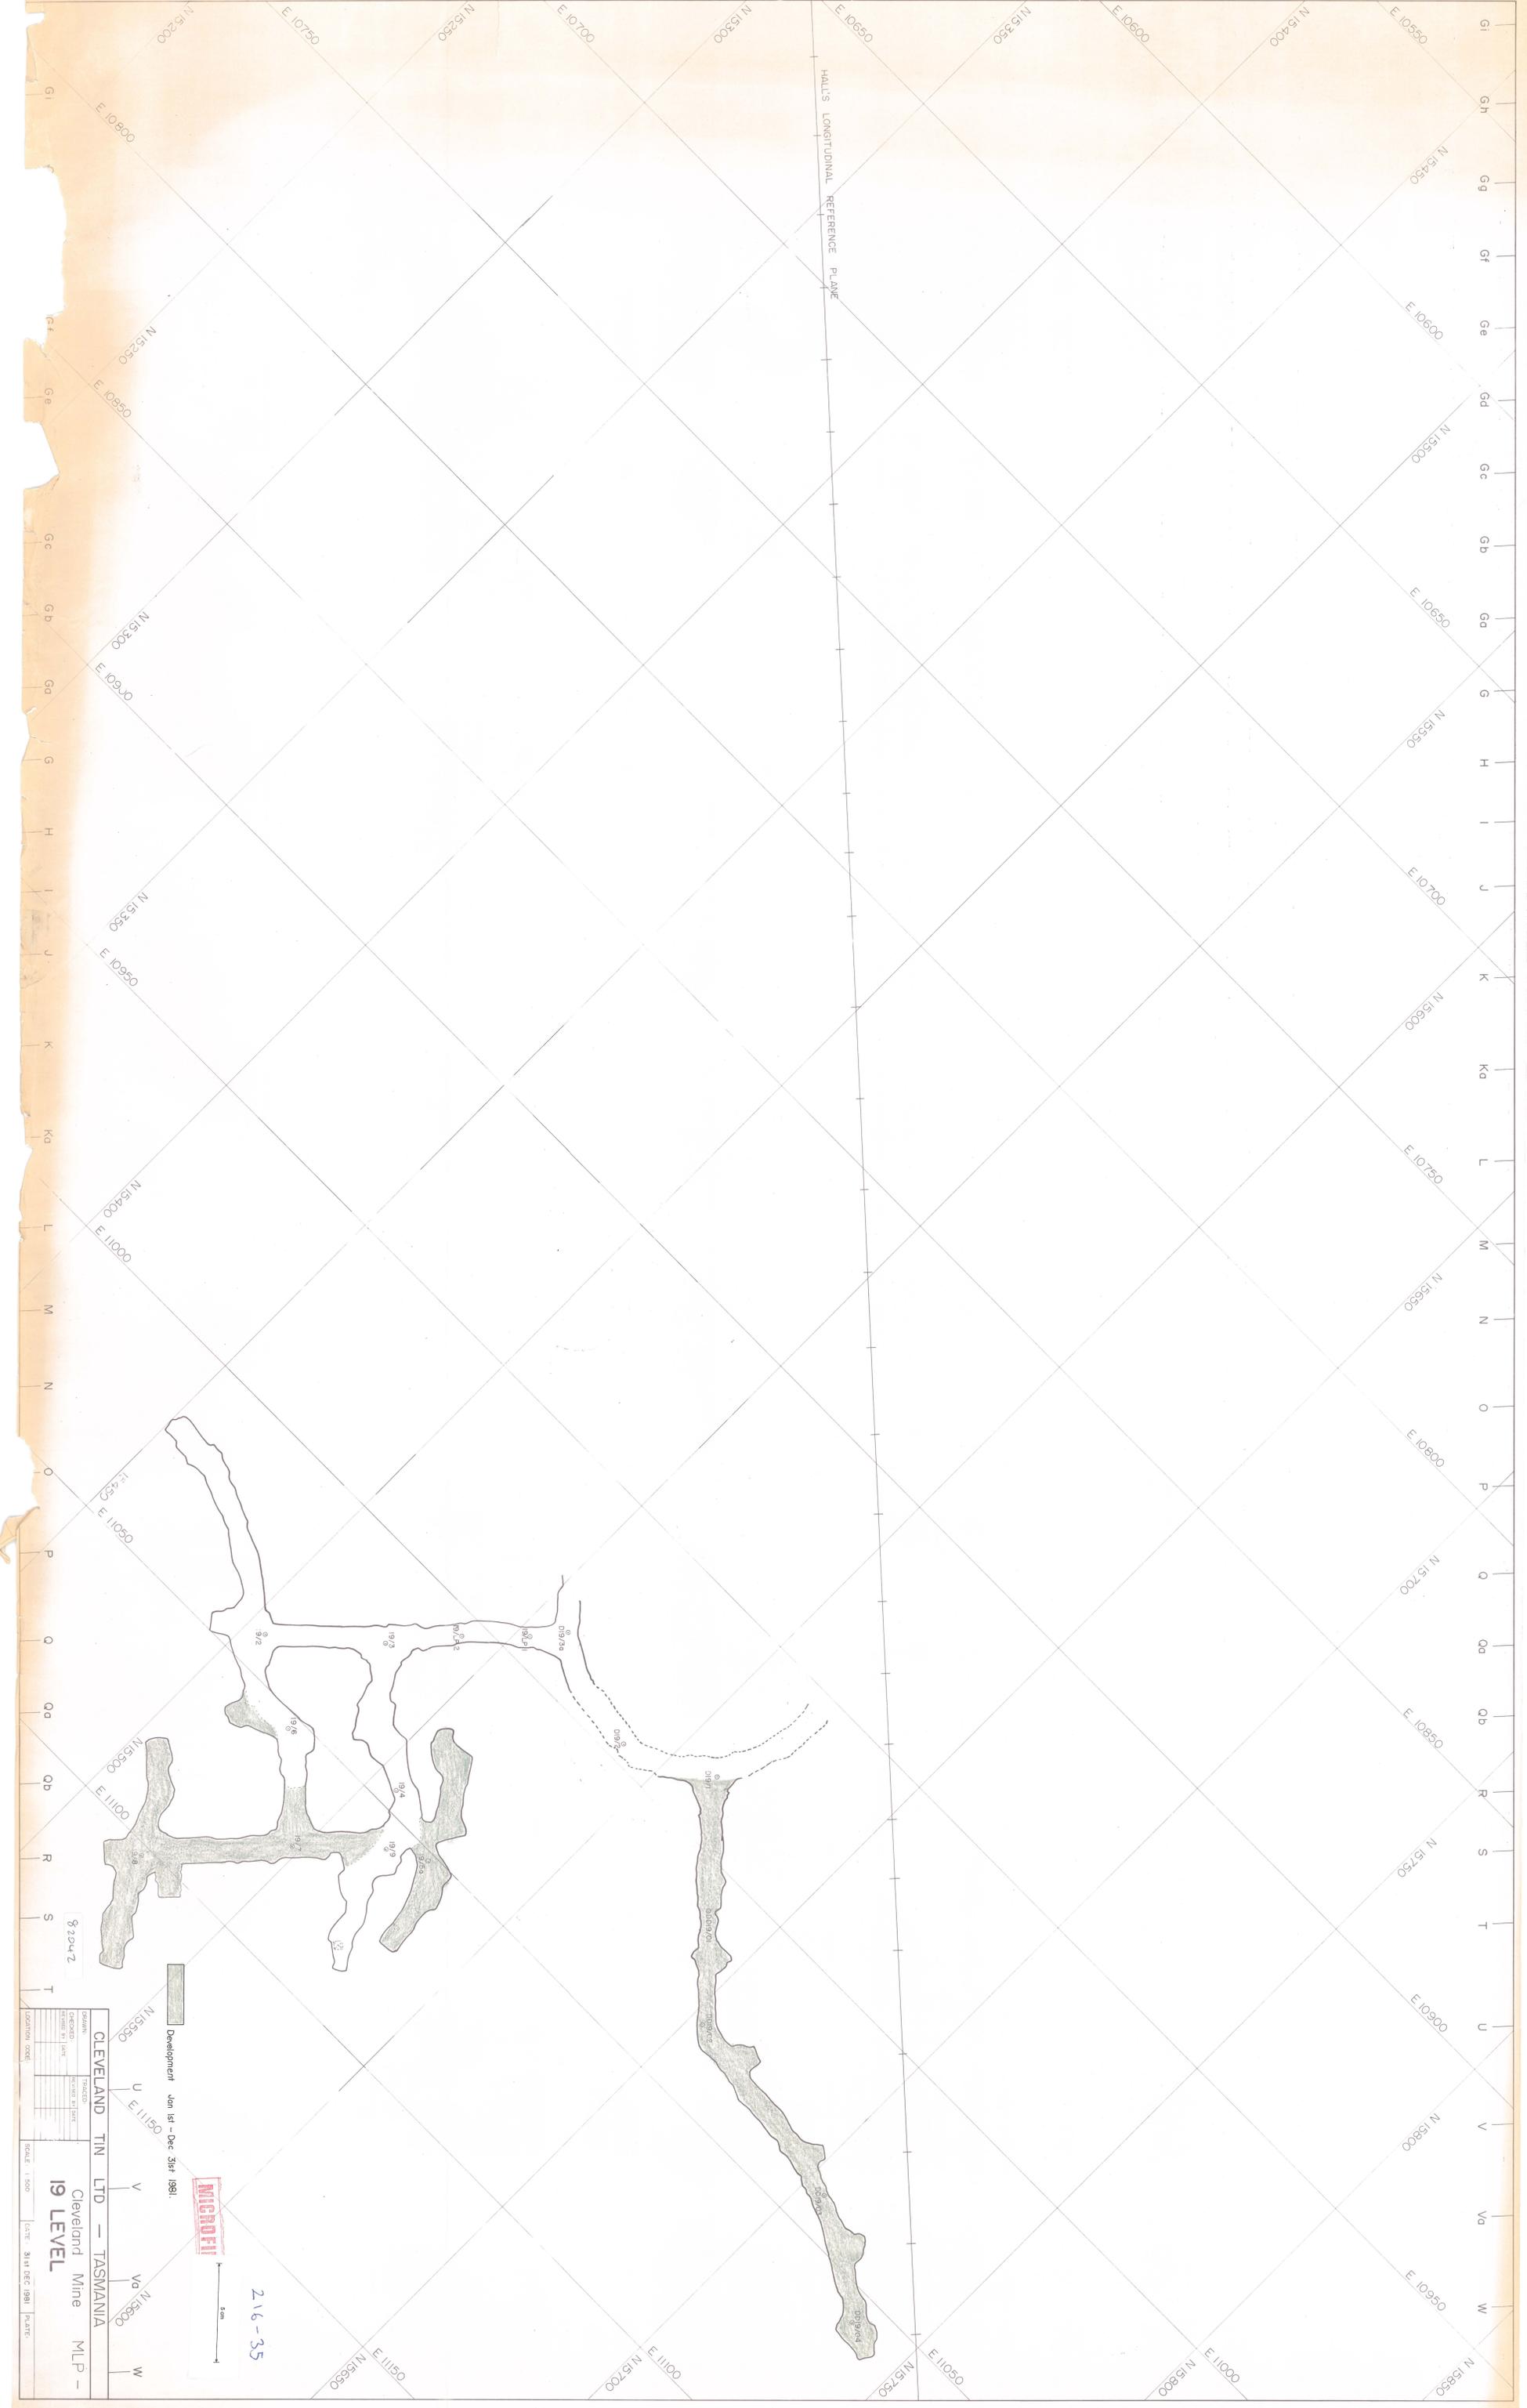

DRAWING NO.	PROJECT	DATE
19	CLEVELAND TIN LTD - TASMANIA	31st DEC 1991
DATE	SCALE	PLATE
31st DEC 1991	1:500	216-35

CLEVELAND TIN LTD - TASMANIA  
Cleveland Mine MLP -  
19 LEVEL

Development Jan 1st - Dec 31st 1991

SCALE 1:500

DATE 31st DEC 1991

PLATE 216-35

MICROFILM