


DEVELOPMENT 1st JAN — 31st DEC 1981



216-39

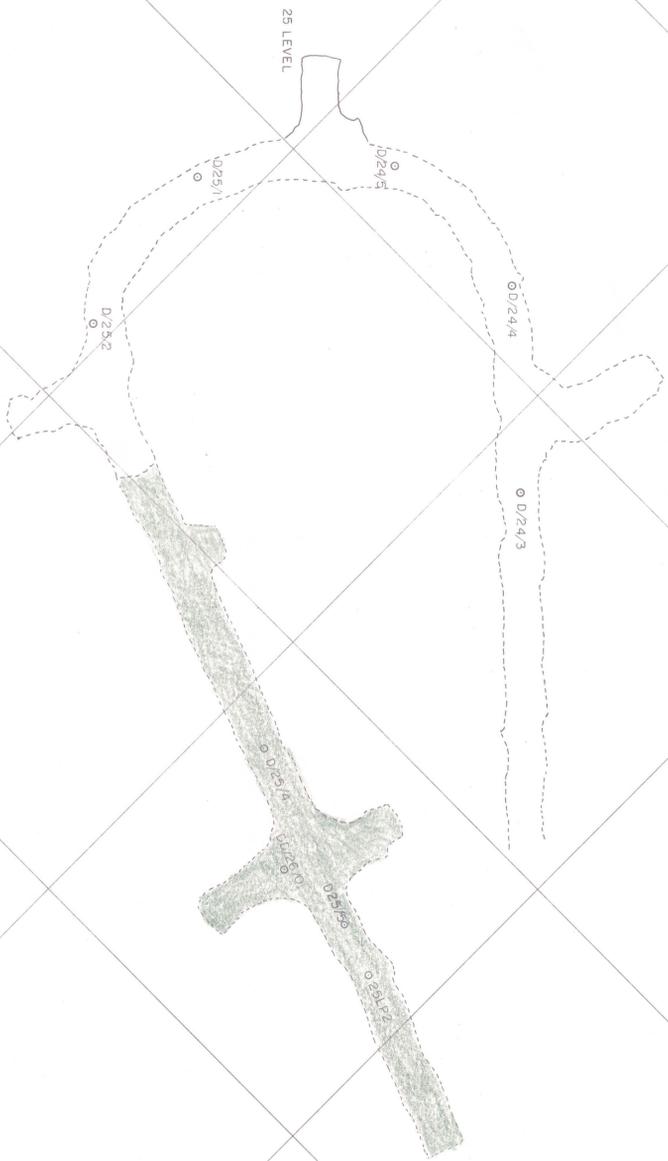

82047

Surveyed:		CLEVELAND TIN LTD	Scale: 1 500	Date: 31/12/81	Sheet:
Drawn:					
Traced:					
Checked:					
App'd. C/Supt.					
App'd. M/Supt.		Decline — 26 LEVEL	Drawing No	MLP-265	