


SOUTH WEST

NORTH EAST

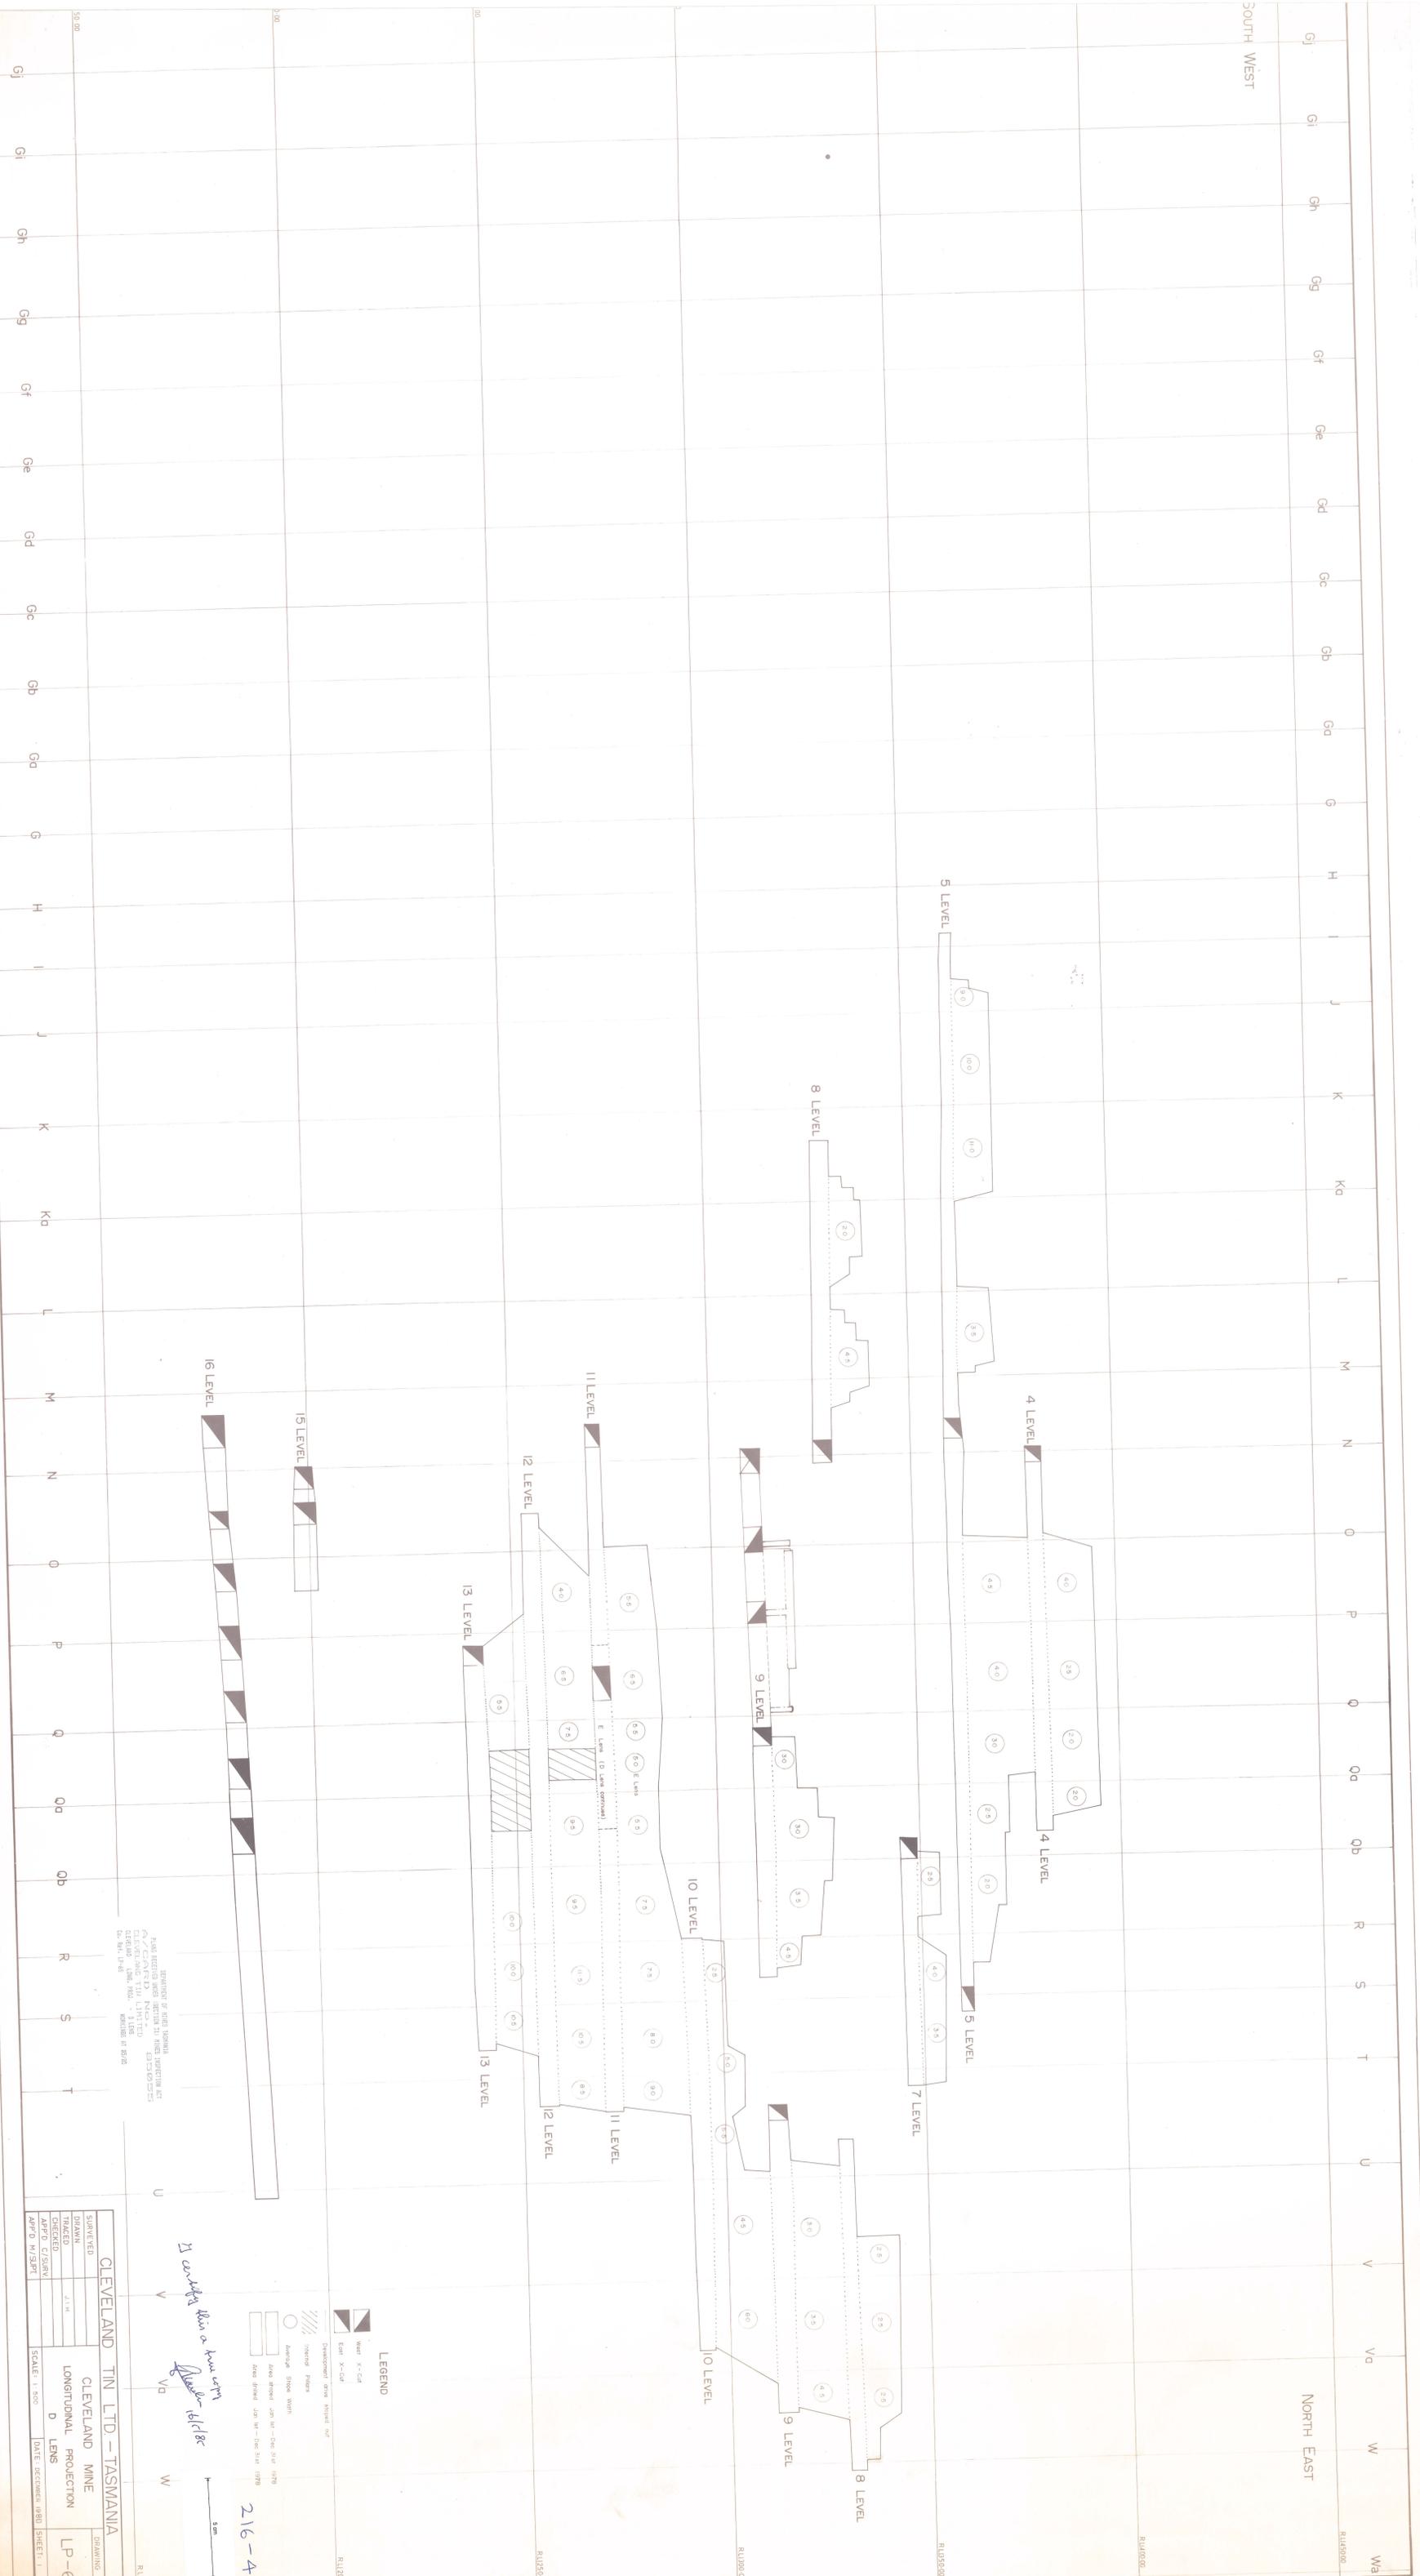

REPRODUCED FROM THE ORIGINAL DRAWING BY THE
 ENGINEERING DEPARTMENT OF THE
 CLEVELAND TIN LTD. LIMITED
 1978

It consists of two parts
 16/1/88

216-41

5cm

CLEVELAND TIN LTD. - TASMANIA		DRAWING NO.
DESIGNED	CLEVELAND MINE	LP-6S
DRAWN	LONGITUDINAL PROJECTION	
CHECKED	D LENS	
APPROVED	DATE DECEMBER 1981	SHEET 1
SCALE 1:1000		