


SOUTH WEST

NORTH EAST



216-47
 52054

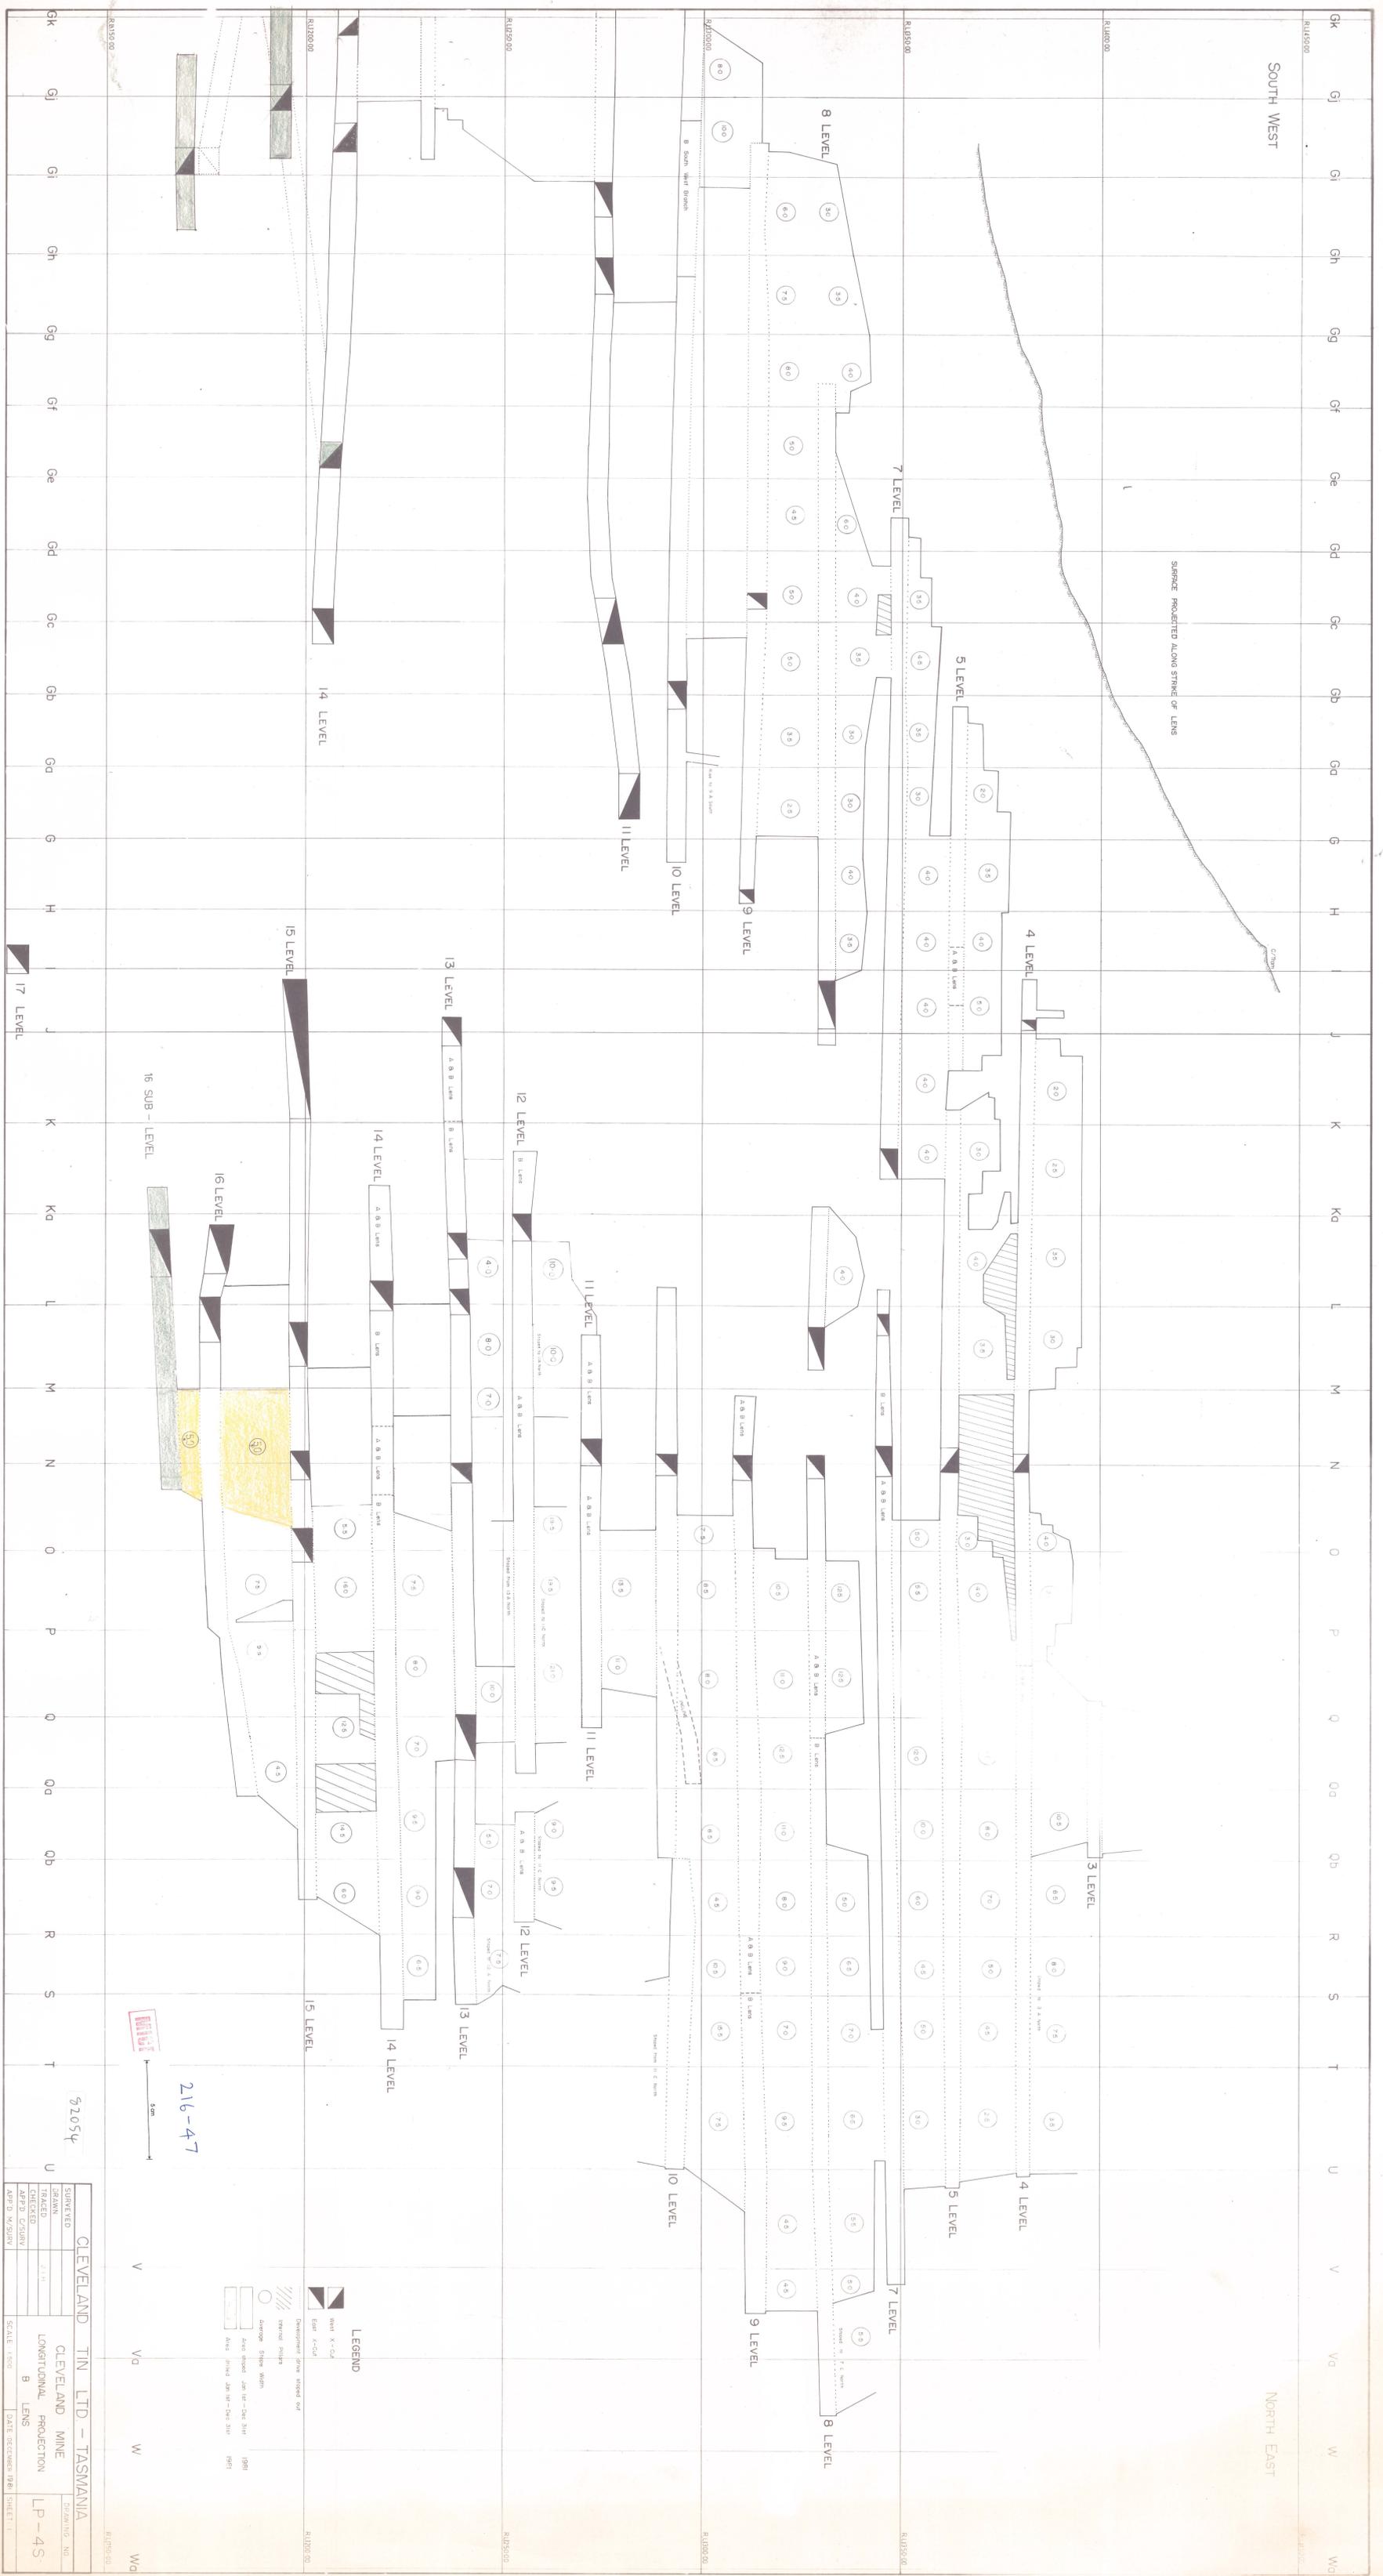

LEGEND

- ◻ West X-Cut
- ◻ East F-Cut
- ◻ Development drive method cut
- ◻ Internal Pillar
- ◻ Average Slope When
- ◻ Zone Stood Jan 1st - Dec 31st 1981
- ◻ Area Zoned Jan 1st - Dec 31st 1981

SURVEYED		CLEVELAND TIN LTD - TASMANIA	
DRAWN	216	CLEVELAND MINE	DRAWING NO.
TRACED	216	LONGITUDINAL PROJECTION	LP-45
CHECKED		LENS	B
APP'D. C/SURV		SCALE 1:500	DATE DECEMBER 1981 SHEET 1