


0216_115

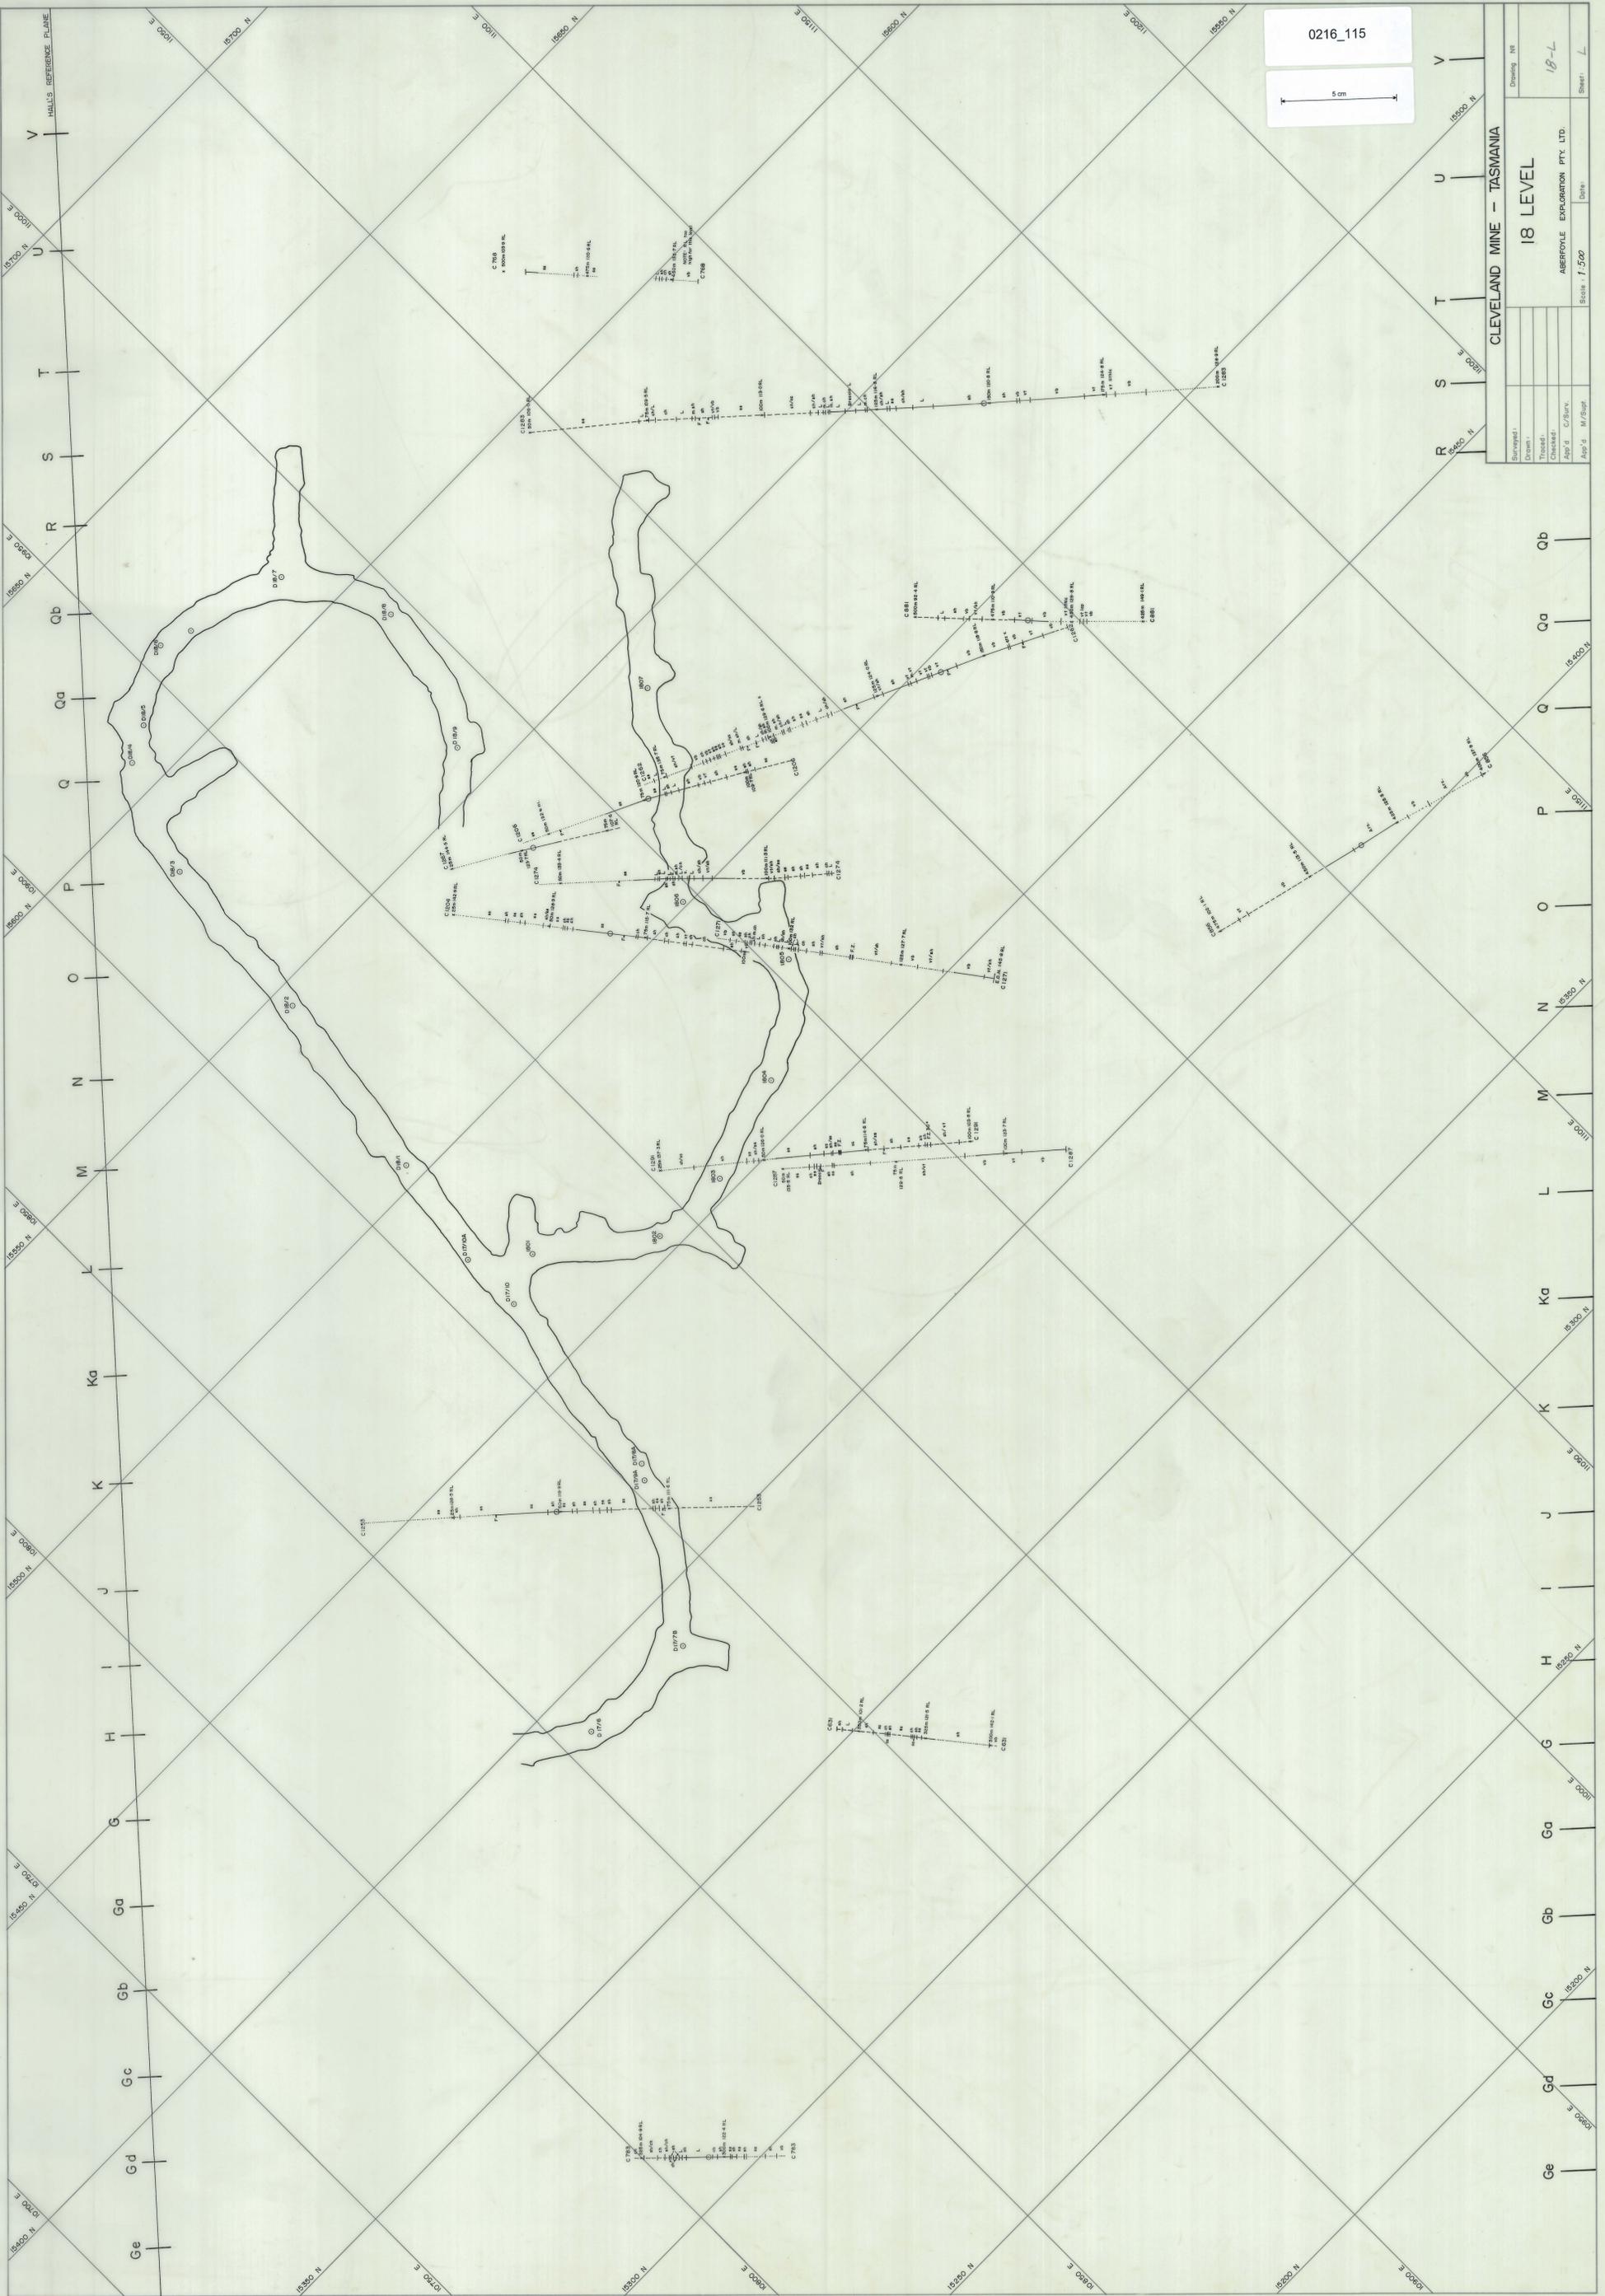

CLEVELAND MINE - TASMANIA	
Drawn: NR	Sheet: L
18 LEVEL	
ABERFOYLE EXPLORATION PTY. LTD.	
Scale: 1:500	Date:
App'd: M/Sup	Drawn: L
Checked:	Sheet: L
Approved:	Sheet: L

V
 U
 T
 S
 R
 Qb
 Qd
 Q
 P
 O
 N
 M
 L
 Ka
 K
 J
 I
 H
 G
 Ga
 Gb
 Gc
 Gd
 Ge