


0216\_137

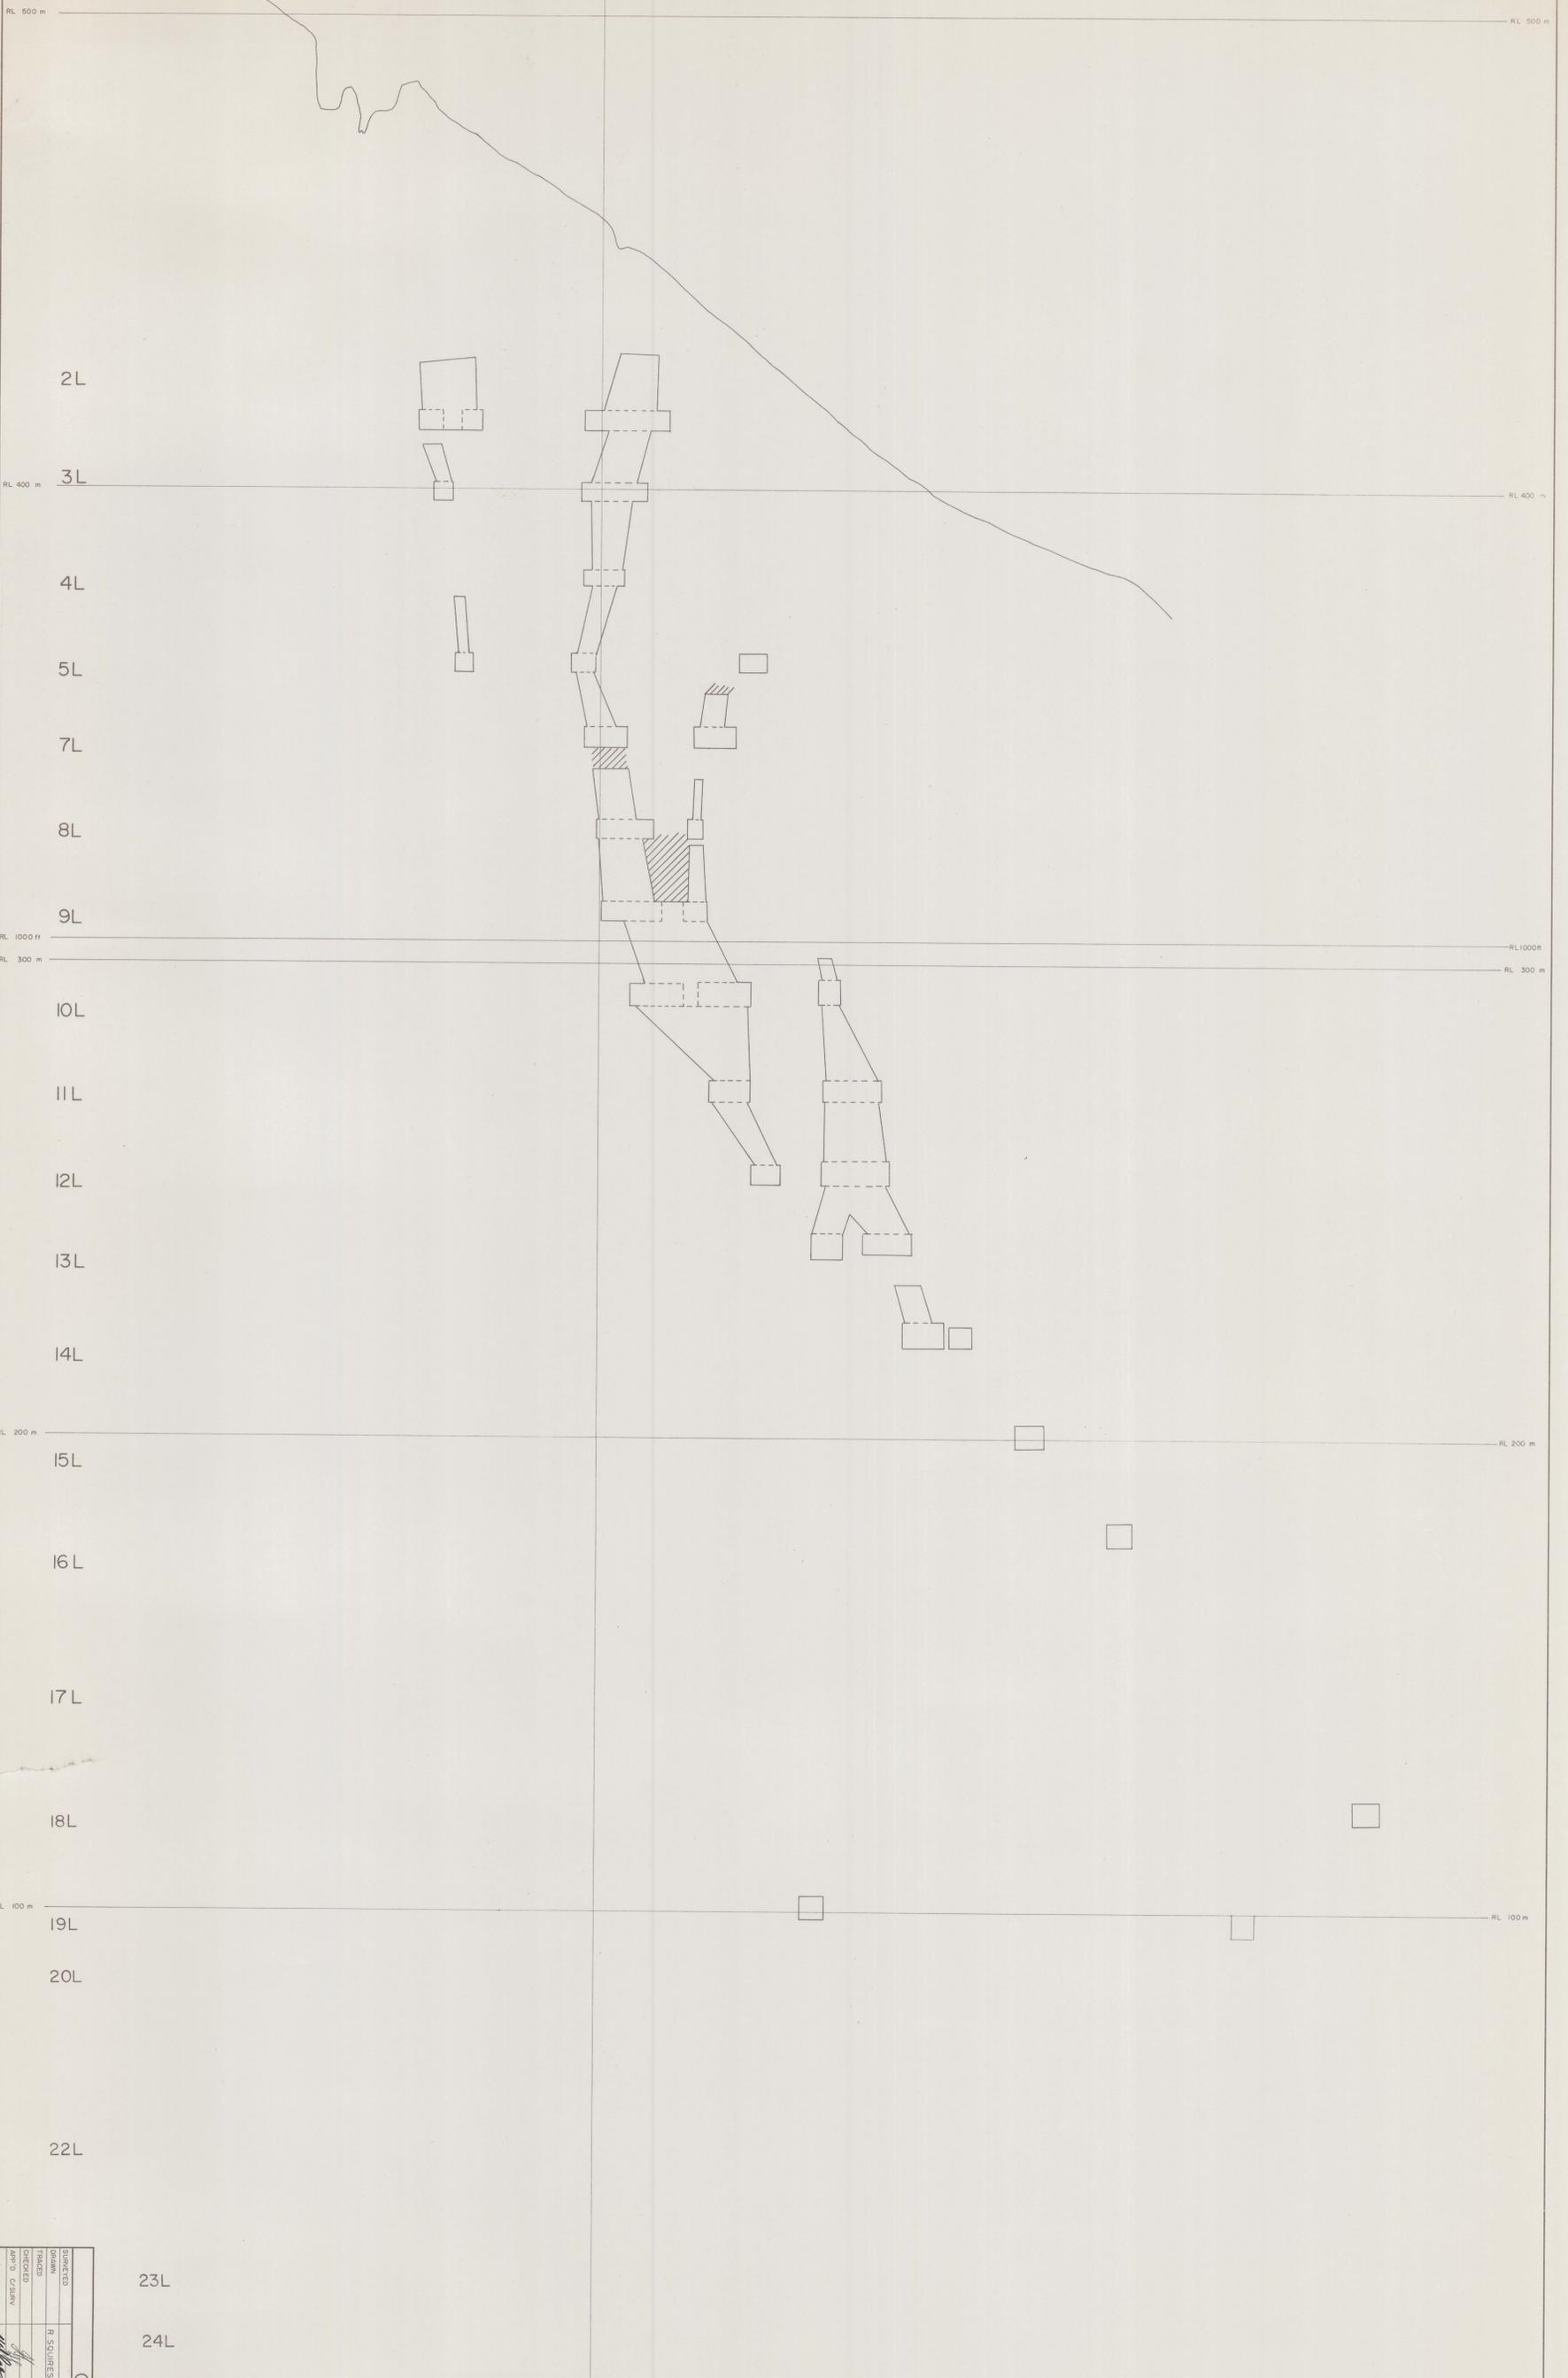

DESIGNED BY	REVISIONS	DATE	BY
TRACED	BY		
CHECKED	BY		
APPROVED	BY		
<b>CLEVELAND TIN LTD.</b> <b>CLEVELAND MINE</b> <b>S SECTION</b>			
SCALE	1:500	DATE	DEC. 31 1979
DRAWING NO.		CS-35 S	
SHEET		SHEET	



**MICROFILMED**

80036

WALL'S REFERENCE PLANE