

0216_147

15 L

16 L

17 L

18 L

100 m

19 L

20 L

22 L





23 L

24 L

00

-100 m

-200 m

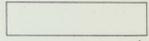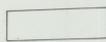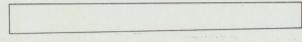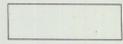

Surveyed		CLEVELAND TIN LTD	Drawing No
Drawn		CLEVELAND MINE	CS-26 S
Traced		L SECTION	
Checked			
App'd	C/Surv.		
App'd	M/Supt.		
		Scale 1:500	Sheet 2
		Date 31/12/1979	



MICROFILMED

80027