
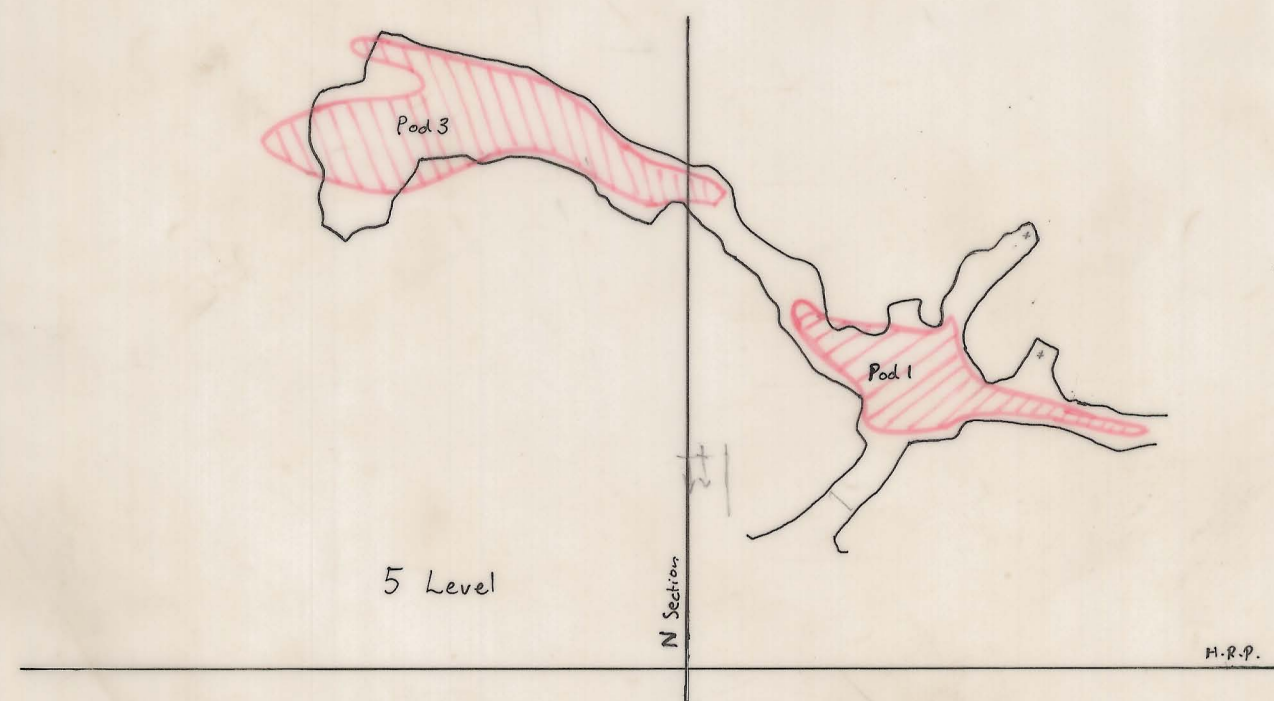
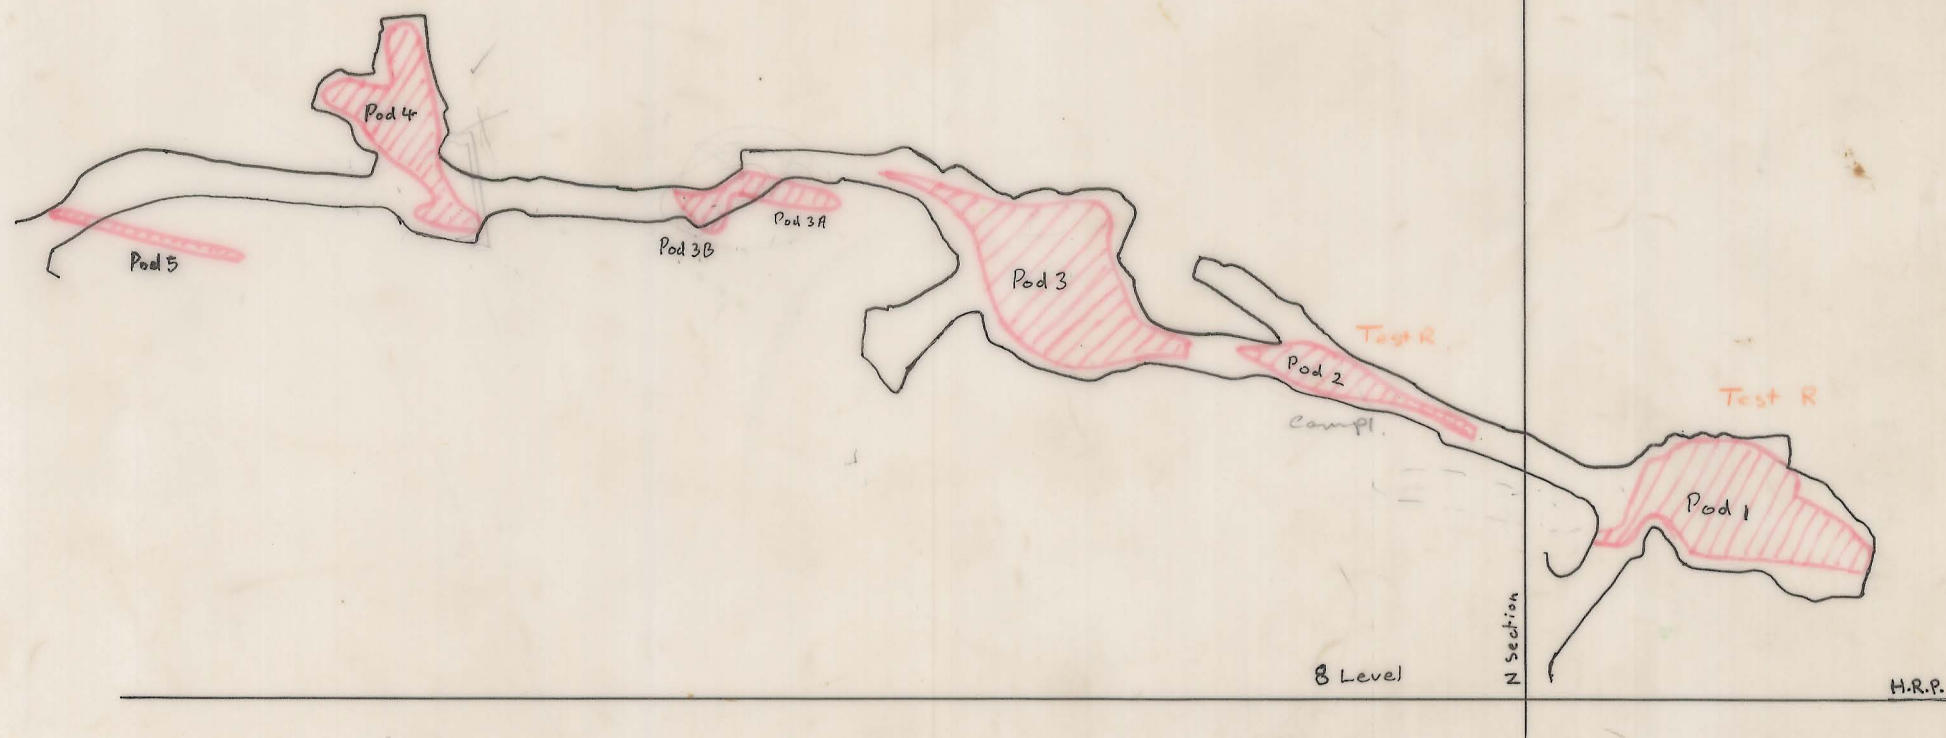
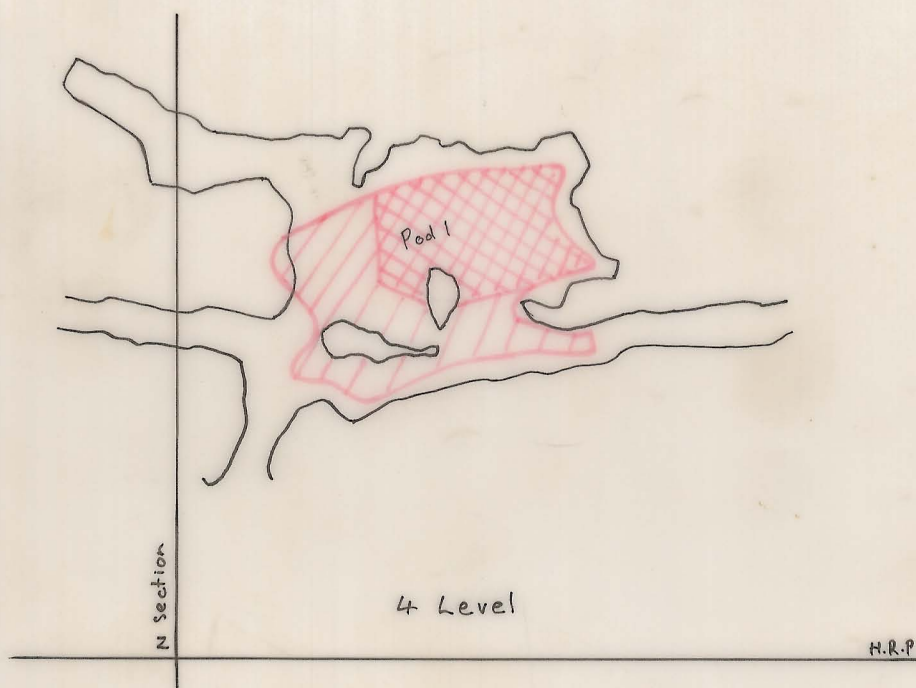
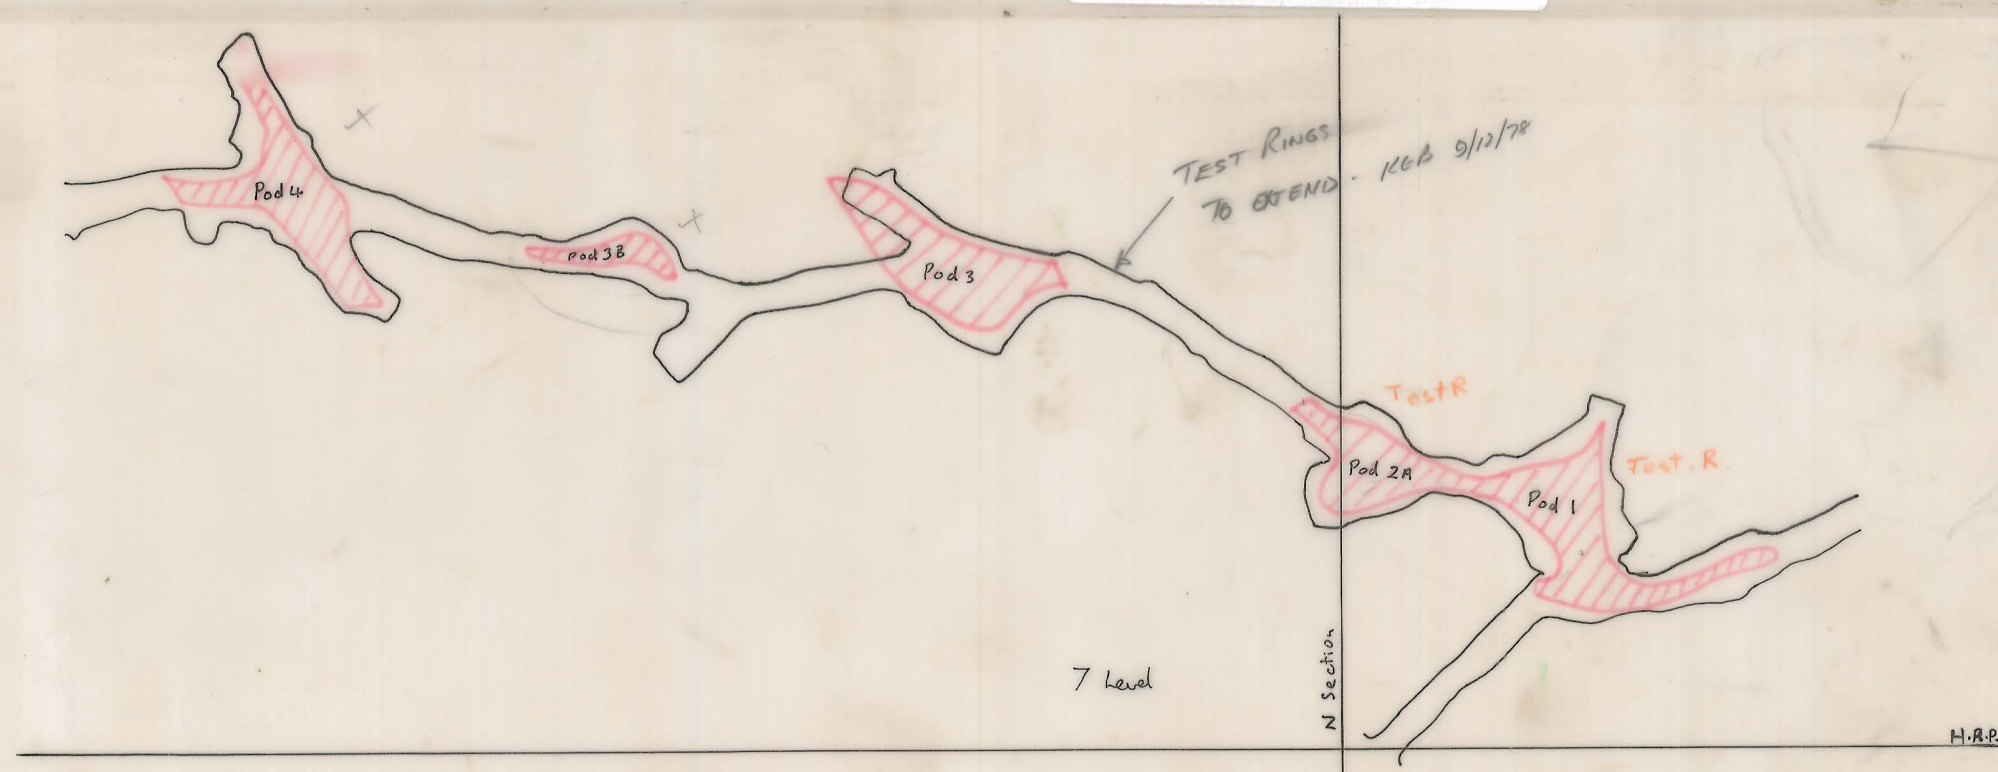


0216_279

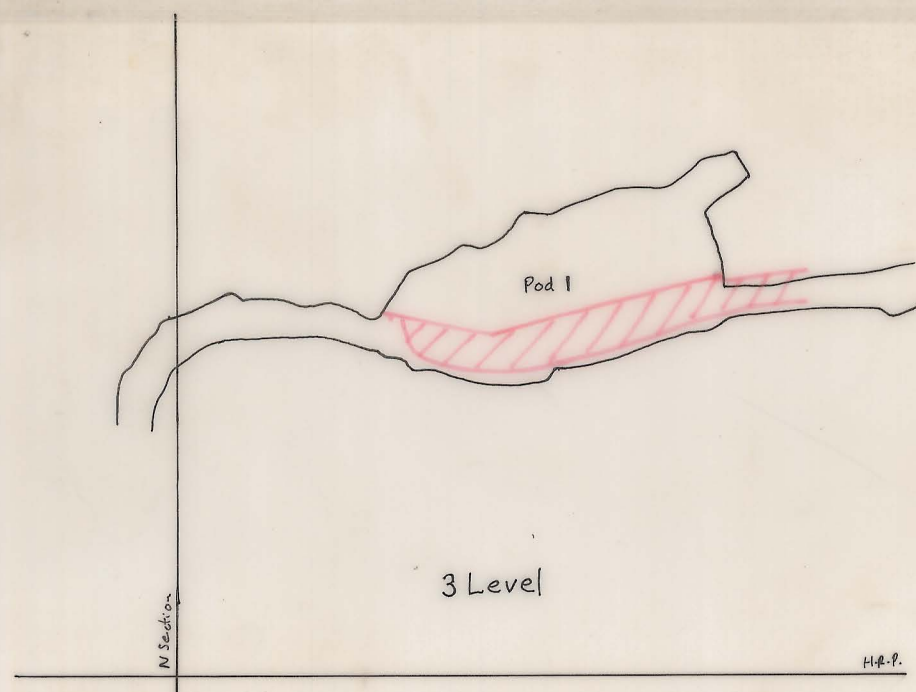

5 cm

Henrys Pods
1:1000