


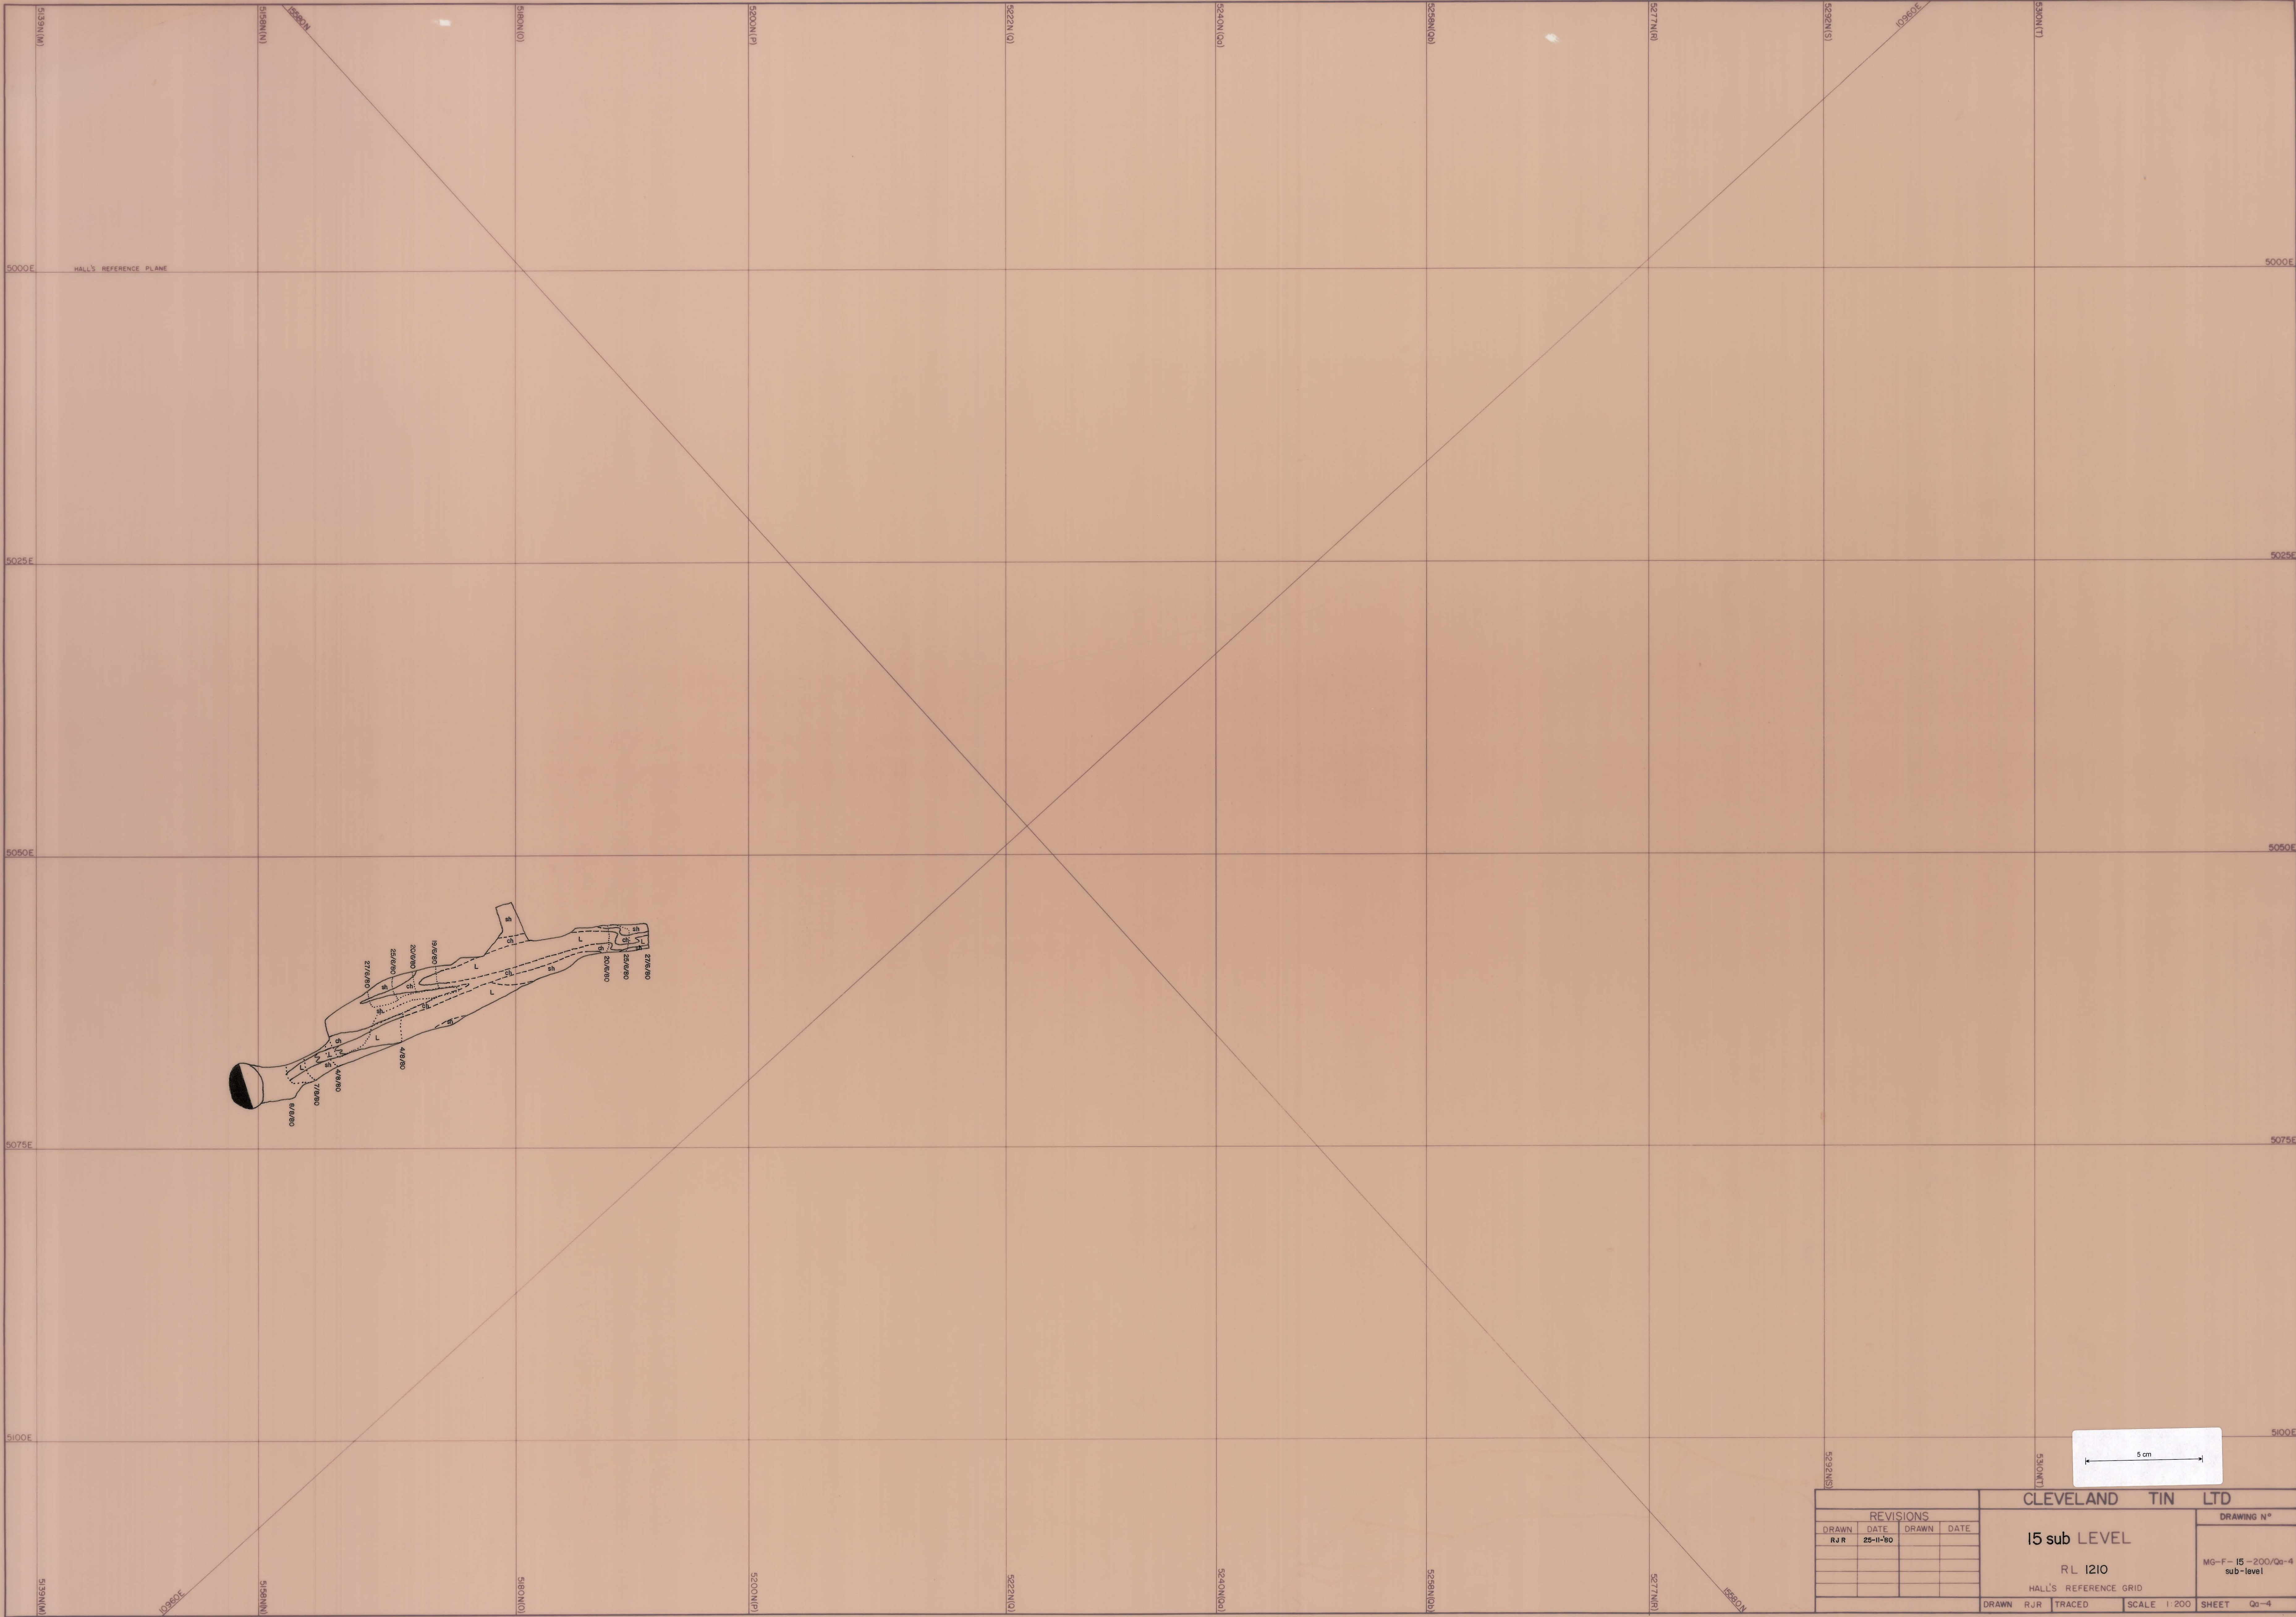

REVISIONS				CLEVELAND TIN LTD			
DRAWN	DATE	DRAWN	DATE	15 sub LEVEL		DRAWING N°	
RJR	25-11-80					MG-F-15-200/Qa-4 sub-level	
				RL 1210			
				HALL'S REFERENCE GRID			
				DRAWN	RJR	TRACED	SCALE 1:200
							SHEET Qa-4