


RL 500 M
RL 400 M
RL 300 M
RL 200 M
RL 100 M
800 Level

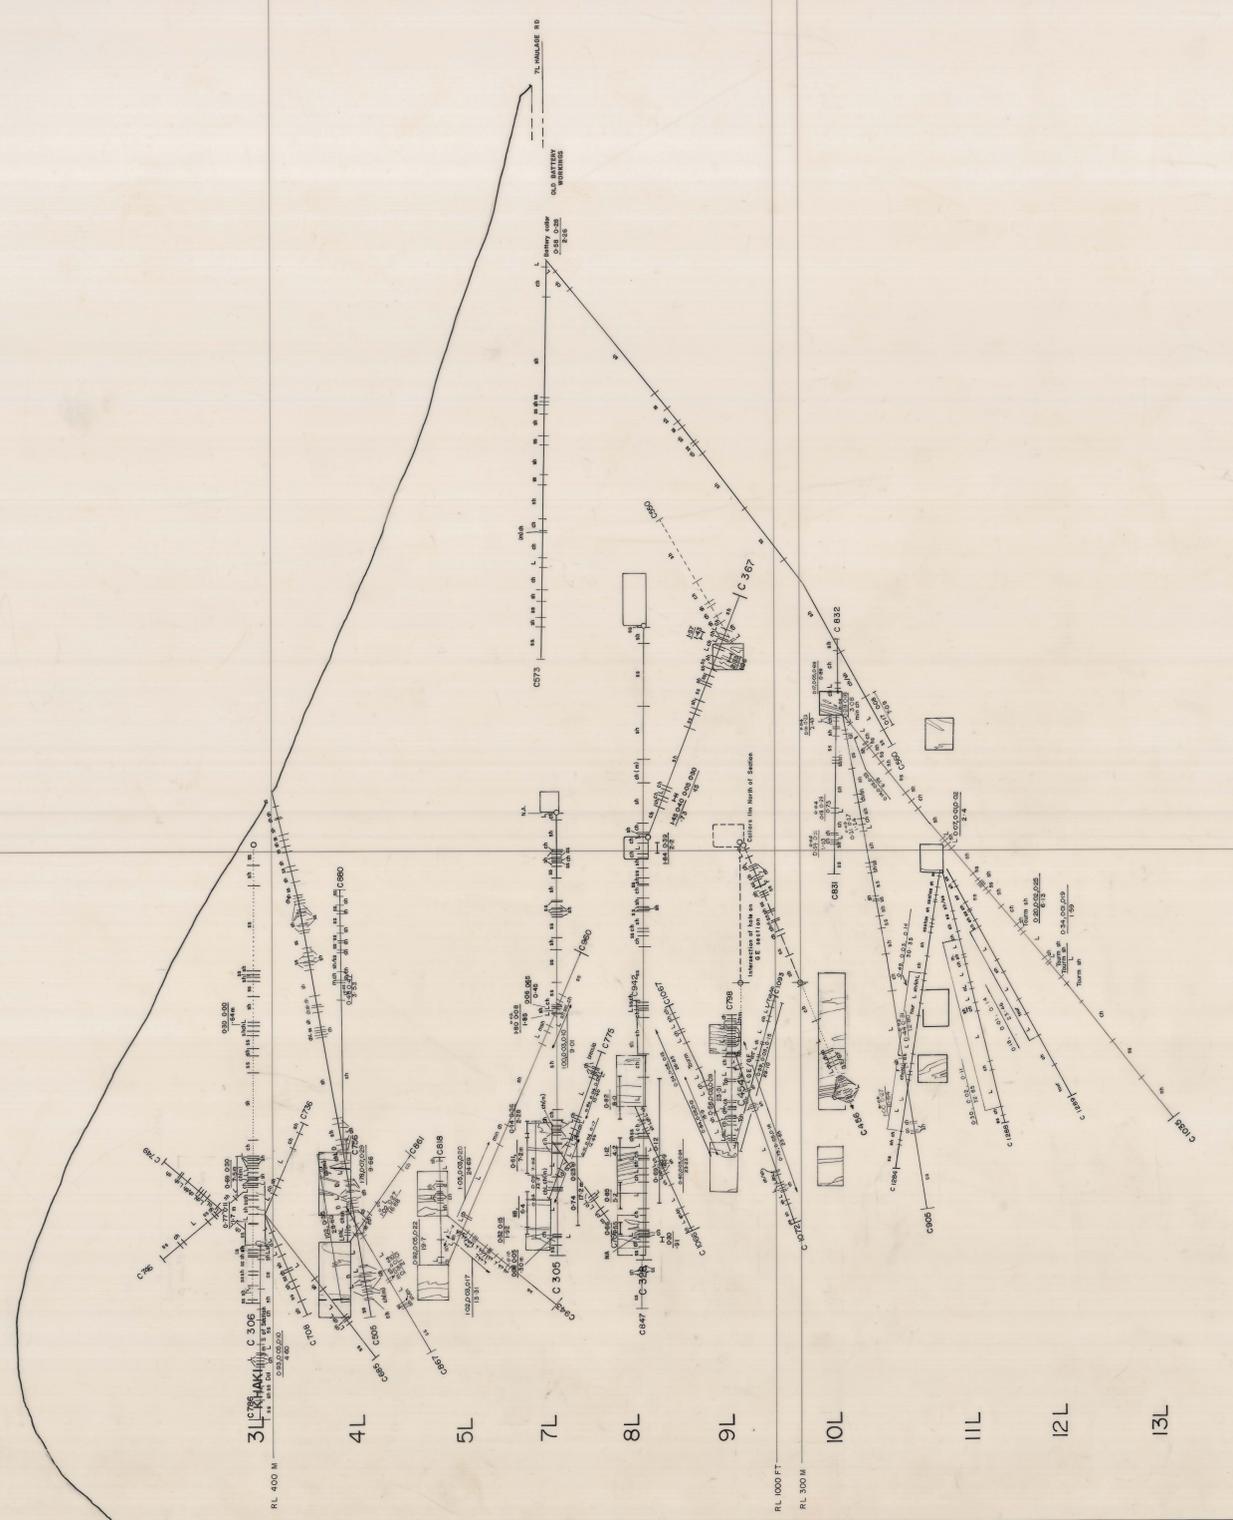

MG-4-68-400/222A

0216 369

5 cm

800 Level

HAL'S REFERENCE PLANE

RL 500 M
RL 400 M
RL 300 M
RL 200 M
RL 100 M
800 Level

3L
4L
5L
7L
8L
9L
10L
11L
12L
13L
14L
15L
16L

CLEVELAND TIN N.L.
Cleveland Mine GE Section

DRAWN BY: R. Cox, A. Jessup, P. Cullshaw, J. Teluk REVISED BY: J.A.S. REVISED DATE: 20/1/72	TRACED BY: REVISED BY: J.A.S. REVISED DATE: 20/1/72
---	---

prepared by COMINCO EXPLORATION PTY. LTD.
Scale: 1:500 Date: DECEMBER 1972 Plate: CT60GE/72