


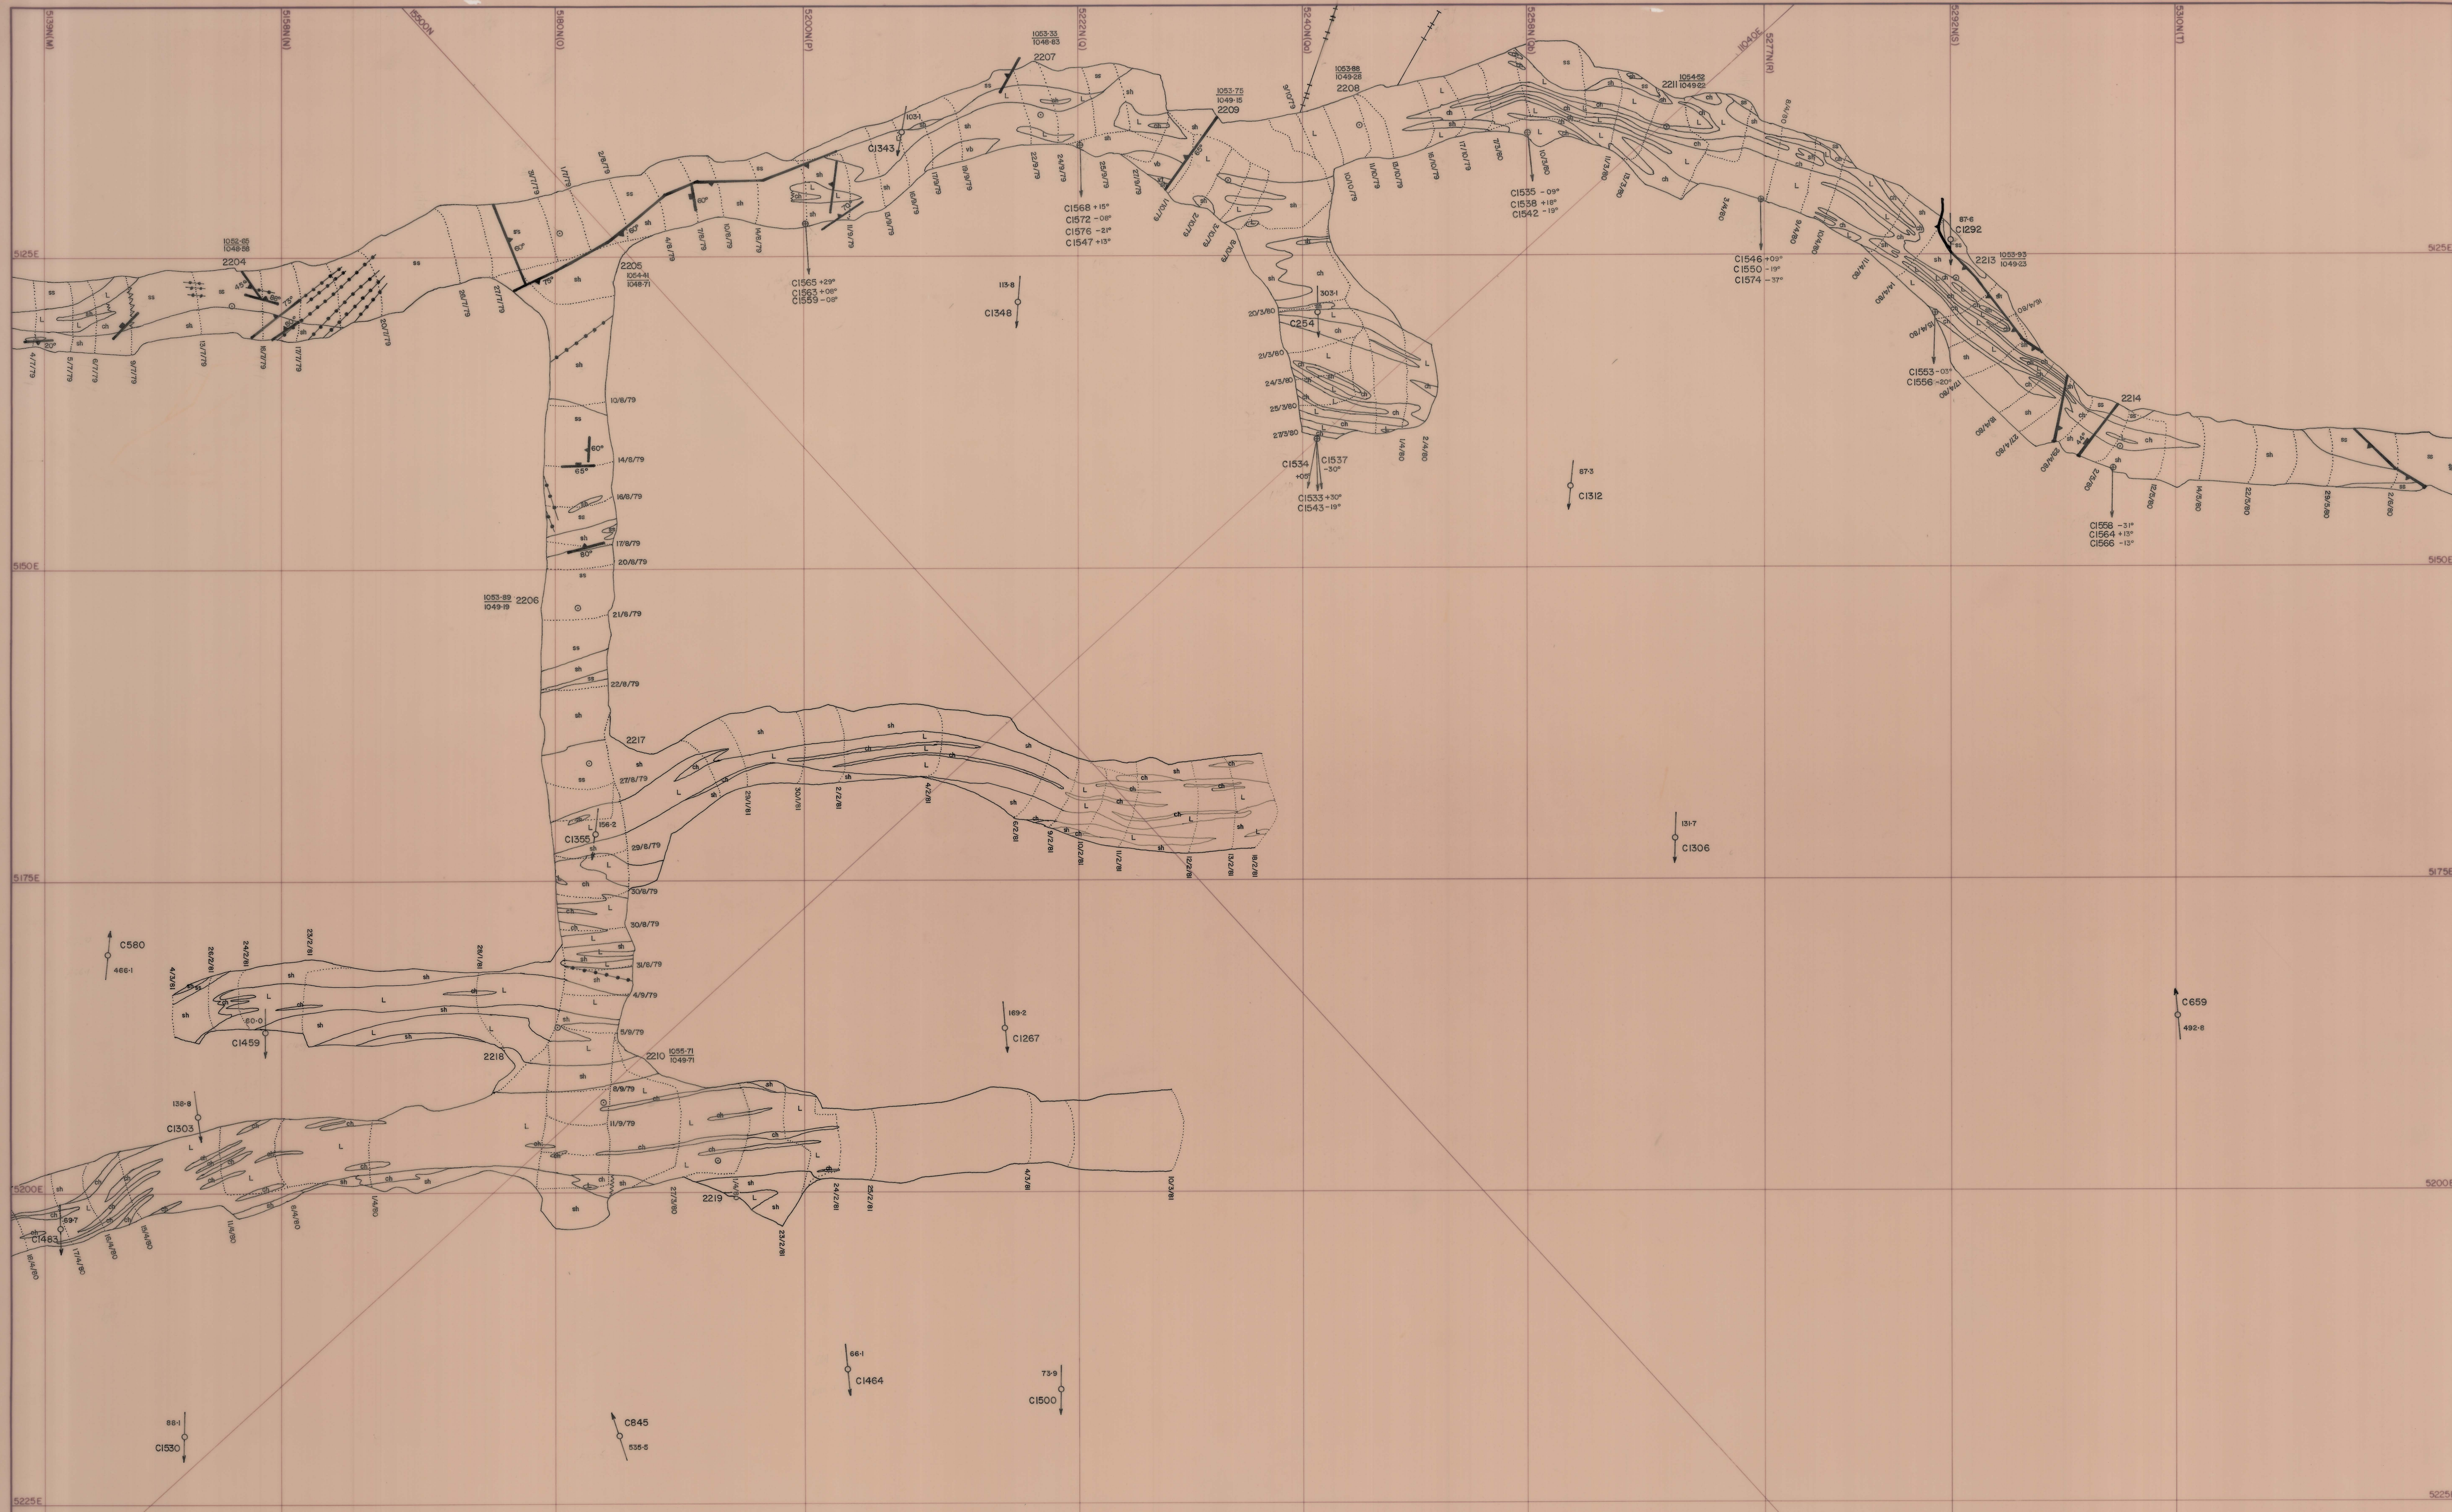

5 cm

REVISIONS				DRAWN DATE		DRAWN DATE	
DRAWN	DATE	DRAWN	DATE	DRAWN	DATE	DRAWN	DATE
RJR	22-9-90						

CLEVELAND TIN LTD
22 LEVEL
RL 1051
HALL'S REFERENCE GRID

DRAWN	RJR	TRACED	SCALE	1:200	SHEET	Qa-5
-------	-----	--------	-------	-------	-------	------