
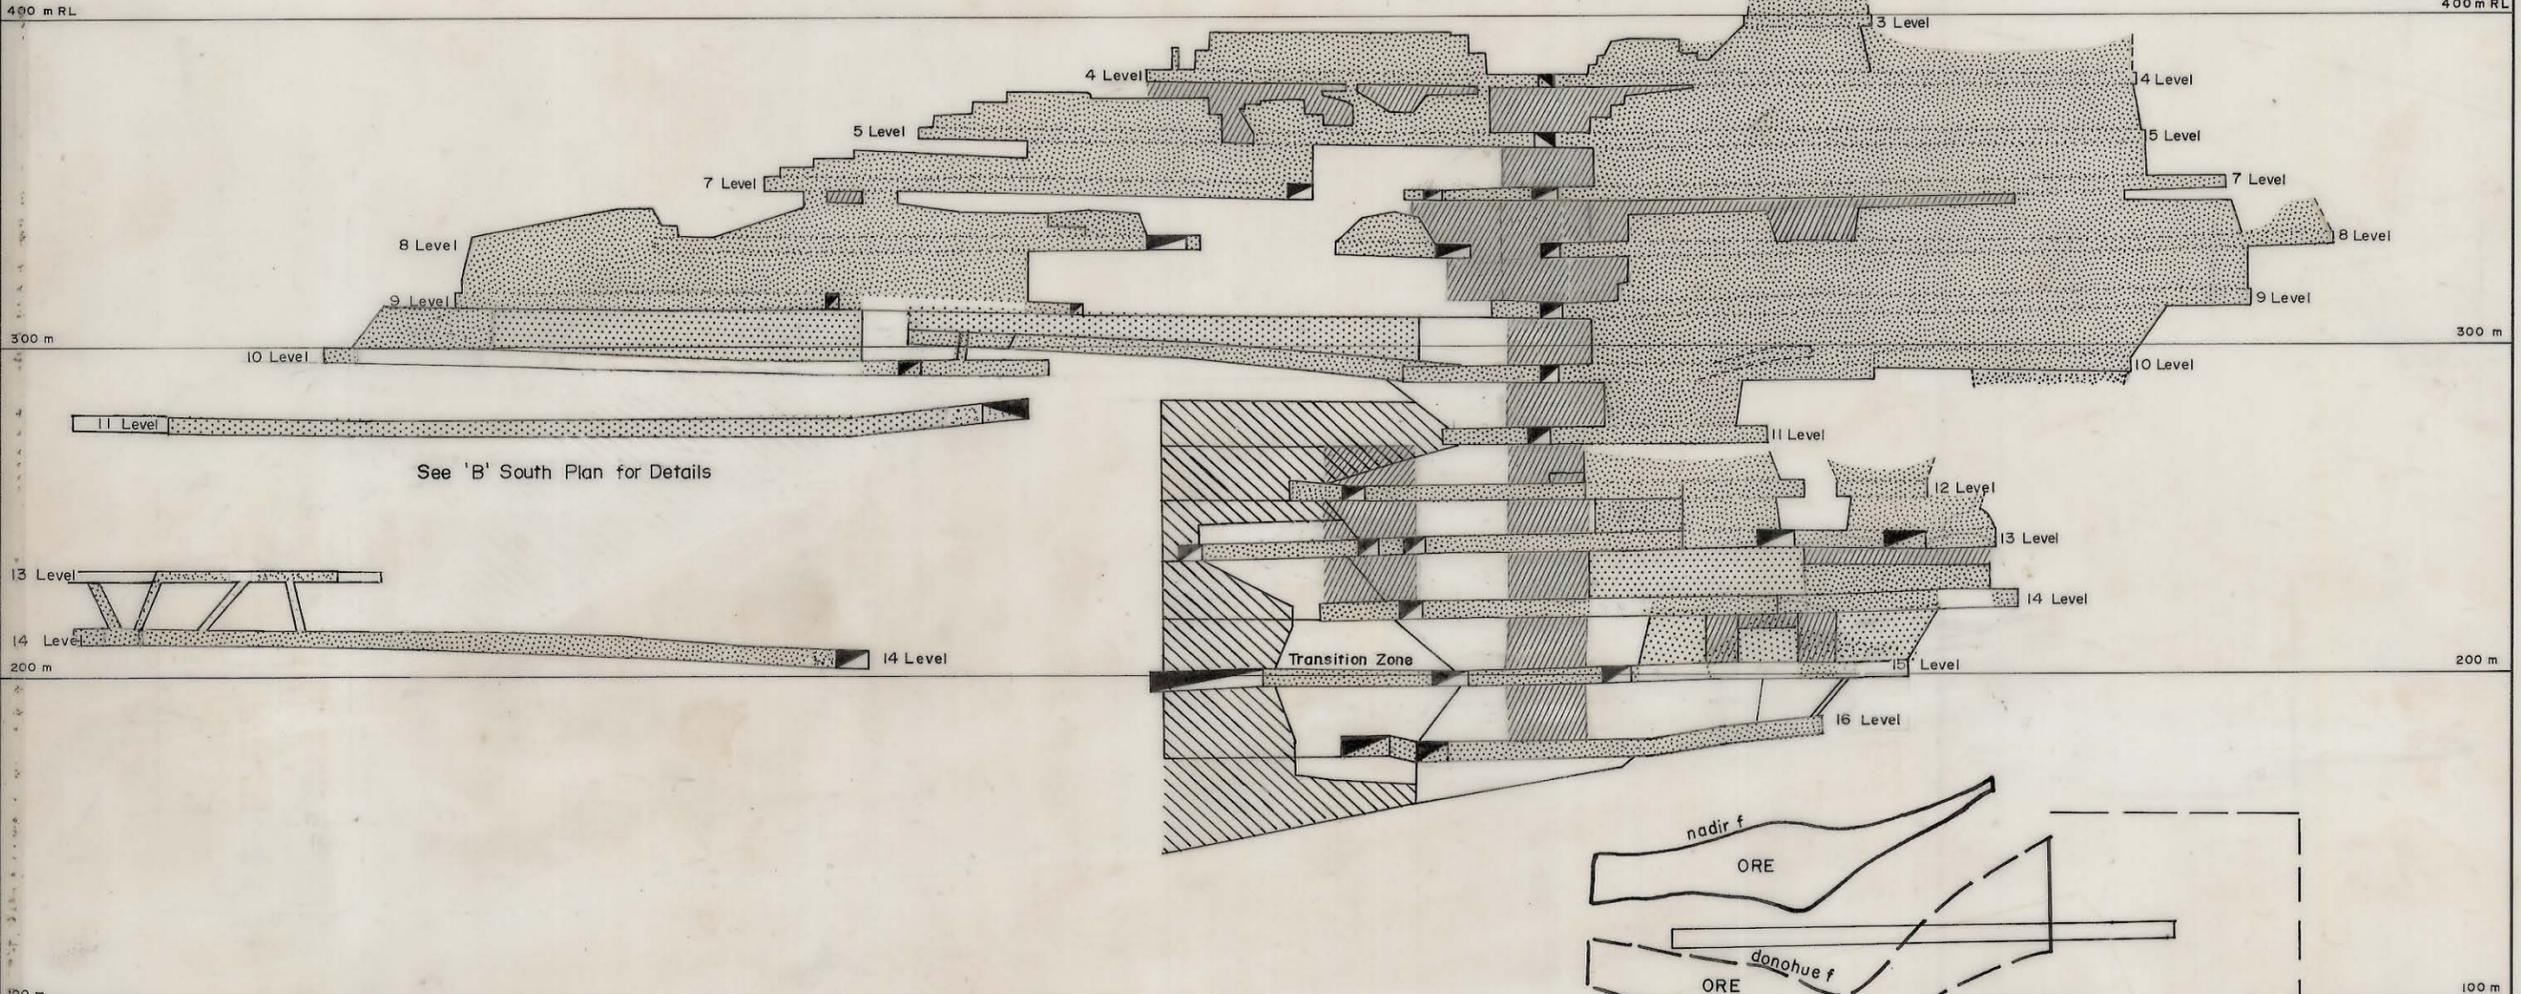



Gp Go Gn Gm Gl Gk Gj Gi Gh Gg Gf Ge Gd Gc Gb Ga G H I J K Ka L M N O P Q Qa Qb R S T U V Va W Wa

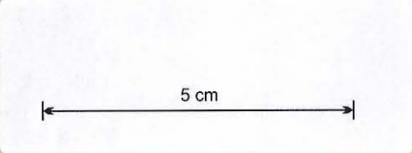

Gp Go Gn Gm Gl Gk Gj Gi Gh Gg Gf Ge Gd Gc Gb Ga G H I J K Ka L M N O P Q Qa Qb tulip f R S T U V Va W Wa

**LEGEND**

- Fault lines
- Area mined prior to Oct. 1978
- Area mined from OCT 1978 to FEB 1979
- Ore measured FEB 1979
- Internal pillars
- Ore indicated FEB 1979
- Ore indicated Low Grade - Sub Ore FEB 1979
- Ore inferred FEB 1979
- Broken Ore 1979

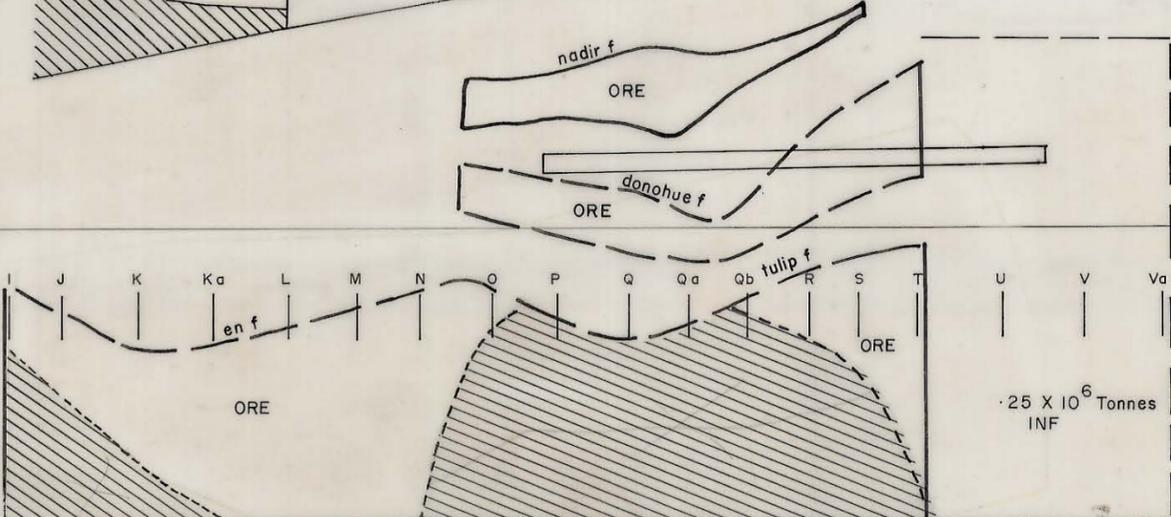

**CLEVELAND TIN LTD. — TASMANIA**

SURVEYED		<b>CLEVELAND MINE LONGITUDINAL PROJECTION A &amp; B LENS</b>	DRAWING N°
DRAWN	T. Tulp		<b>LP-14S</b>
TRACED	J.I.H.		
CHECKED			
APP'D C/SURV.		SCALE 1: 2000	DATE FEB 1979
APP'D M/SUPT.		SHEET	

0216\_623