

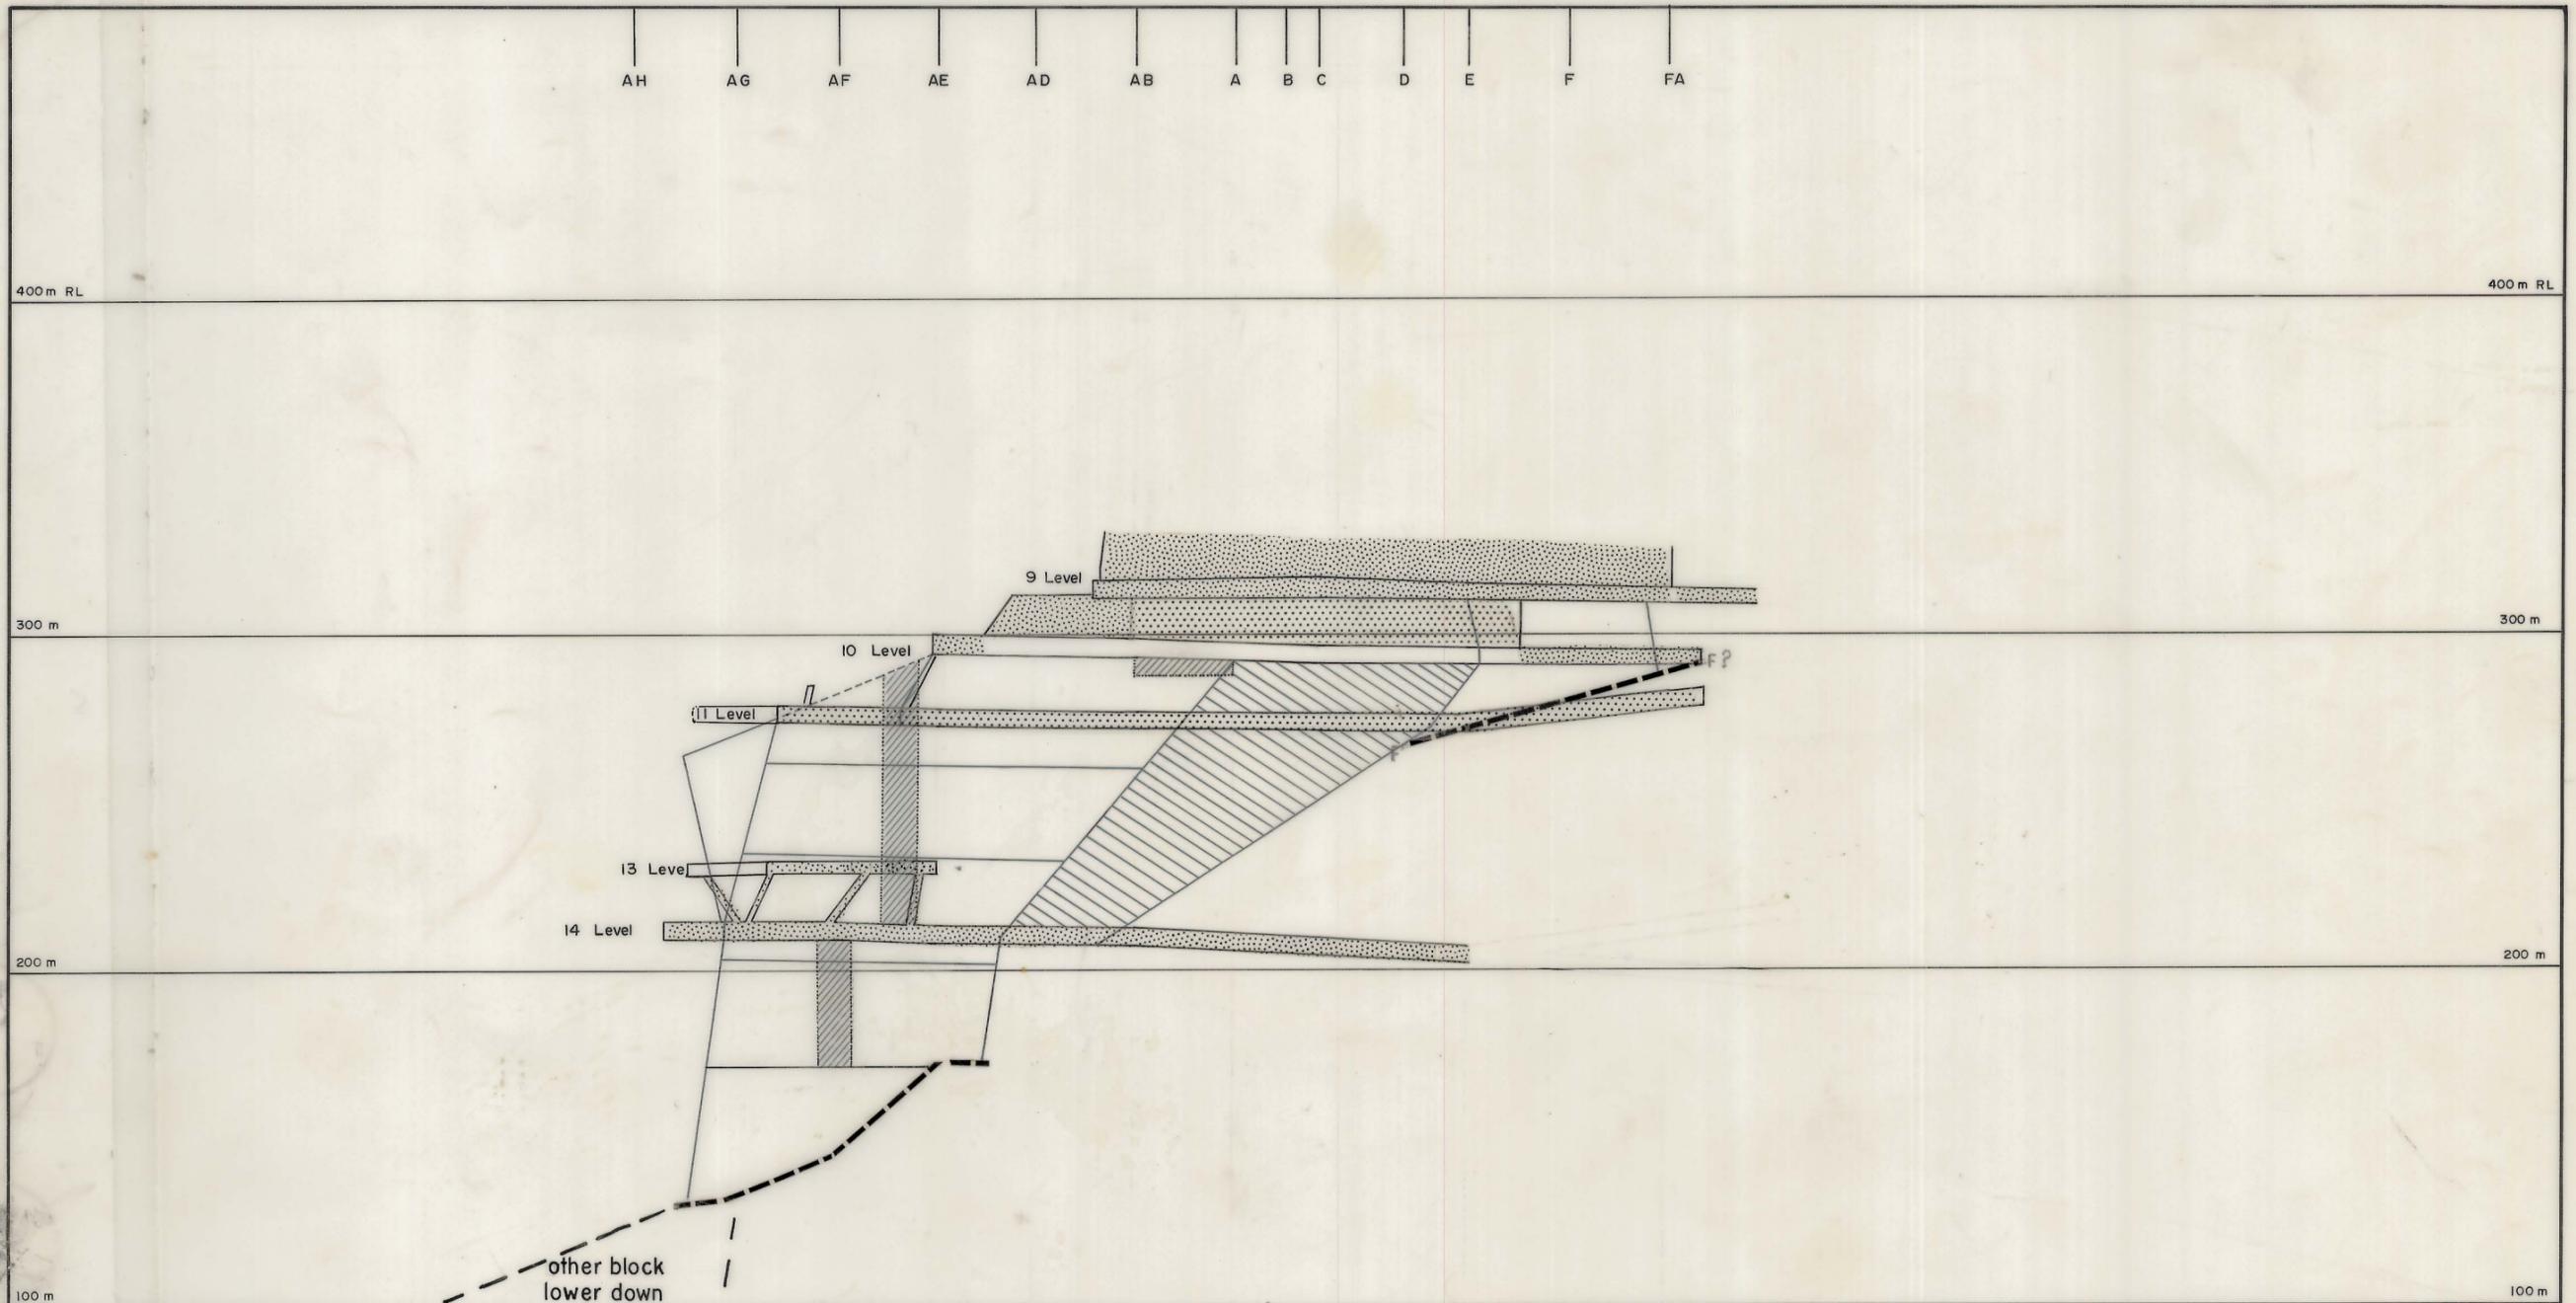
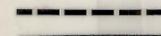
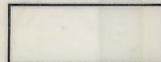
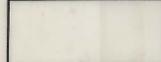
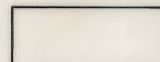
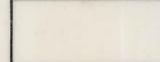


0216\_641

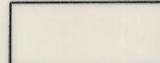

**LEGEND**

-  Fault lines
-  Area mined prior to Oct. 1978
-  Area mined from Oct. 1978 to FEB 1979
-  Ore measured FEB 1979
-  Internal pillars
-  Ore indicated FEB 1979
-  Ore indicated Low Grade - Sub Ore FEB 1979
-  Ore inferred FEB 1979
-  Broken ore 1979

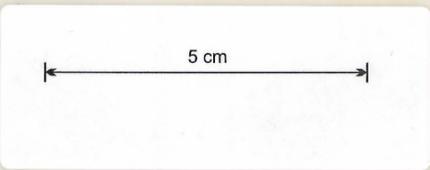

**CLEVELAND TIN LTD. — TASMANIA**

SURVEYED		<b>CLEVELAND MINE LONGITUDINAL PROJECTION BATTERY 'B' SOUTH</b>	DRAWING N°	
DRAWN	T. Tulp		<b>LP-18S</b>	
TRACED	J. I. H.			
CHECKED				
APP'D C/SURV.				
APP'D M/SUPT.		SCALE 1:2000	DATE: FEB 1979	SHEET