

J Section

I Section

H Section

G Section

Ga Section

Gb Section

Gc Section

J Section

I Section


H Section

G Section

Ga Section

Gb Section

Gc Section

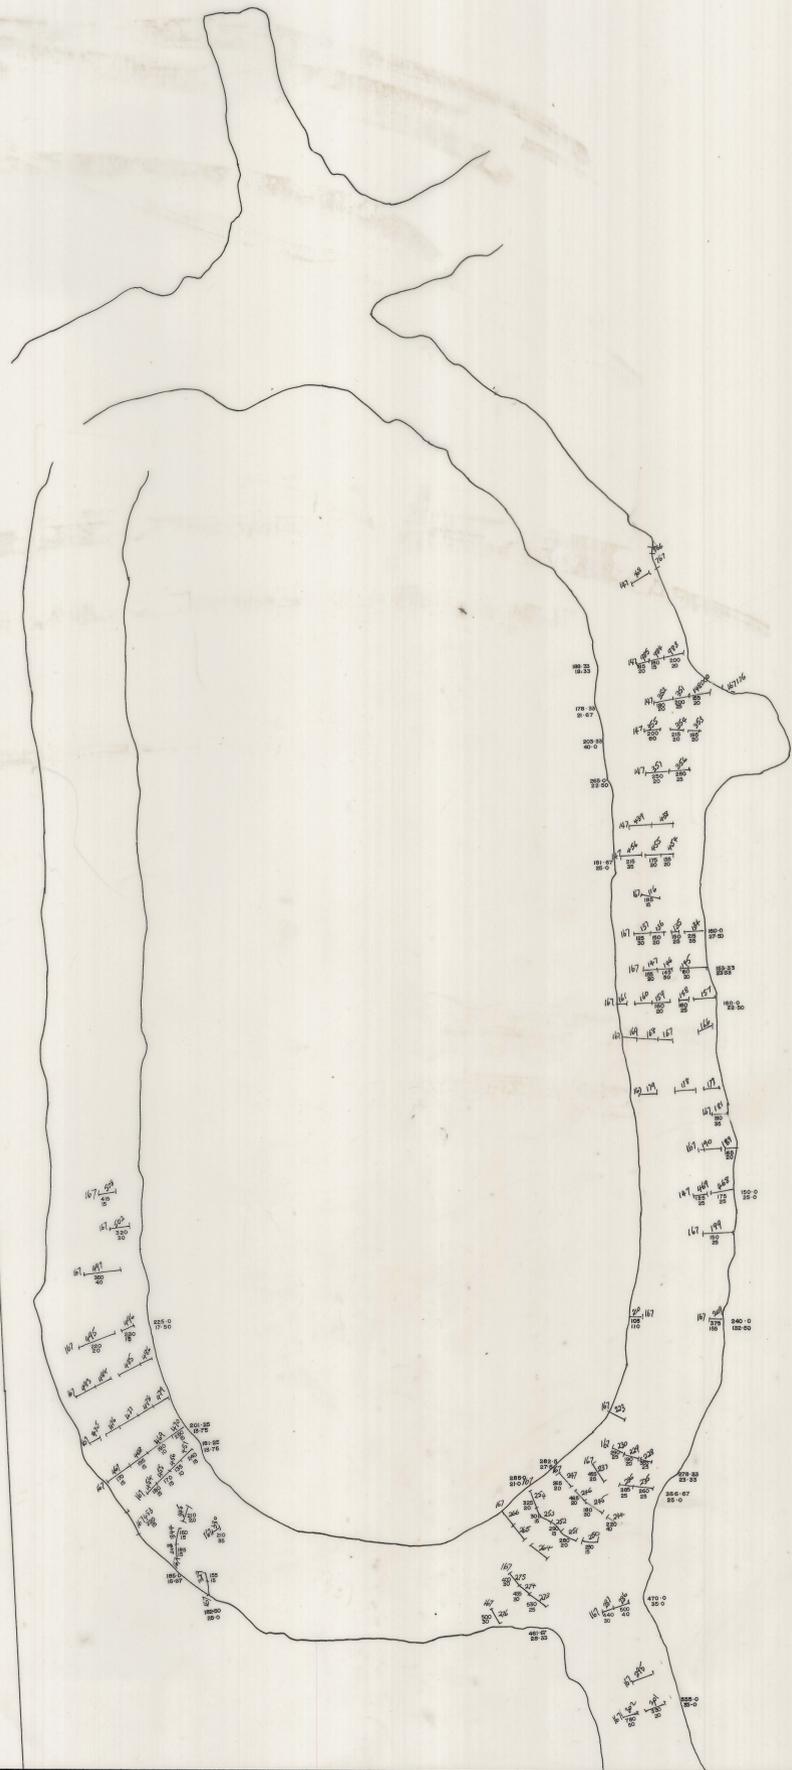

Abminco Exploration	
Drawn by:	Location code:
Traced:	Date:
Checked:	Scale:
Revised by:	Plan No:
Date:	

Cleveland Mine
14-15 Decline

SAMPLES
Zn
Pb

0216_789