

Section W

Section Va

Section V

Section U

Section T


Section W

Section Va

Section V

Section U

Section T

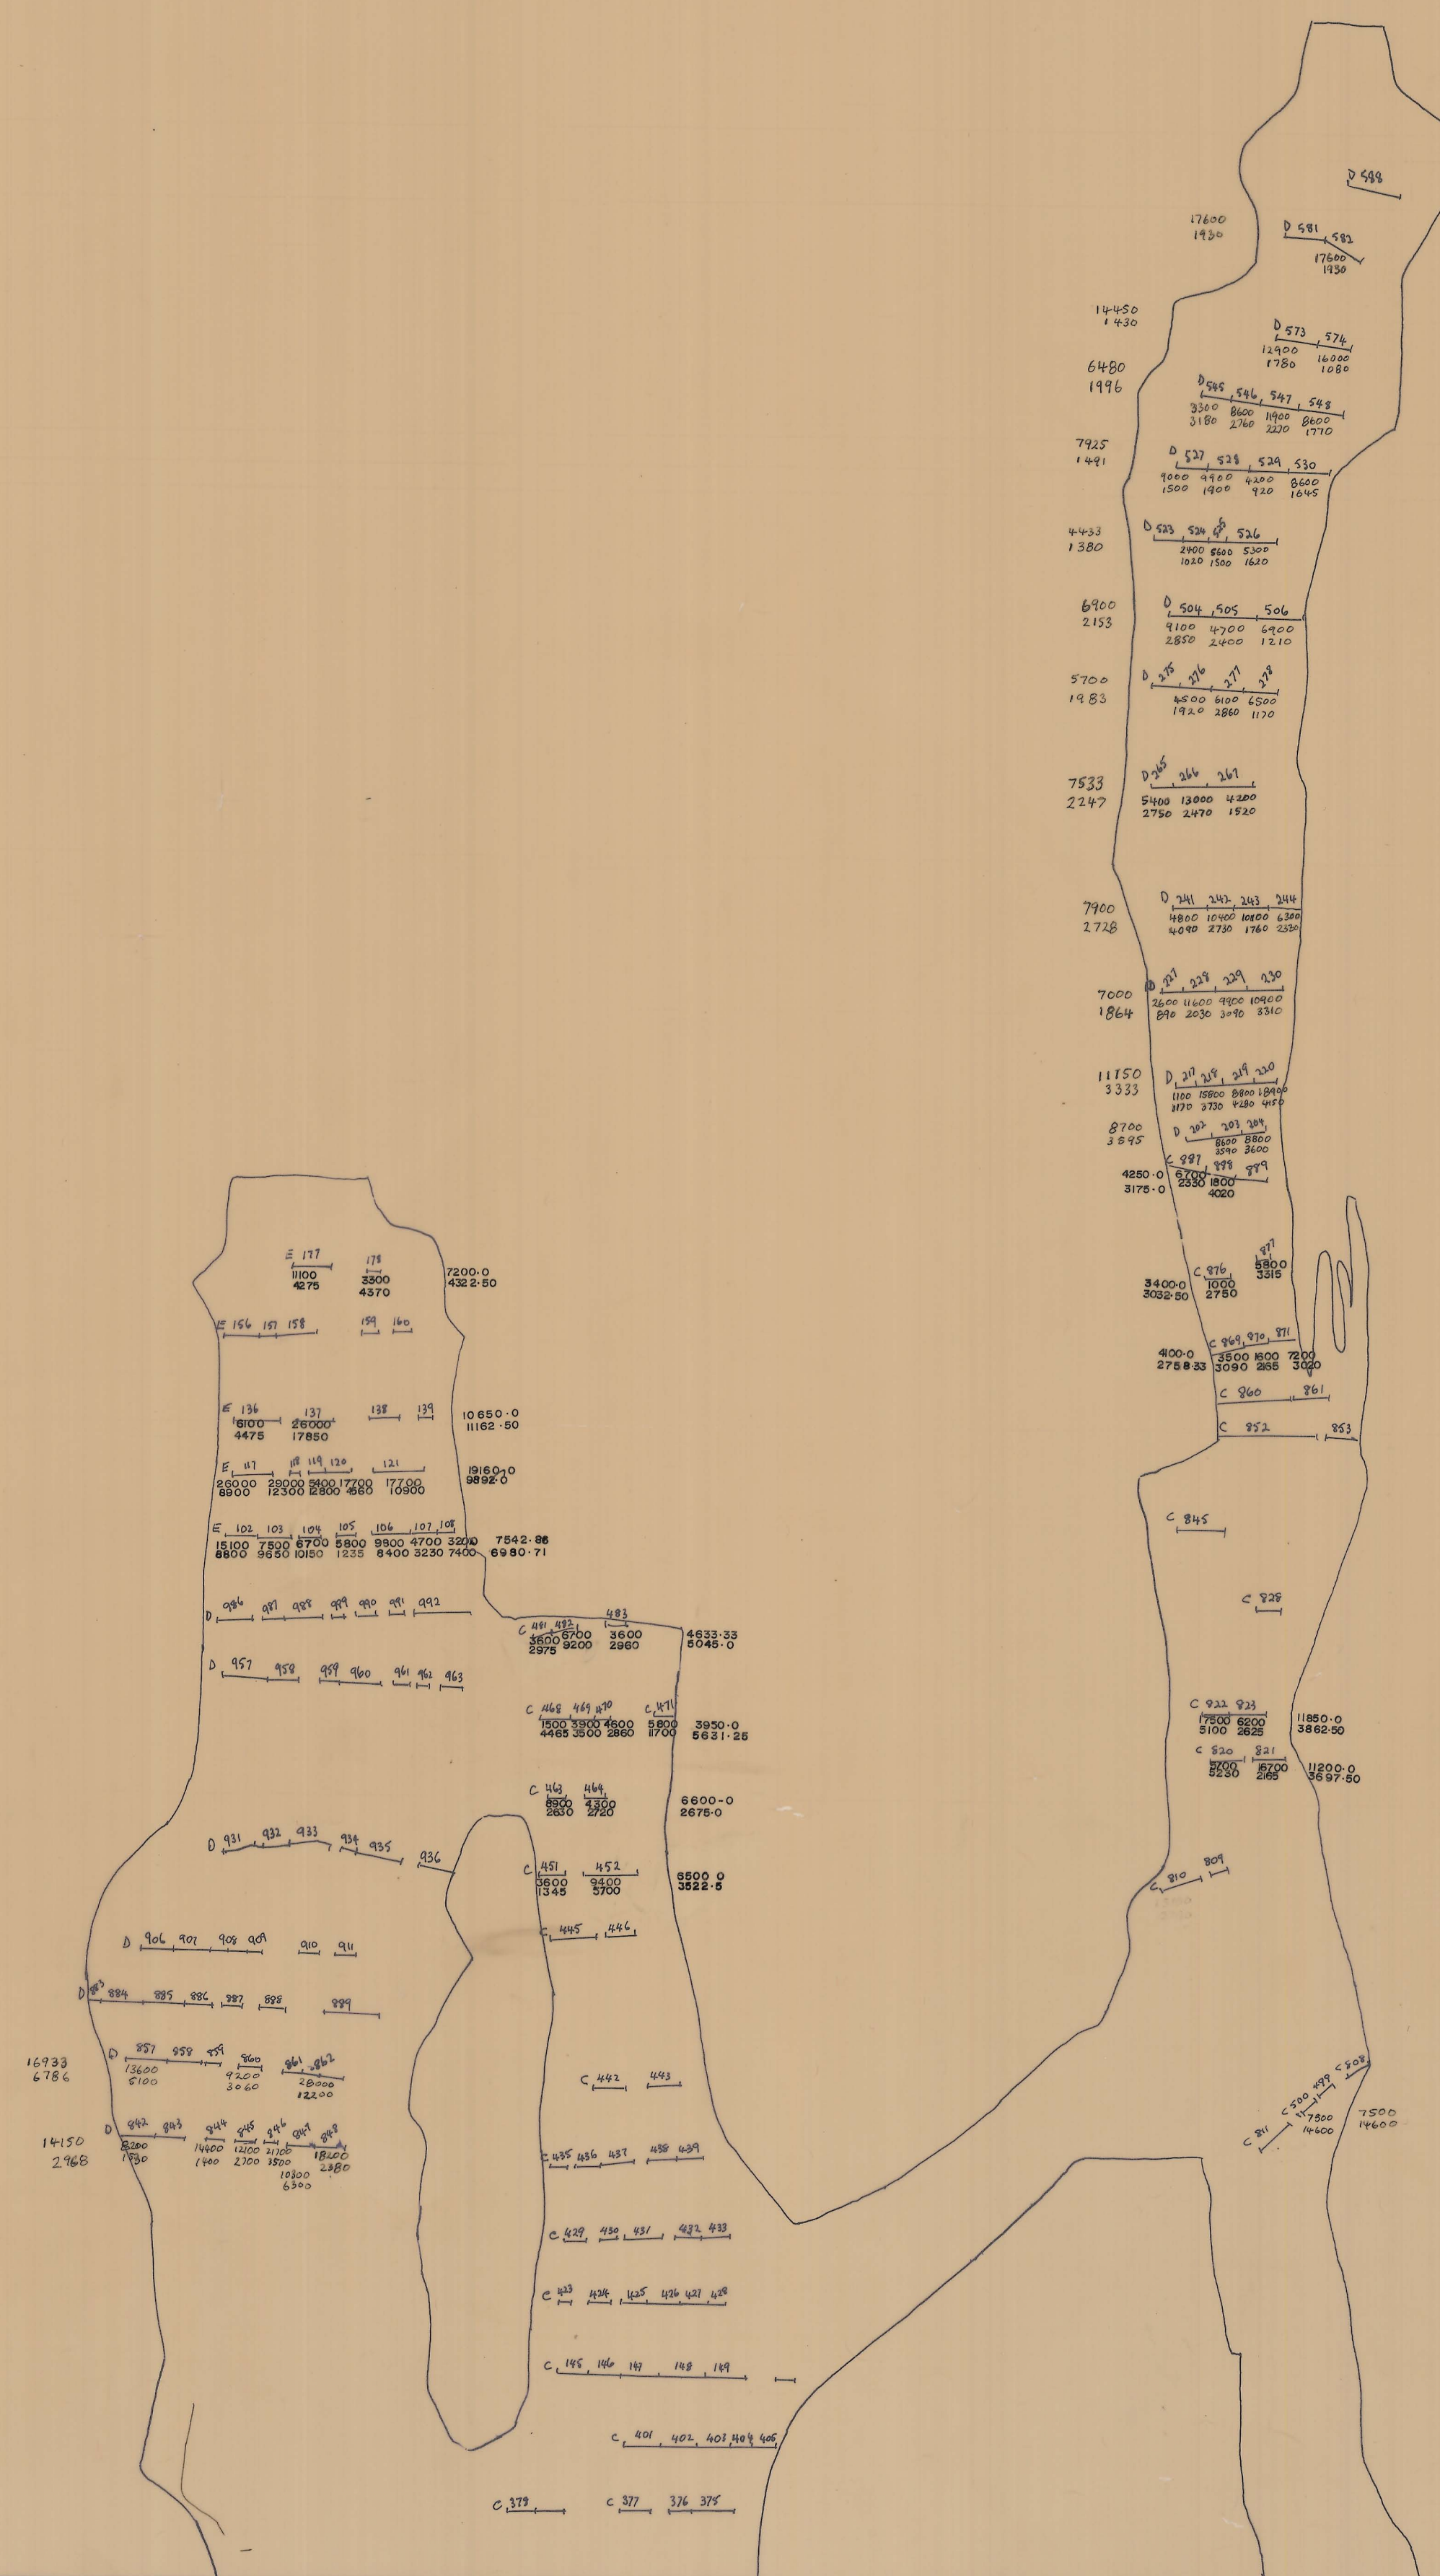

Abminco Exploration	
Geology:	CLEVELAND MINE 10 LEVEL
Drawn:	SHEET V
Traced:	SAMPLES
Checked:	DATE
Revised by:	DATE
Location code:	
Date:	
Scale:	
Plate No:	