

Section Ge

Section Gd

Section Ge

Section Gf

Section Gg

Section Gh

Section Ge


Section Gd

Section Ge

Section Gf

Section Gg

Section Gh

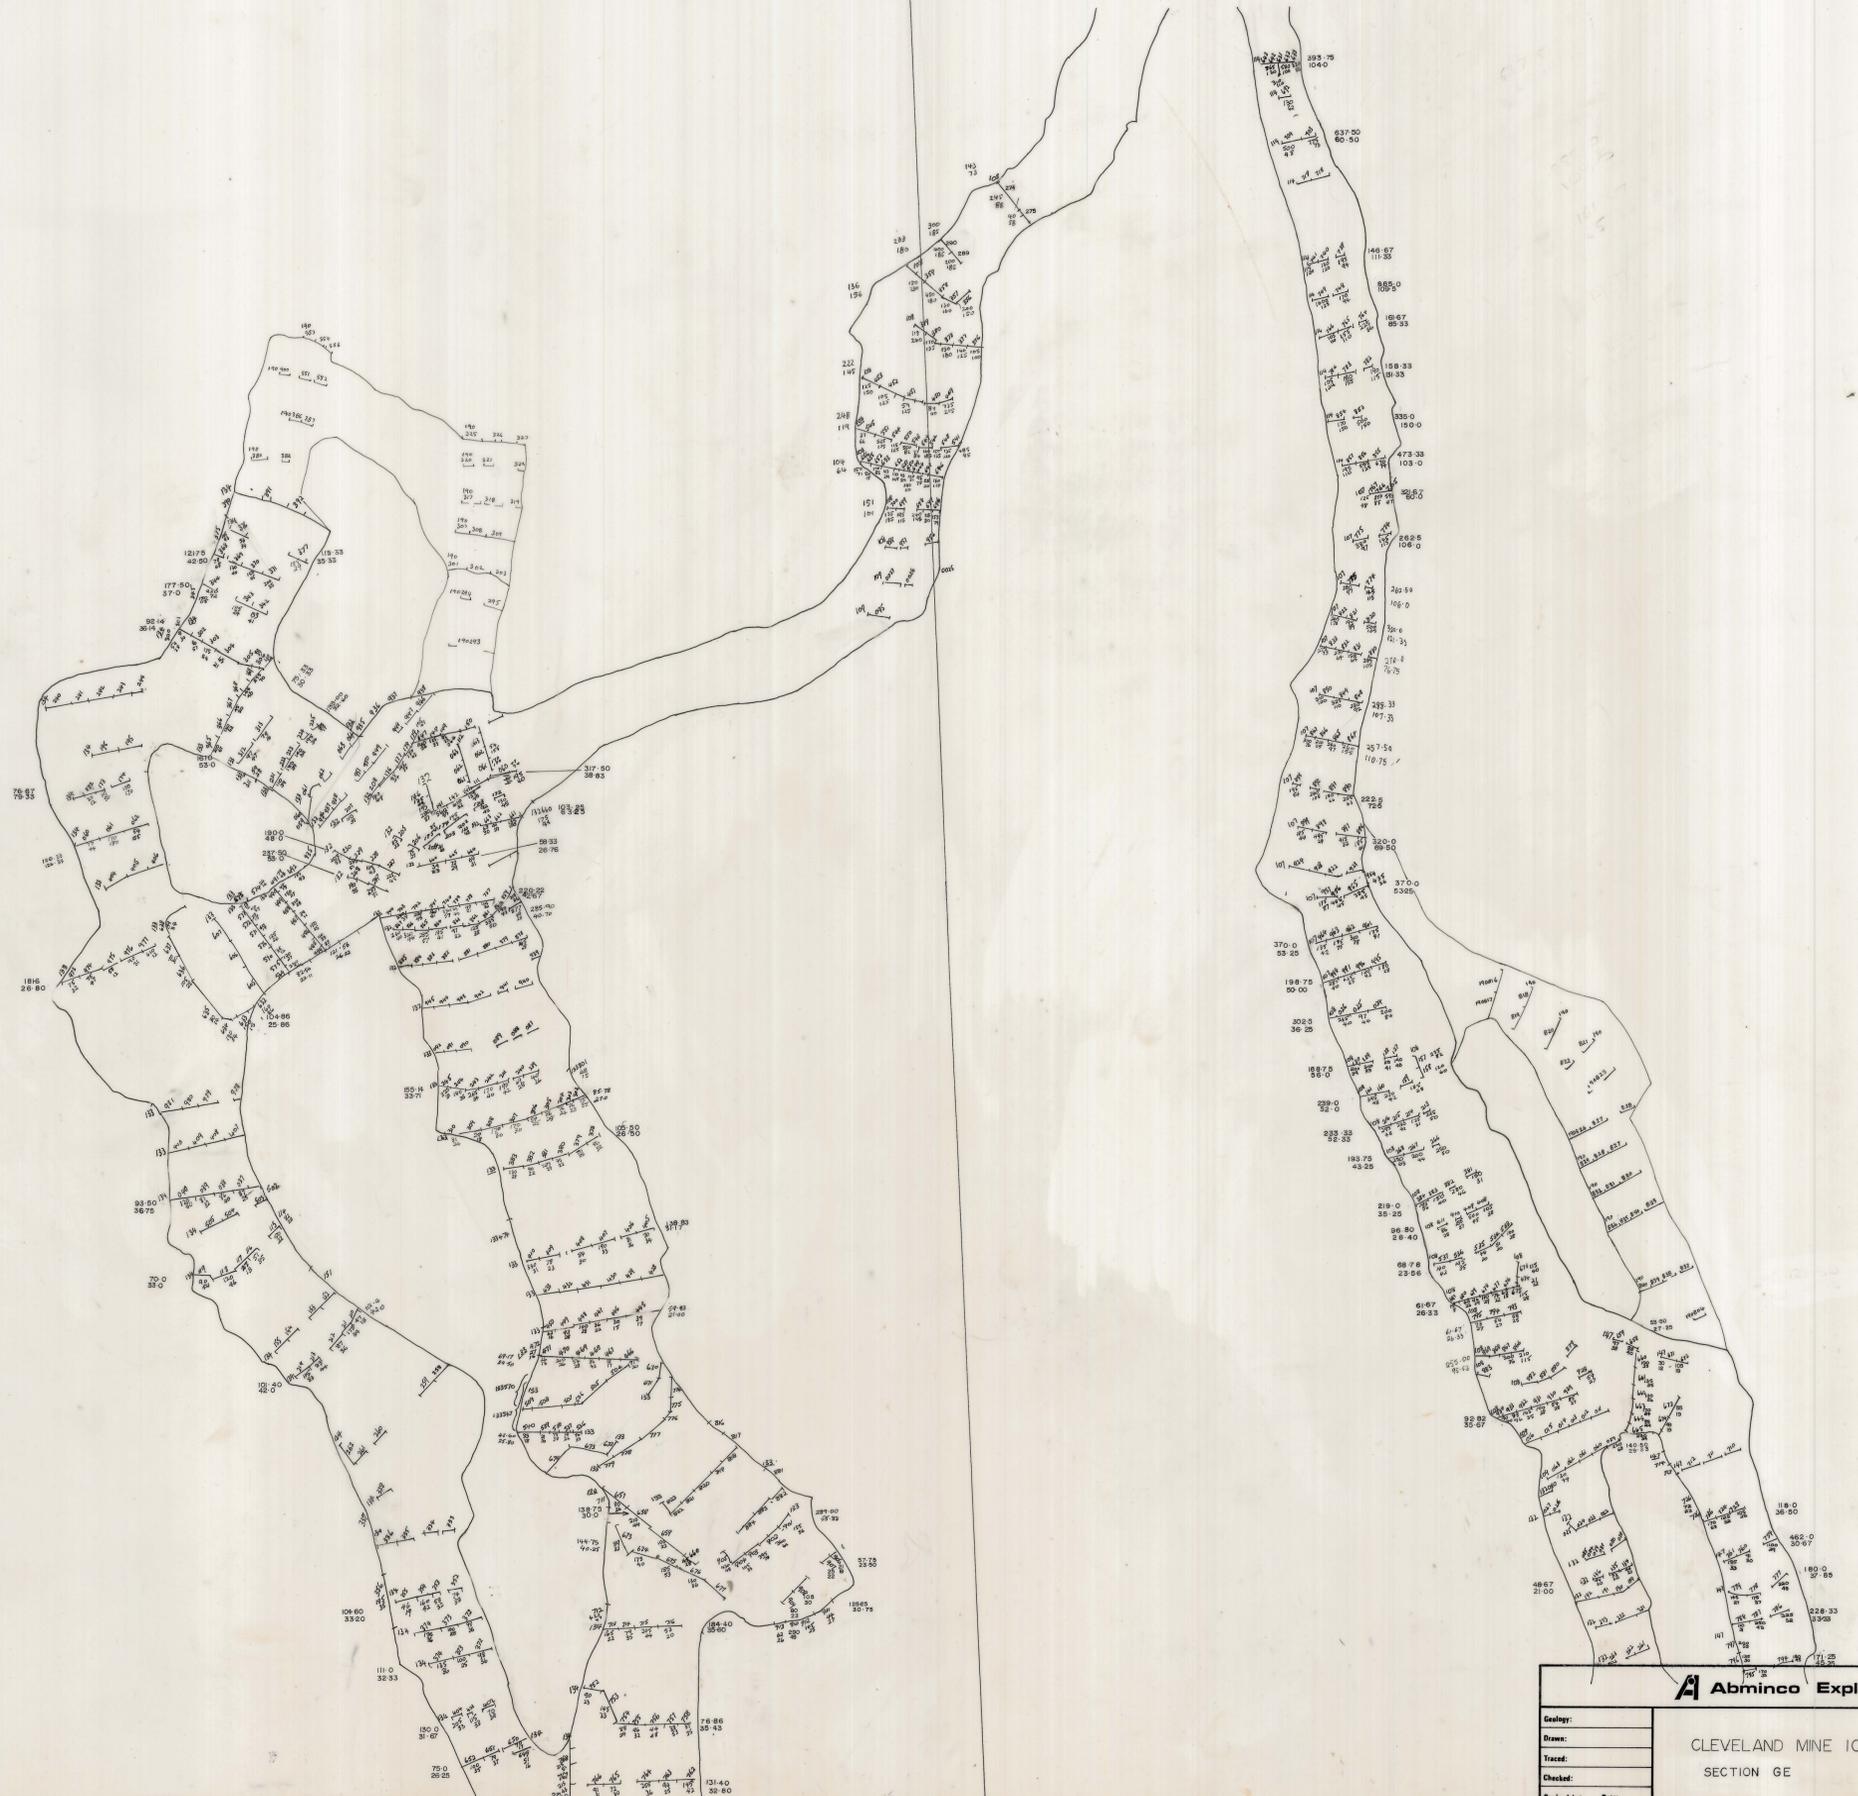

Abminco Exploration	
Geology:	Location code:
Drawn:	Date:
Traced:	Scale:
Checked:	Plate No:
Revised by: Date:	SAMPLES SI Co