


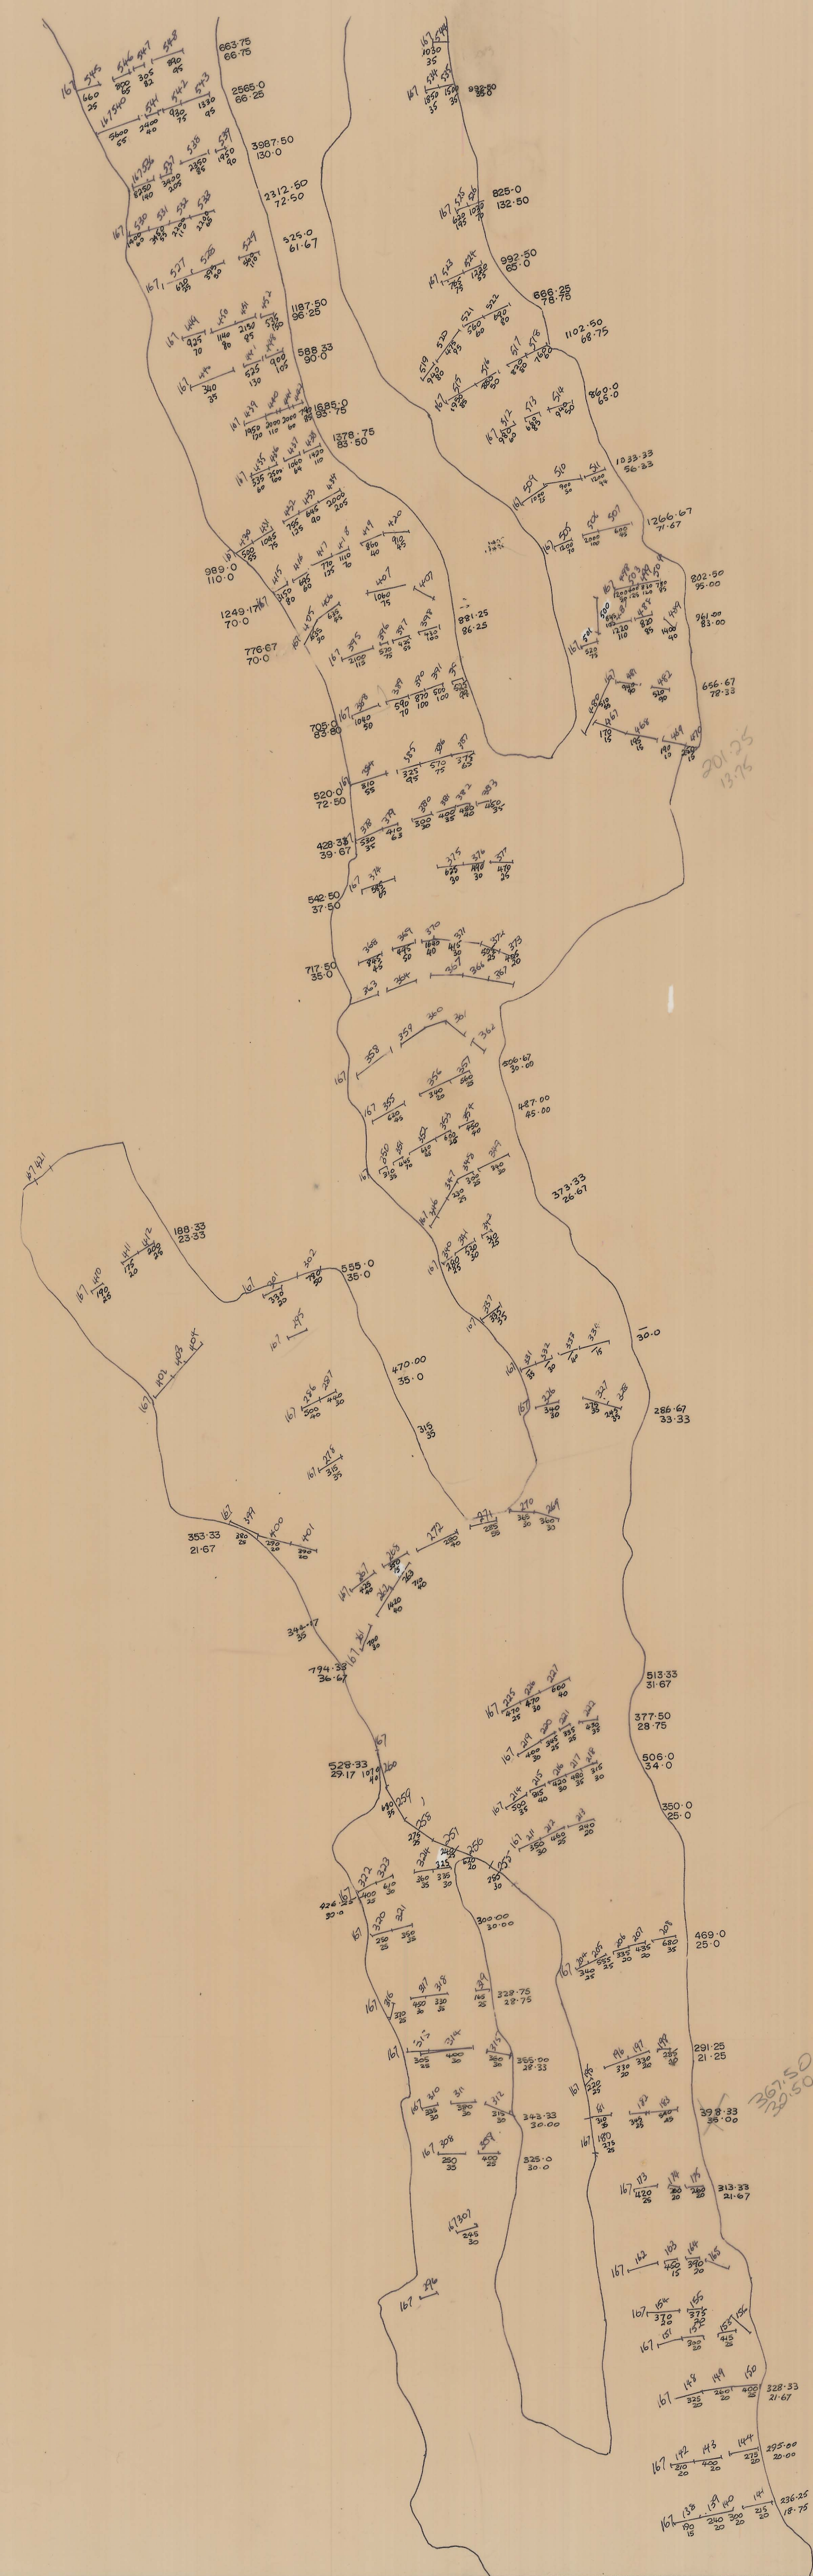

 Abminco Exploration		
Geology:	Cleveland Mine 14 Level Sheet P <i>Samples:</i> Zn Pb	
Drawn:		
Trailed:		
Checked:		
Revised by: Date:		
		Location code: Date: Scale: Plate NO