

Gj Section

Gk Section

Gl Section

Gm Section

Gn Section

Go Section

Gj Section


Gk Section

Gl Section

Gm Section

Gn Section

Go Section

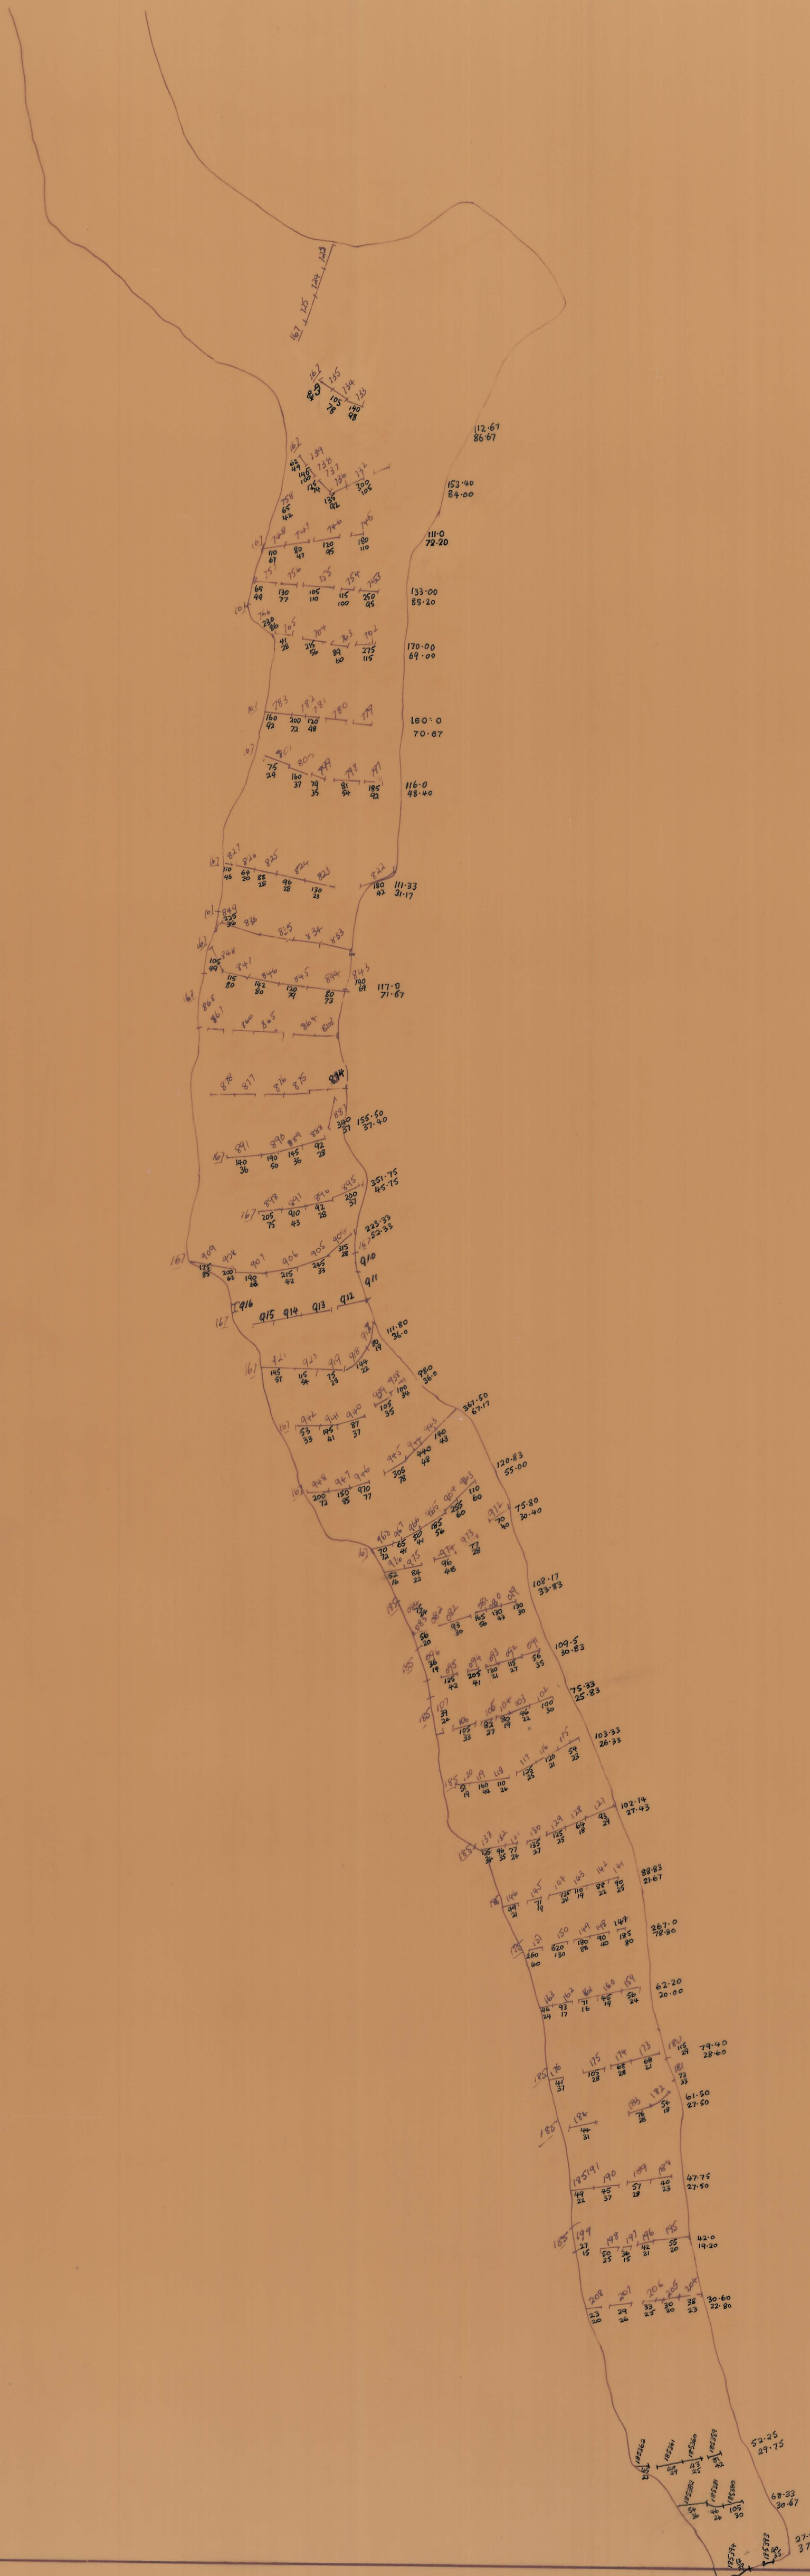

Abminco Exploration		
Geology:	CLEVELAND MINE 14 B South	Location code:
Drawn:		Date:
Traced:		Scale:
Checked:		Plate No:
Revised by:		Date:

02/16_818