



6000 N

5500 N


5000 N

1500 E

2000 E

2500 E

3000 E

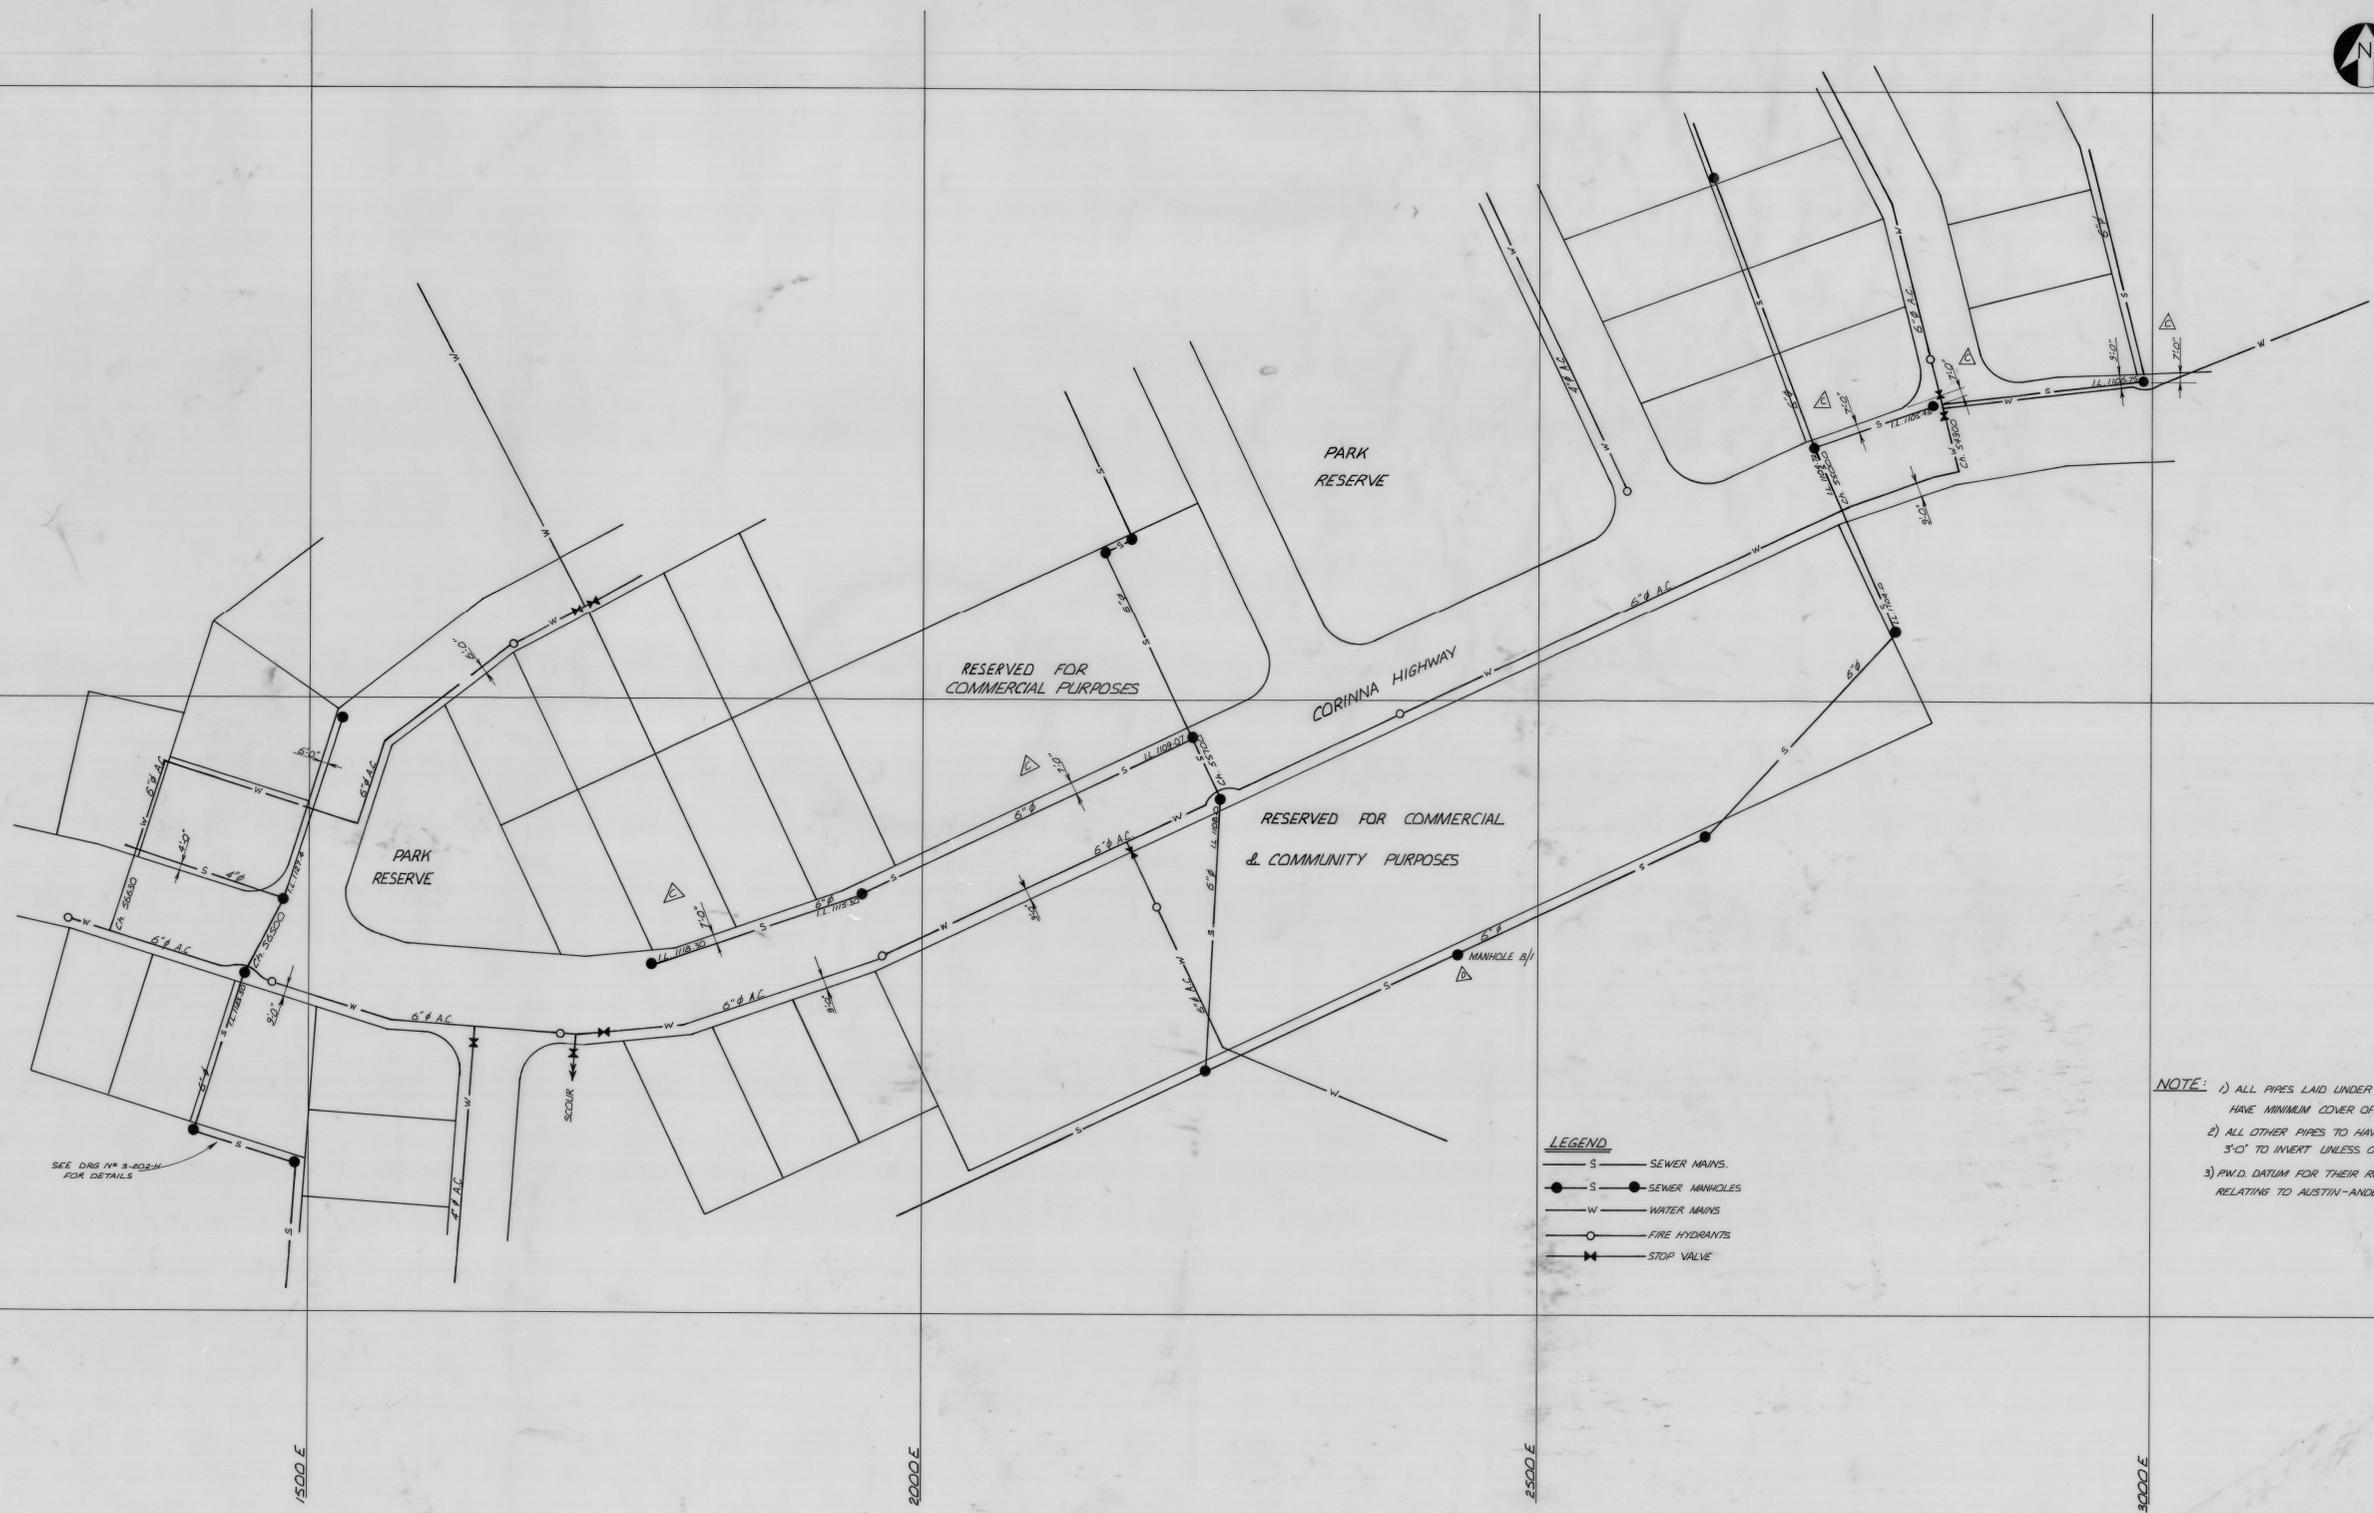

SEE DRG NO 3-802-N FOR DETAILS


LEGEND

- S — SEWER MAINS.
- S ● SEWER MANHOLES
- W — WATER MAINS
- ○ FIRE HYDRANTS
- ✕ ✕ STOP VALVE

- NOTE:**
- 1) ALL PIPES LAID UNDER ROAD PAVEMENTS, TO HAVE MINIMUM COVER OF 3'6" TO INVERT.
 - 2) ALL OTHER PIPES TO HAVE MINIMUM COVER OF 3'0" TO INVERT UNLESS OTHERWISE SHOWN
 - 3) P.W.D. DATUM FOR THEIR ROADWORKS IS +427.55' RELATING TO AUSTIN-ANDERSON DATUM.

TRACED FROM A.A. 9-212-D.

ABMINCO N.L.		DRAWN	
CLEVELAND MINE LUINA TASMANIA 7321		SCALE	1"=60'
		DATE	SEPT 77
		CHECKED	
		APPROVED	
LOCATION OF SERVICES			
WARATAH-CORINNA HIGHWAY		MC-028-W	

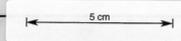

0216-852