
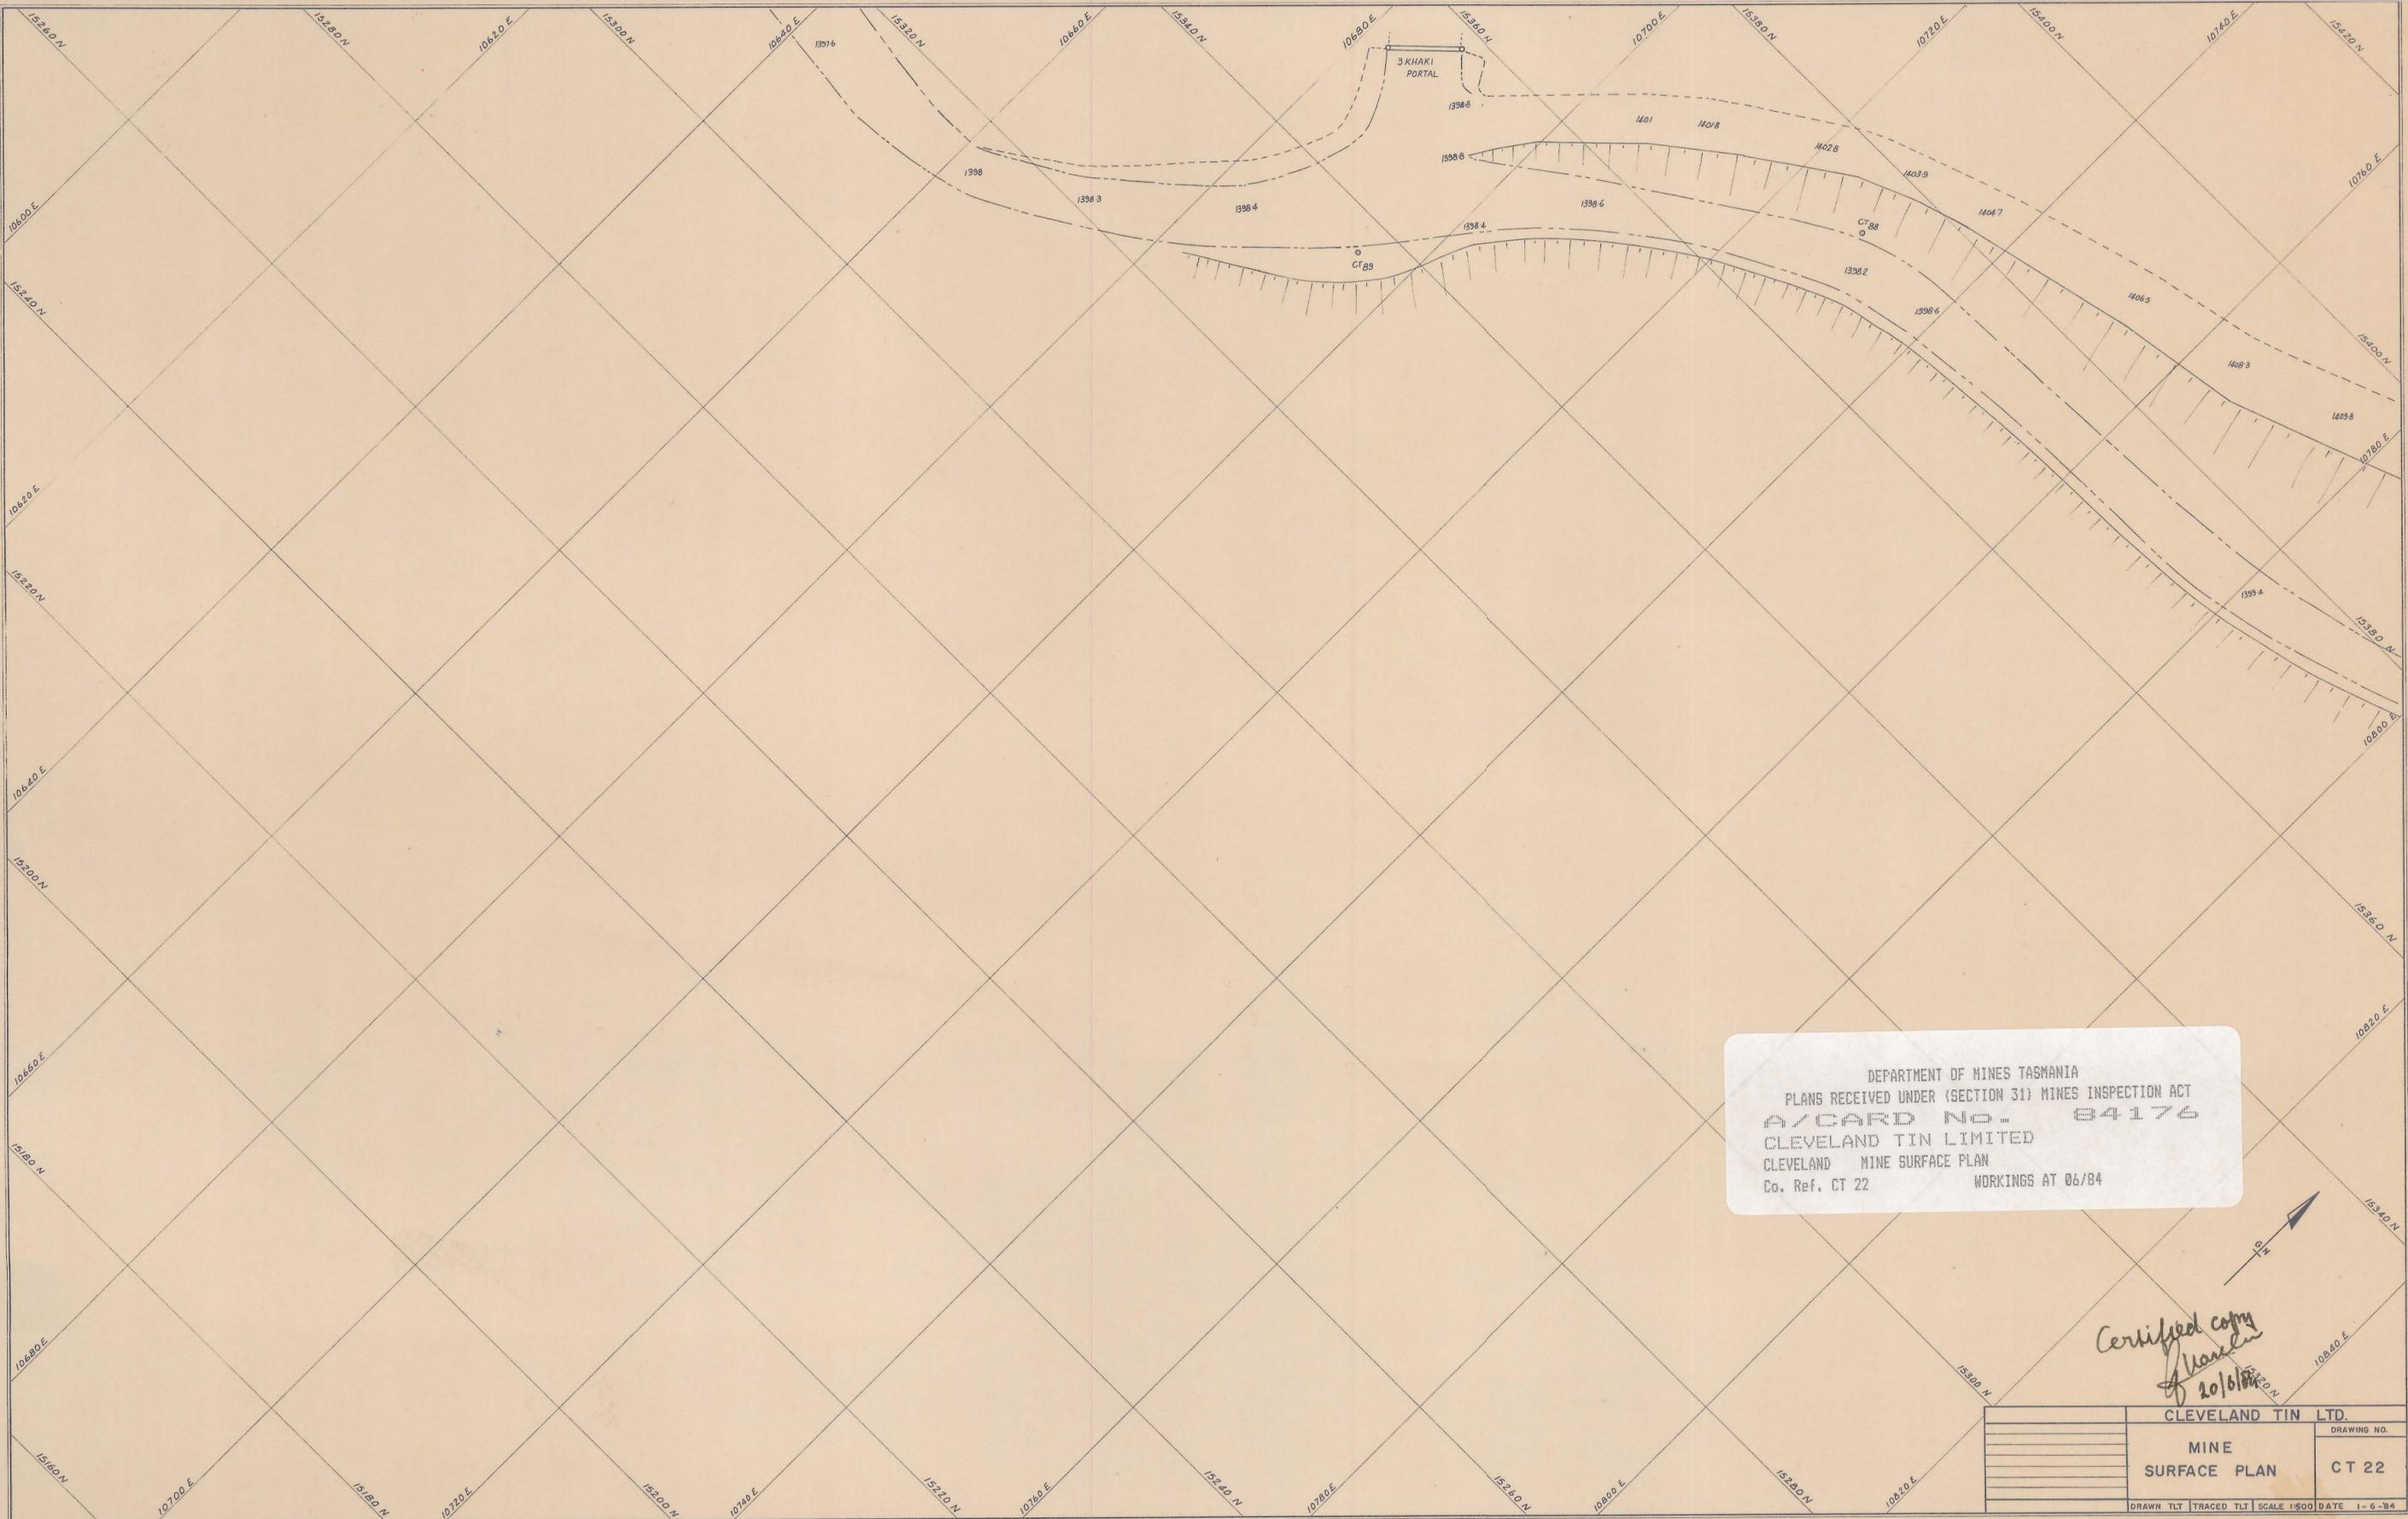


0216 - 856

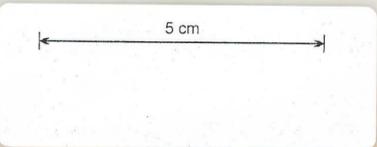

DEPARTMENT OF MINES TASMANIA  
PLANS RECEIVED UNDER (SECTION 31) MINES INSPECTION ACT  
A/CARD No. 84176  
CLEVELAND TIN LIMITED  
CLEVELAND MINE SURFACE PLAN  
Co. Ref. CT 22 WORKINGS AT 06/84

*Certified copy  
of plan  
20/6/84*

CLEVELAND TIN LTD.	
MINE SURFACE PLAN	DRAWING NO. CT 22
DRAWN TLT	TRACED TLT
SCALE 1:500	DATE 1-6-84