


0216 - 857

5 cm



DEPARTMENT OF MINES TASMANIA
 PLANS RECEIVED UNDER (SECTION 31) MINES INSPECTION ACT
A/CARD No. 84171
 CLEVELAND TIN LIMITED
 CLEVELAND MINE SURFACE PLAN
 Co. Ref. CT 10 WORKINGS AT 06/84

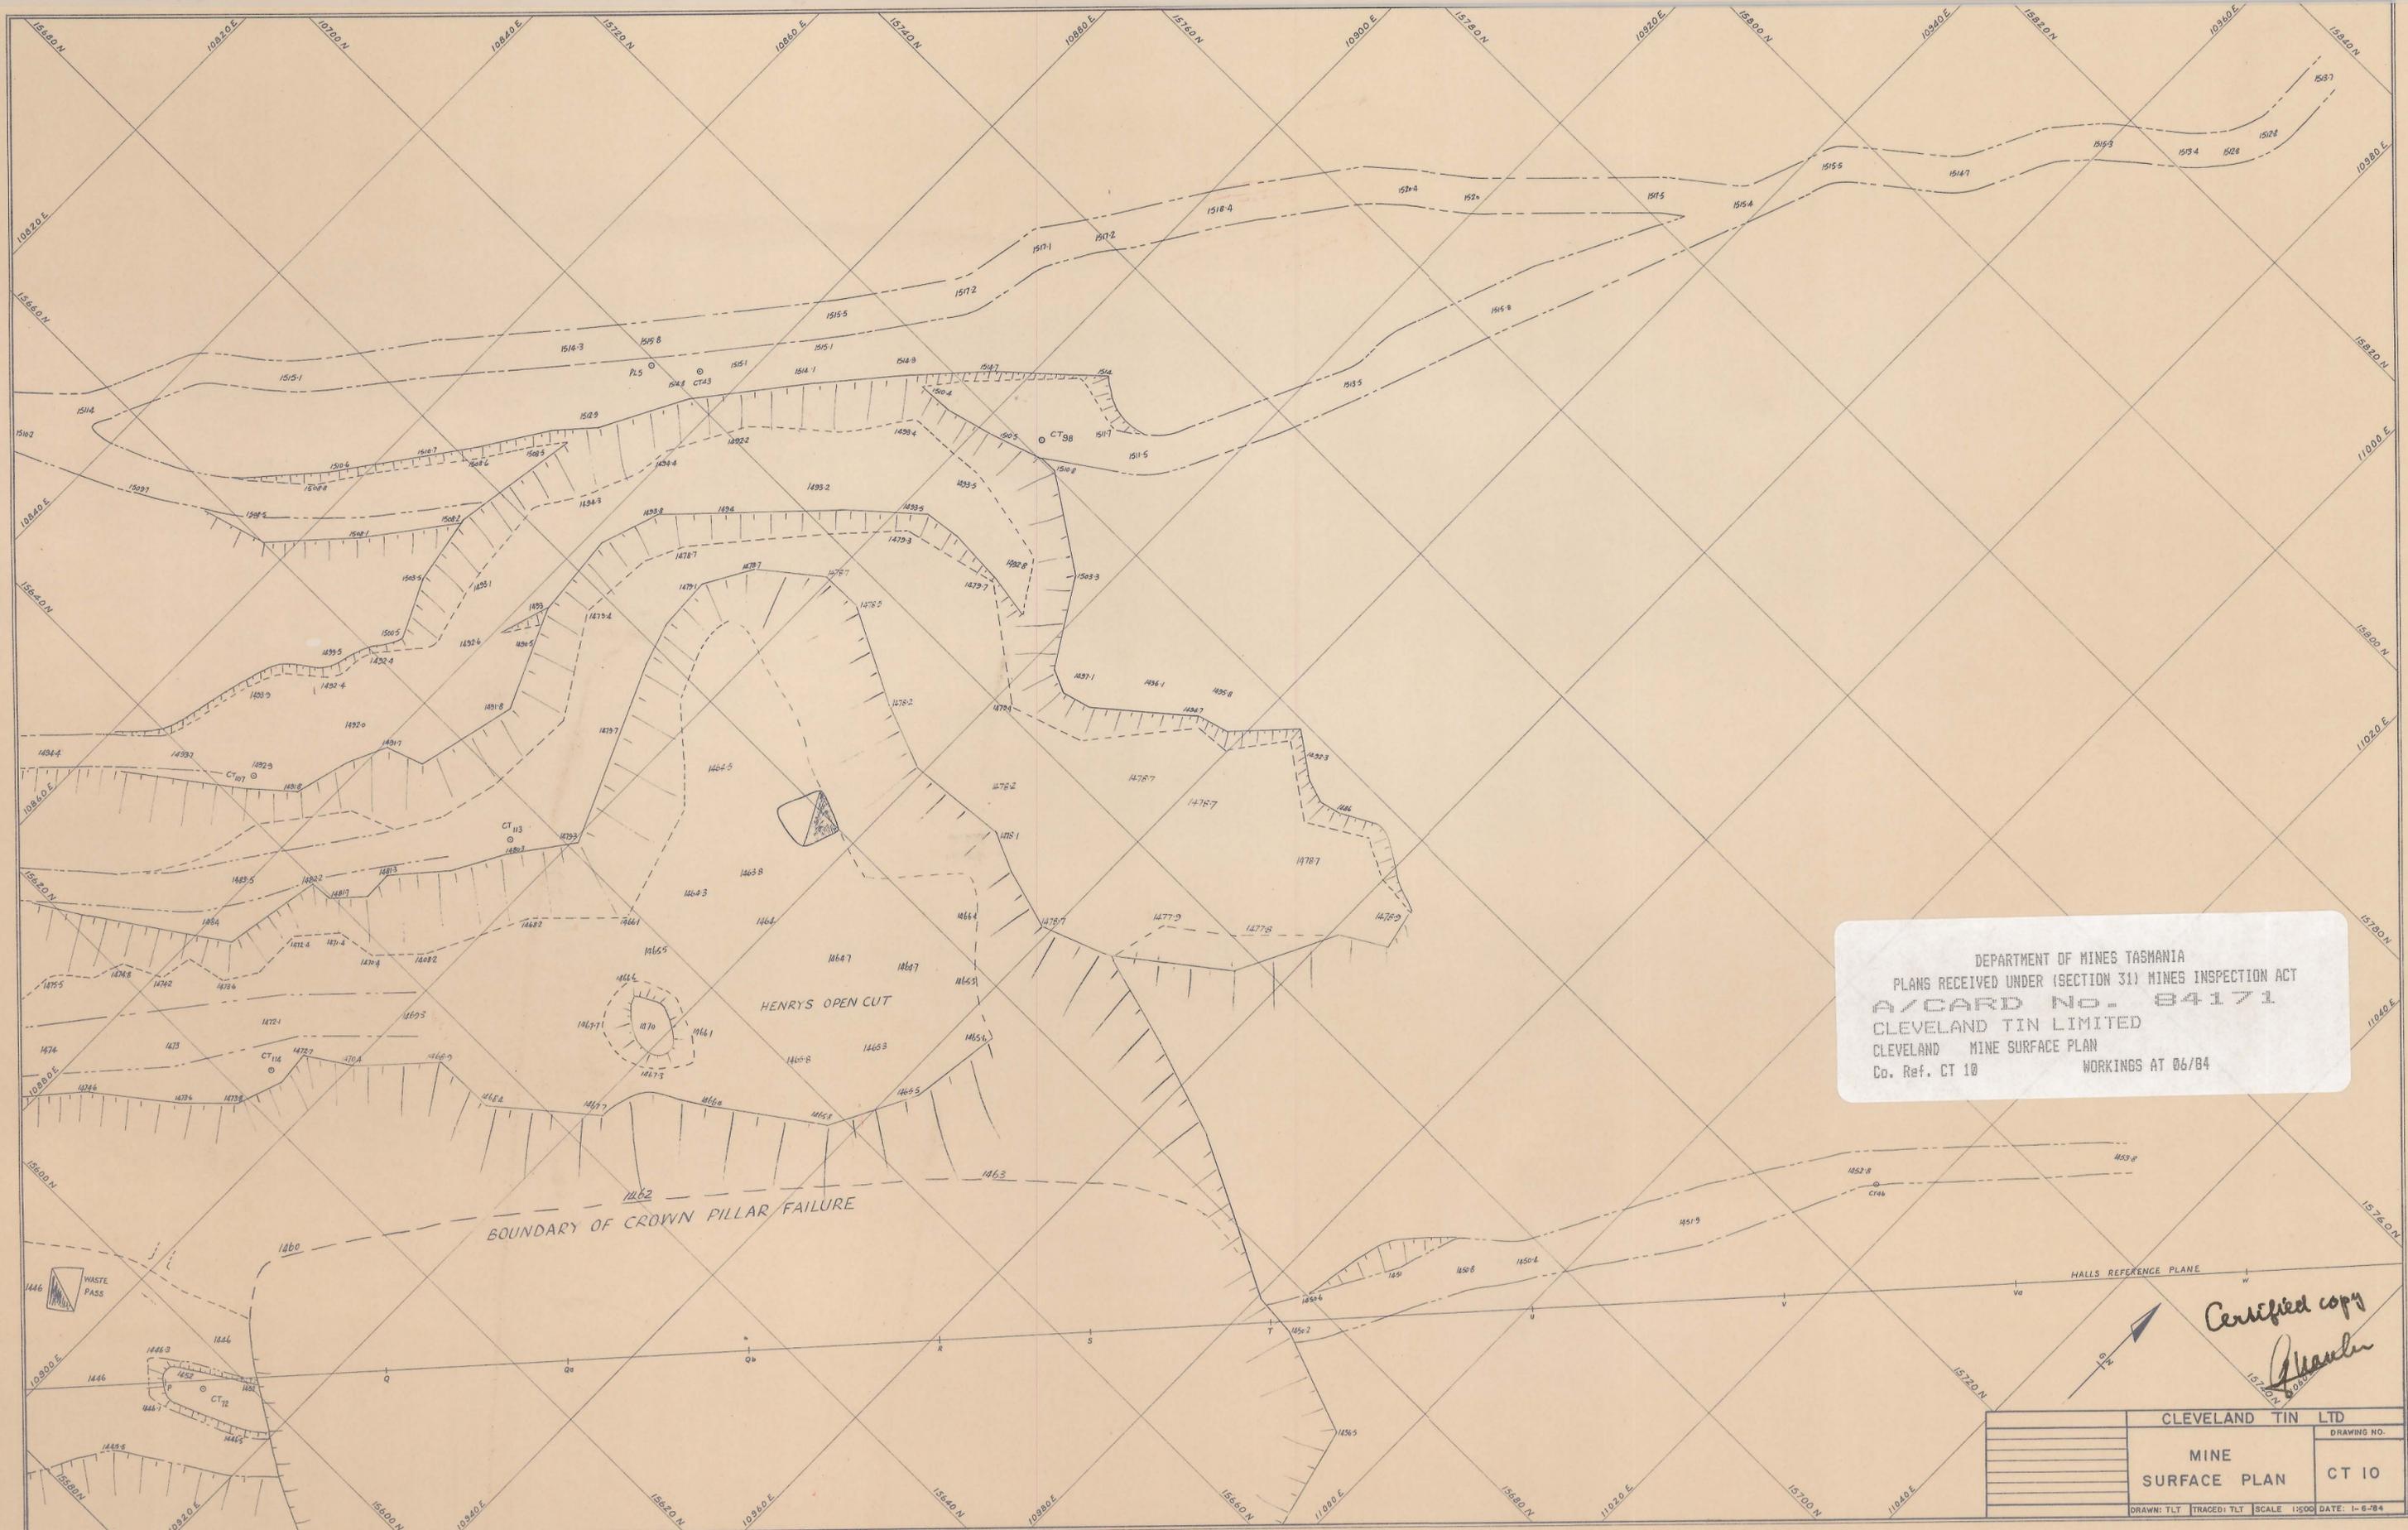

Certified copy
[Signature]

CLEVELAND TIN LTD	
MINE SURFACE PLAN	DRAWING NO. CT 10
DRAWN: TLT TRACED: TLT SCALE 1:500 DATE: 1-6-84	