



0216-858

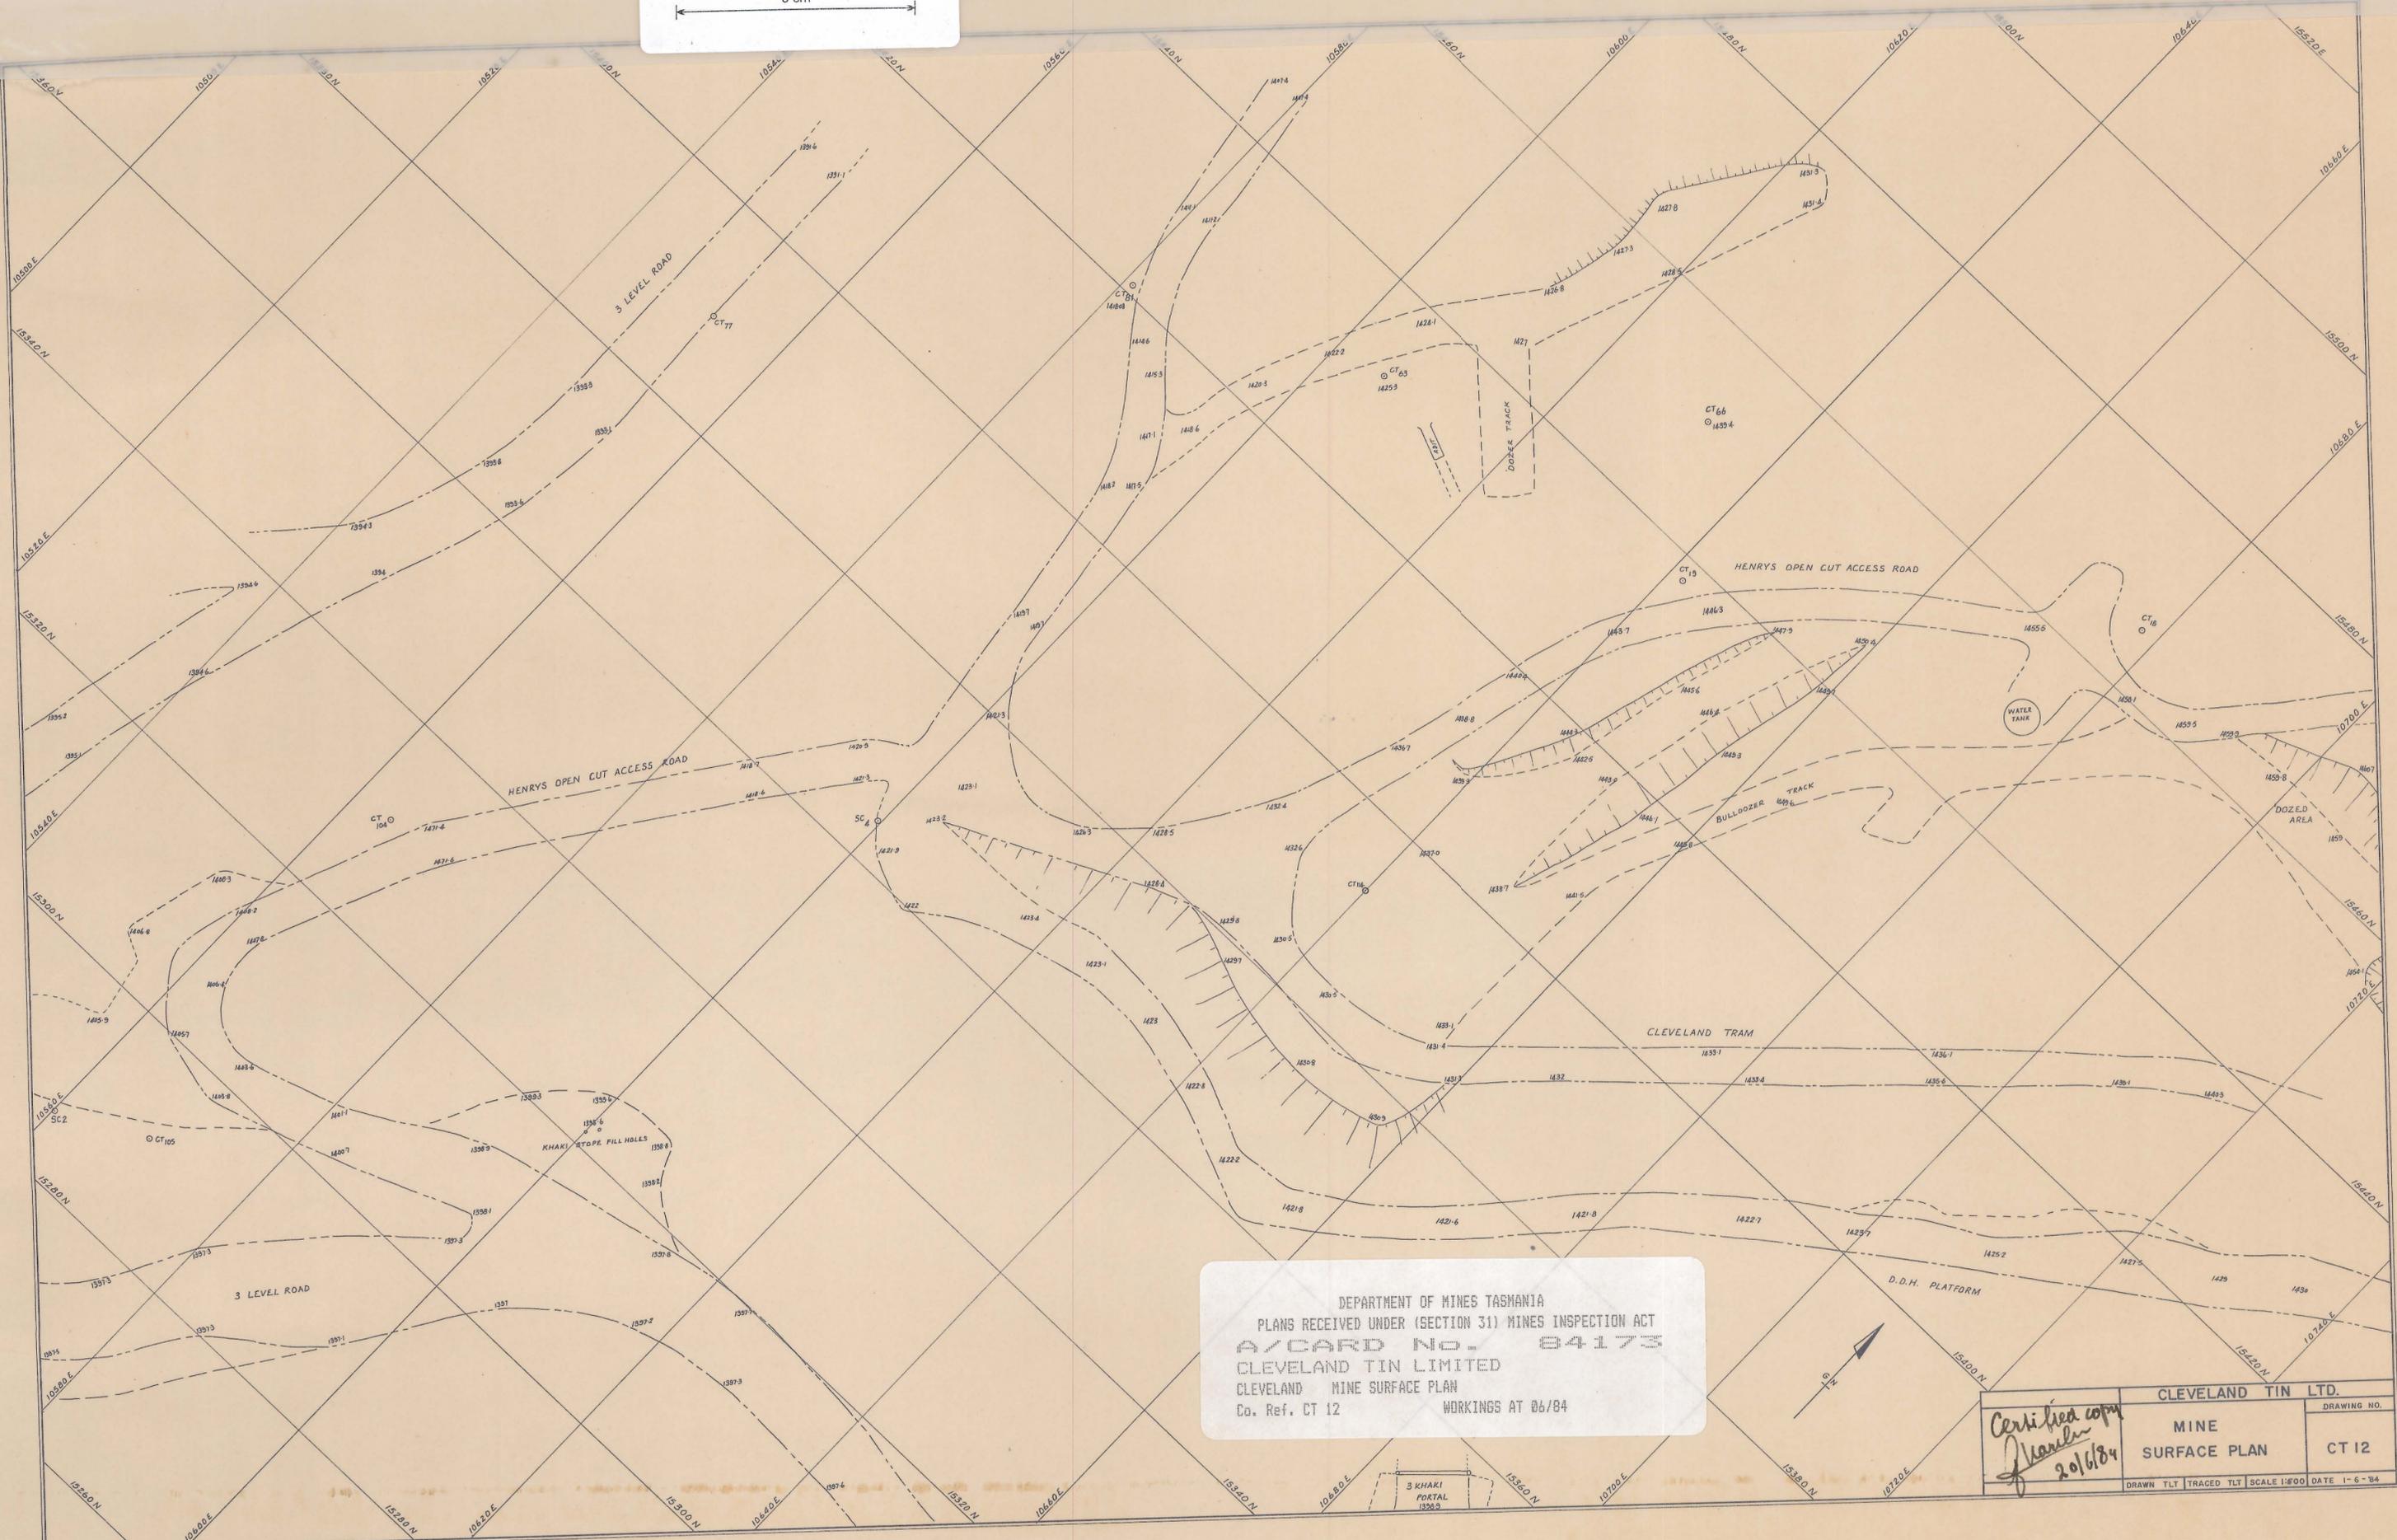

DEPARTMENT OF MINES TASMANIA
PLANS RECEIVED UNDER (SECTION 31) MINES INSPECTION ACT
A/CARD No. 84173
CLEVELAND TIN LIMITED
CLEVELAND MINE SURFACE PLAN
Co. Ref. CT 12 WORKINGS AT 06/84

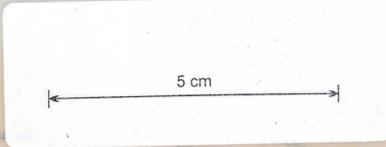

Certified copy
Handwritten signature
20/6/84

CLEVELAND TIN LTD.	
MINE SURFACE PLAN	CT 12
DRAWN TLT TRACED TLT SCALE 1:400 DATE 1-6-84	