
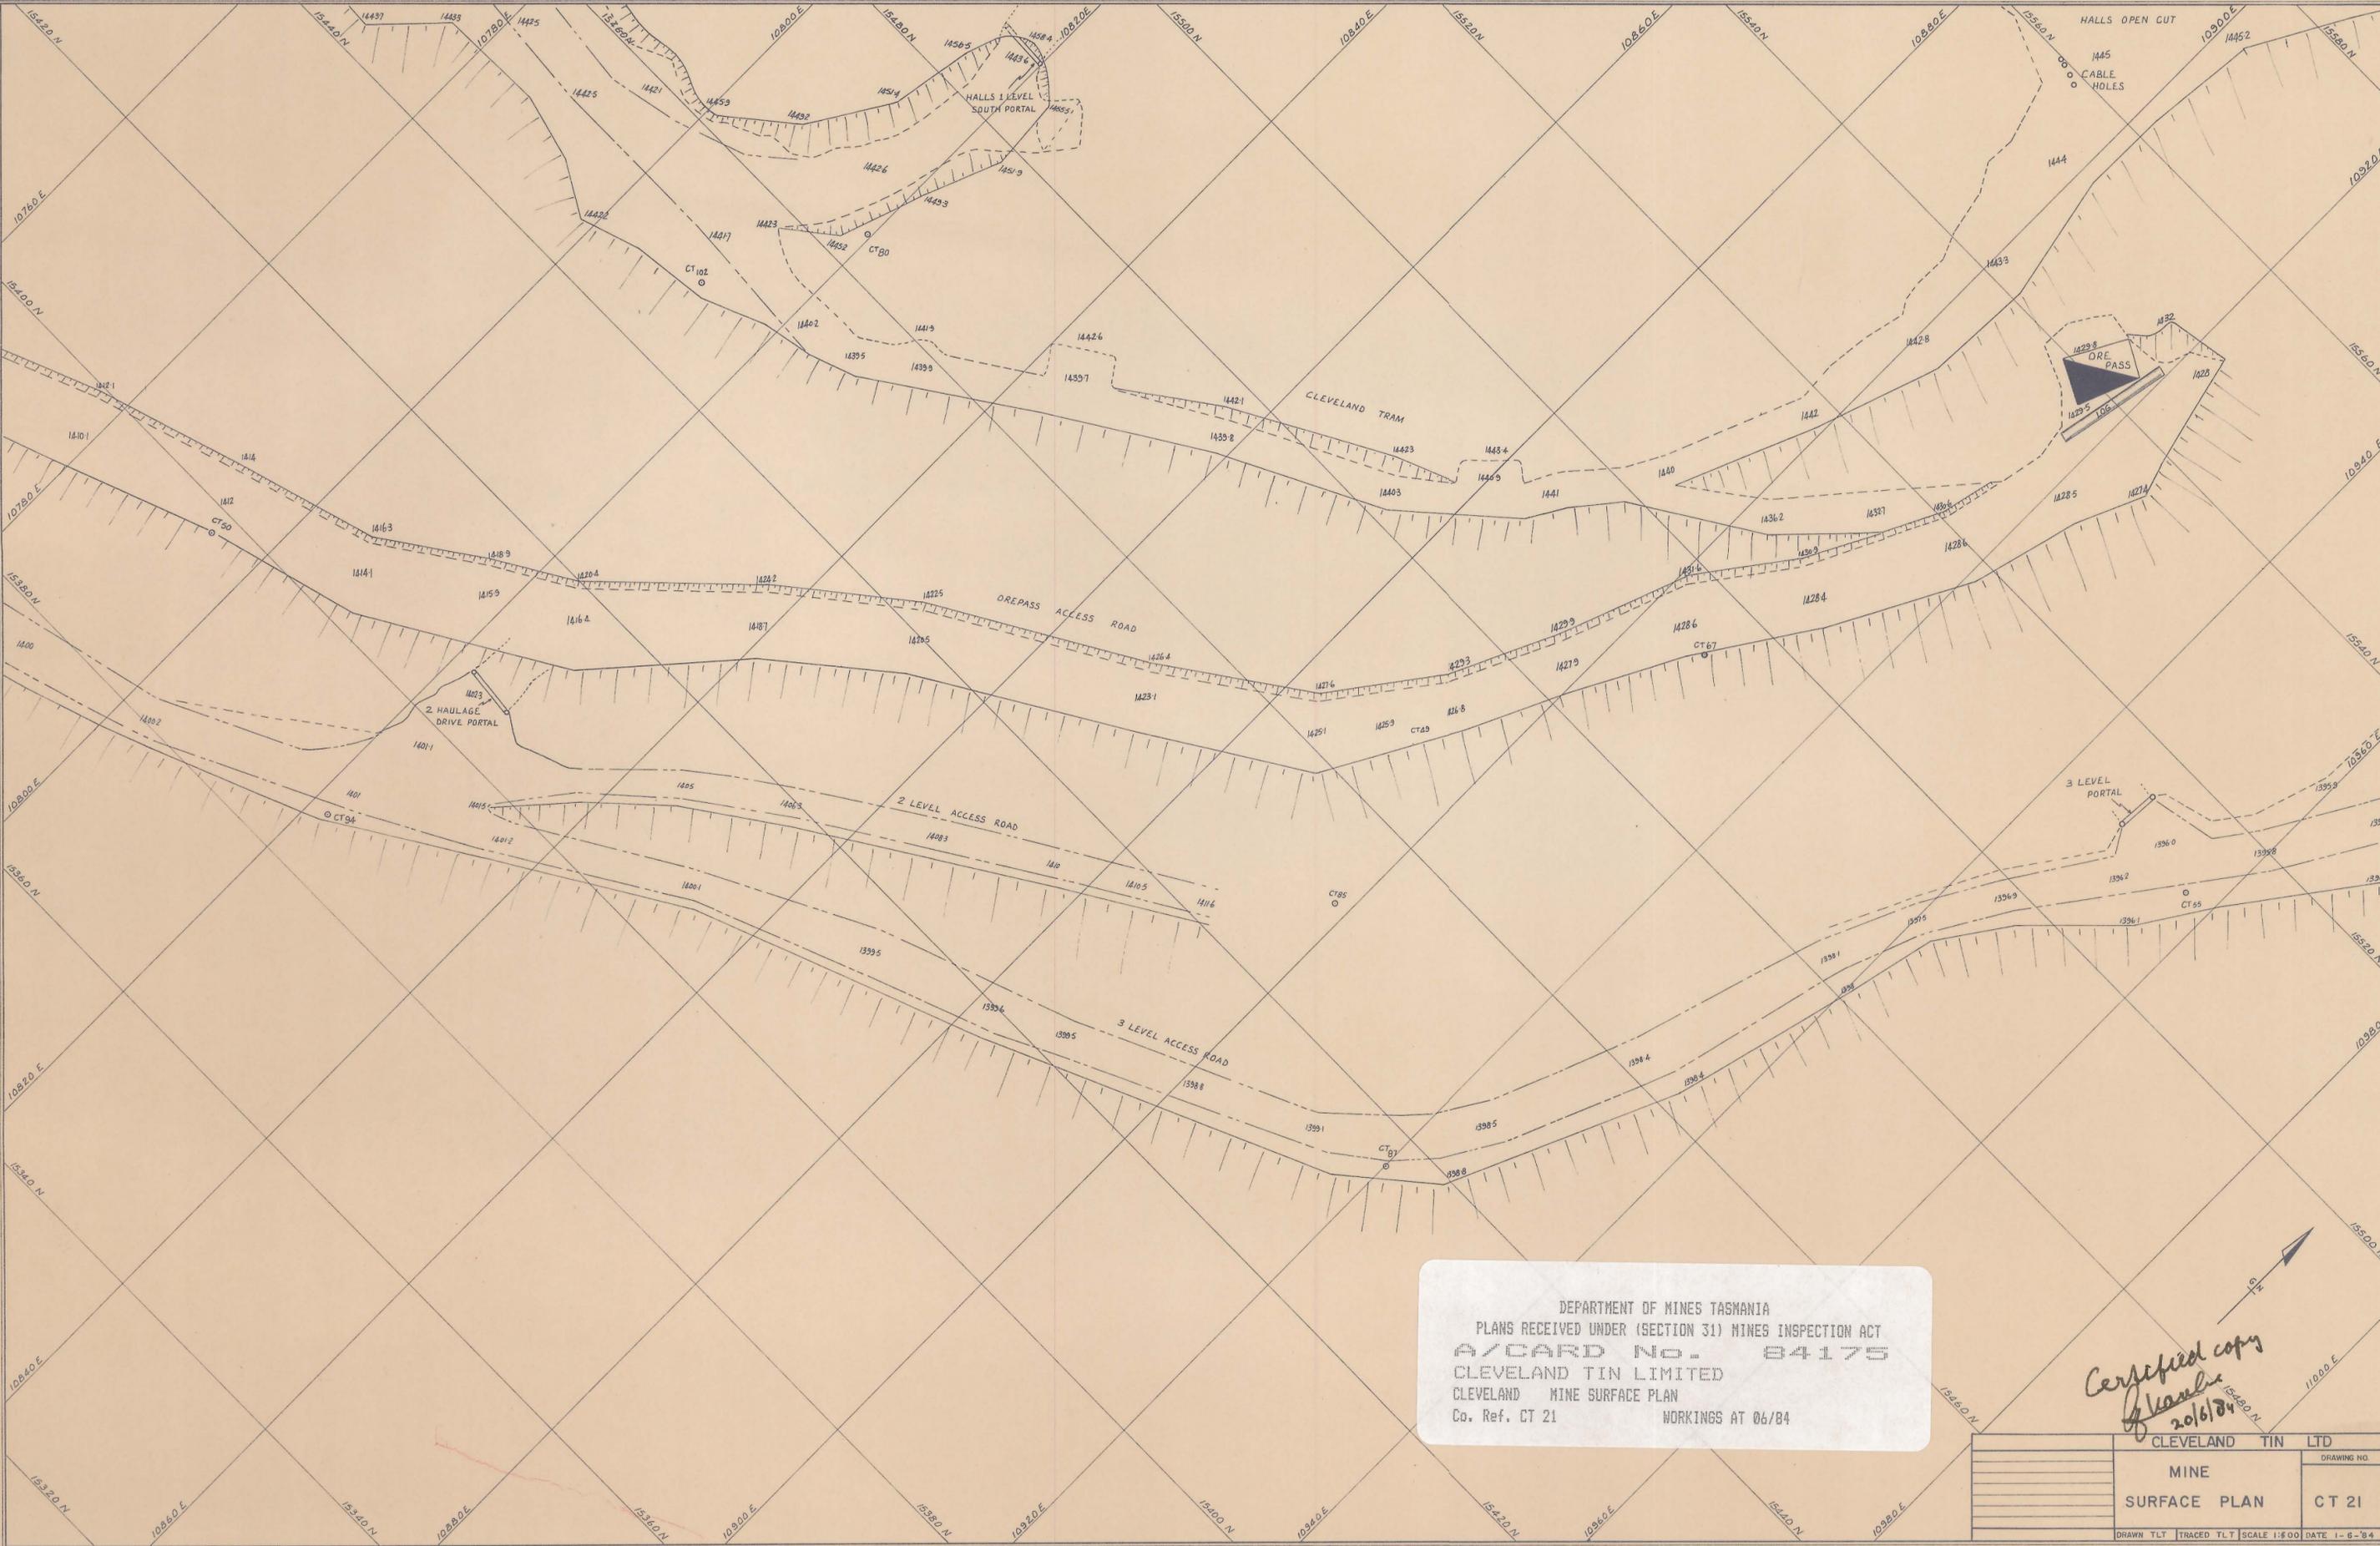


0216-859

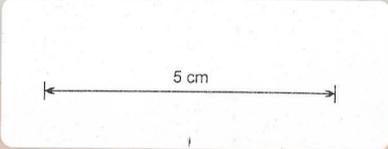

DEPARTMENT OF MINES TASMANIA
PLANS RECEIVED UNDER (SECTION 31) MINES INSPECTION ACT
A/CARD No. 84175
CLEVELAND TIN LIMITED
CLEVELAND MINE SURFACE PLAN
Co. Ref. CT 21 WORKINGS AT 06/84

*Certified copy
of plan
20/6/84*

CLEVELAND TIN LTD	
MINE	DRAWING NO.
SURFACE PLAN	CT 21
DRAWN TLT TRACED TLT SCALE 1:600 DATE 1-6-'84	